
Bratcher 2nd Addn

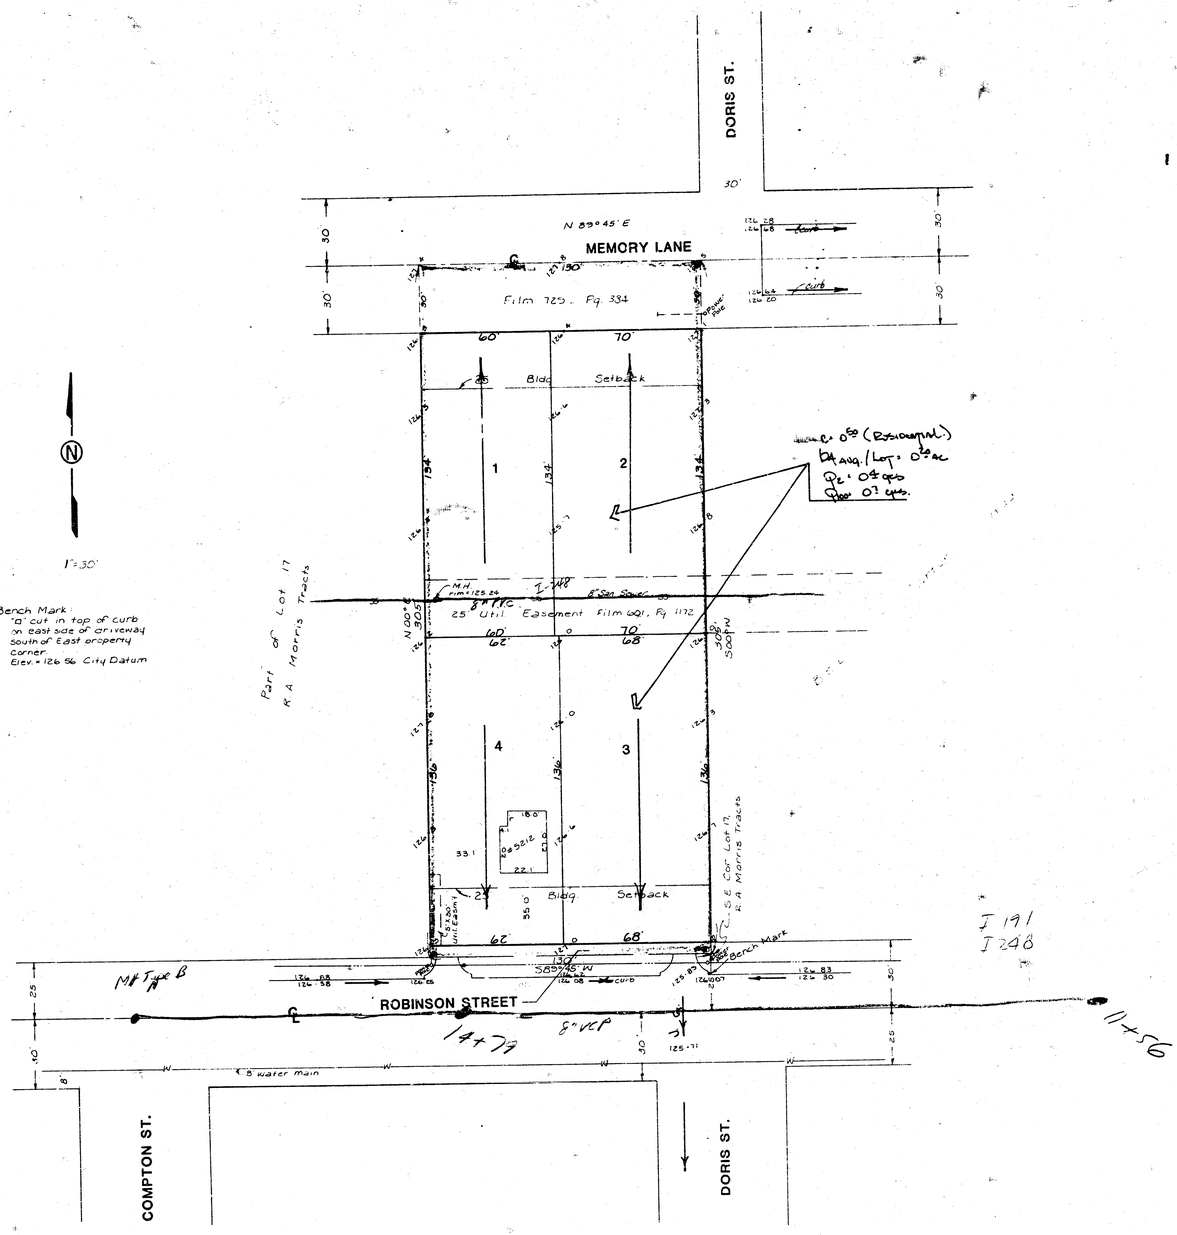

SKETCH PLAT

BRATCHER 2ND ADDITION

LOT 17, EXCEPT THE WEST 510 FEET THEREOF, R. A. MORRIS TRACTS, SEDGWICK COUNTY, KANSAS

OWNER: MICHAEL D. BRATCHER

DRAINAGE PLAN

BAUGHMAN COMPANY, P.A.
SURVEYING & ENGINEERING
316/262-7271 • 315 ELLIS • WICHITA, KANSAS 67211