

PRELIMINARY PLAT
BRITTAIN INDUSTRIAL PARK
WICHITA, SEDGWICK COUNTY, KANSAS

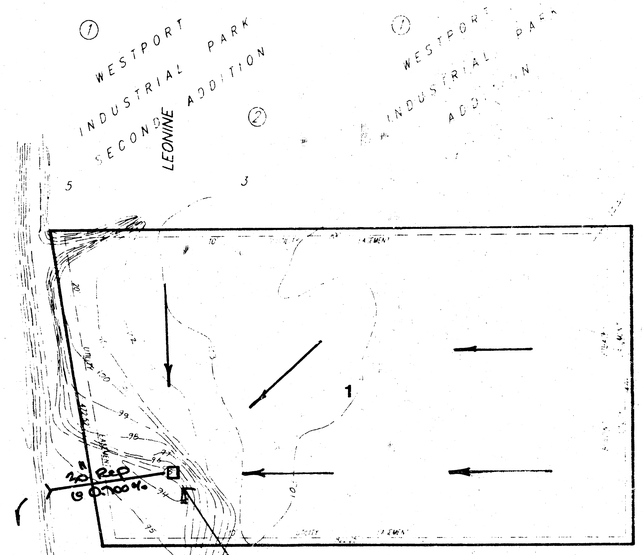

Scale: 1" = 100'
Contours at 1' interval

Owner: Dewey Brittain
2520 S. Sheridan
P.O. Box 17217
Wichita, Kansas 67217
(913) 447-6123

LEGAL DESCRIPTION:
A replat of Lots 1, 2, 3, 4, 5, and 6, Westport Industrial Park Sixth Addition, Wichita, Sedgwick County, Kansas.

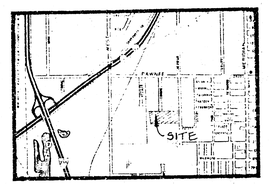

Vicinity Map

DRAINAGE PLAN

May 6, 1993

DAUGHMAN COMPANY P. A.