
DRAINAGE & UTILITY PLAN

BROCK ADDITION

AN ADDITION TO WICHITA, SEDGWICK COUNTY, KANSAS


Tie to SWS via private storm sewer ext

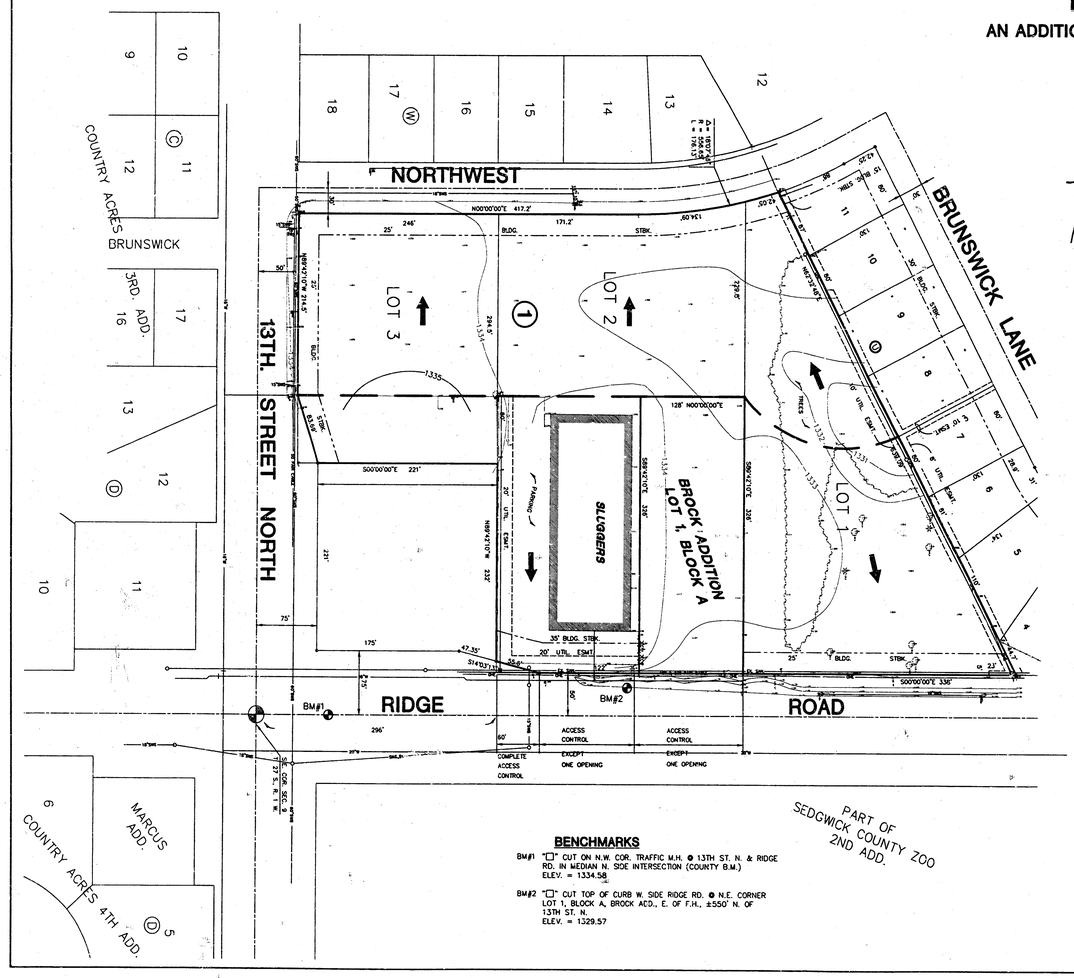

BENCHMARKS

BM#1 "□" CUT ON N.W. COR. TRAFFIC M.H. @ 13TH. ST. N. & RIDGE RD. IN MEDIAN N. SIDE INTERSECTION (COUNTY B.M.)
ELEV. = 1334.58

BM#2 "□" CUT TOP OF CURB W. SIDE RIDGE RD. @ N.E. CORNER LOT 1, BLOCK A, BROCK ADD., E. OF F.H., ±550' N. OF 13TH ST. N.
ELEV. = 1329.57

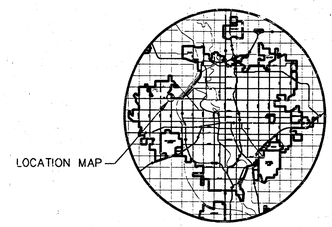

N

SCALE: 1" = 40'
Date: 6/6/96
Survey
MKEC 9/4/96

MID-KANSAS ENGINEERING CONSULTANTS, INC.
411 N. WEBB ROAD
WICHITA, KS. 67206
316-684-9600

BROCK SECOND ADDITION
PROJECT NAME

DRAINAGE & UTILITY PLAN
SHEET TITLE

G.J.A.	B.D.M.	G.J.A.
DESIGN BY:	DRAWN BY:	CHECKED BY:
OCT. 1996	DRNGPLAN	1 / 1
DATE	JOB NO.	SHEET/OF