
JEFF BRUCE ADDITION
(Drainage)

Elevations
Reduced by
MKH 8-9-85
8-13-85

"JEFF BRUCE ADDITION"
(NE1/4 Sec. 16, T27S, R1E)

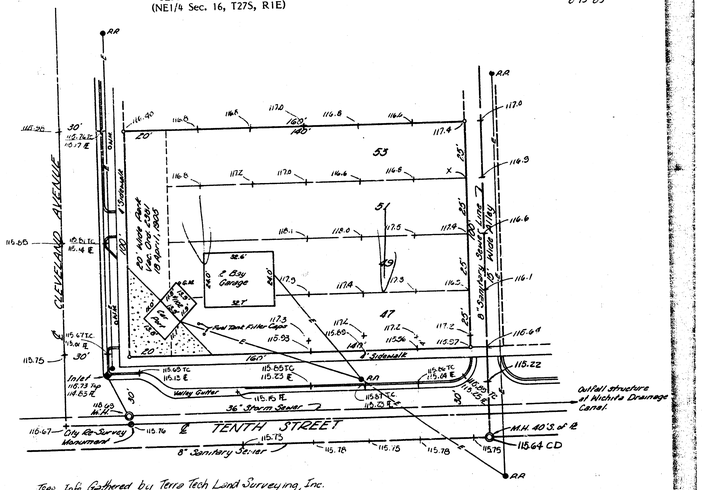


Topo Info Gathered by Terra Tech Land Surveying, Inc.
8-9-85 & 8-13-85

VICINITY MAP OF:

"JEFF BRUCE ADDITION"

WICHITA, SEDGWICK COUNTY, KANSAS
(NE 1/4 SEC. 16, T27S, R1E)
ASSOCIATED ZONING CASE Z-2658

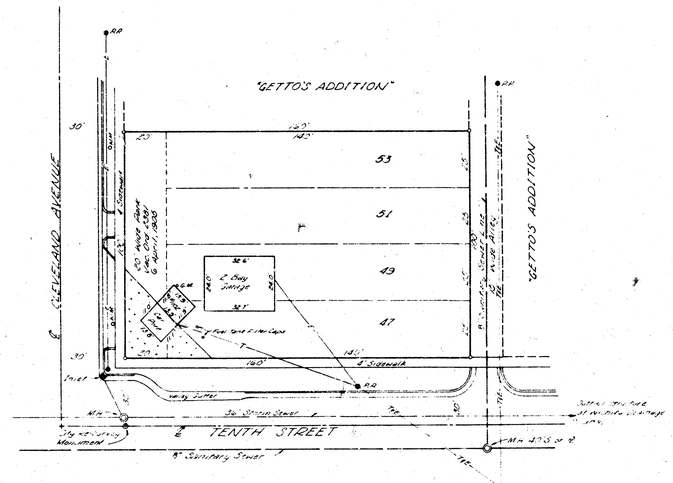

SCALE : 1"=30'

0 25 50 100

OWNER/SUBDIVIDER:

JEFF BRUCE
1102 CLEVELAND
WICHITA, KANSAS 67214
TELE. 264-9698

LEGAL DESCRIPTION:

LOTS 47, 49, 51, 53 AND THE VACATED 20' WIDE PARK ADJOINING ON THE WEST, ON CLEVELAND AVENUE, IN "GETTO'S ADDITION" TO THE CITY OF WICHITA, KANSAS.

TERRA TECH LAND SURVEYING INC.

245 West Dewey
Wichita, Kansas 67202-3607
(316) 267-0744 / 267-2348

PRELIMINARY
FOR INFORMATION ONLY

SWPO AUG 13 1985

FILMED FROM THE BEST AVAILABLE COPY