

MEMO

TO: City of Wichita PROJECT NO. 36-85396-1934
 455 North Main PROJECT: Carriage Park
 Wichita, Kansas 67202 Cave Center Addition
 ATTN: Vicki Huang DATE: 11-13-85
 FROM: Louise Olivarez - MAP Charles S. Brown, P.E.
 REFERENCE: Revised Drainage Plan

PLEASE ADVISE IMMEDIATELY OF ANY MISCONCEPTIONS OR OMISSIONS YOU BELIEVE TO BE CONTAINED HEREIN.

Transmitted herewith are two (2) copies of the Revised Drainage Plan and Supporting Calculations for the proposed Carriage Park Care Center Addition to Wichita.

This plan has been revised to include flume sizing at the southeast corner of the plat.





Date 11-13-85 Page 2 of 2
 Project Carriage Park Care Center
 Item Drainage

Flume Section:

W	d	A	P	R	R ^{2/3}	AR ^{2/3}
30'	0.5'	15.0	31'	0.48	0.62	9.25
25'	0.5'	12.5	26'	0.48	0.61	7.67
20'	0.5'	10.0	21'	0.48	0.61	6.10
15'	0.5'	7.5	16'	0.47	0.60	4.52
10'	0.5'	5.0	11'	0.45	0.59	2.96
5'	0.5'	2.5	6'	0.42	0.56	1.39

SUMMARY:
 5' wide x 6" deep @ 4.71% will handle 280 cfs (greater than 5-yr. storm.)

Scale: 1" = 60'
 Date of Topo 8-28-85
 B.M. - Brass rod in concrete post,
 38' north and 3.4' west of north property
 line of Central and west property line of
 Edgemoor. Elev. 185.657

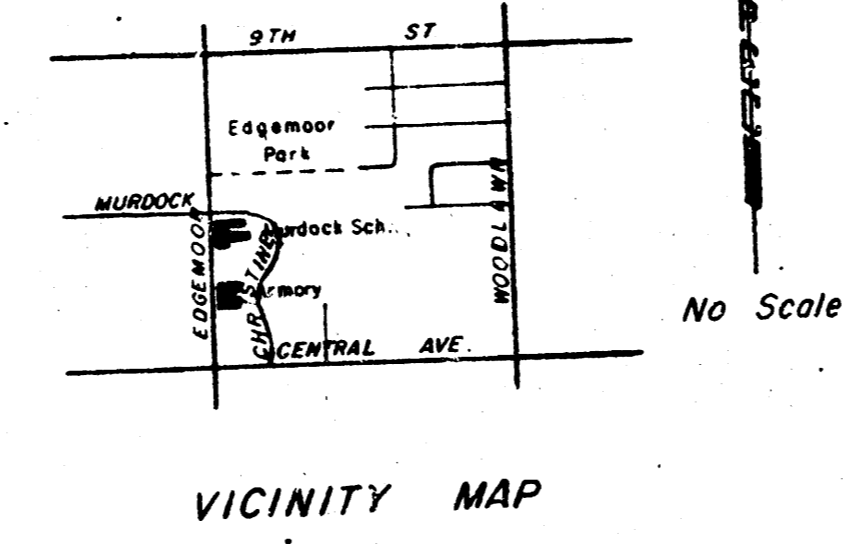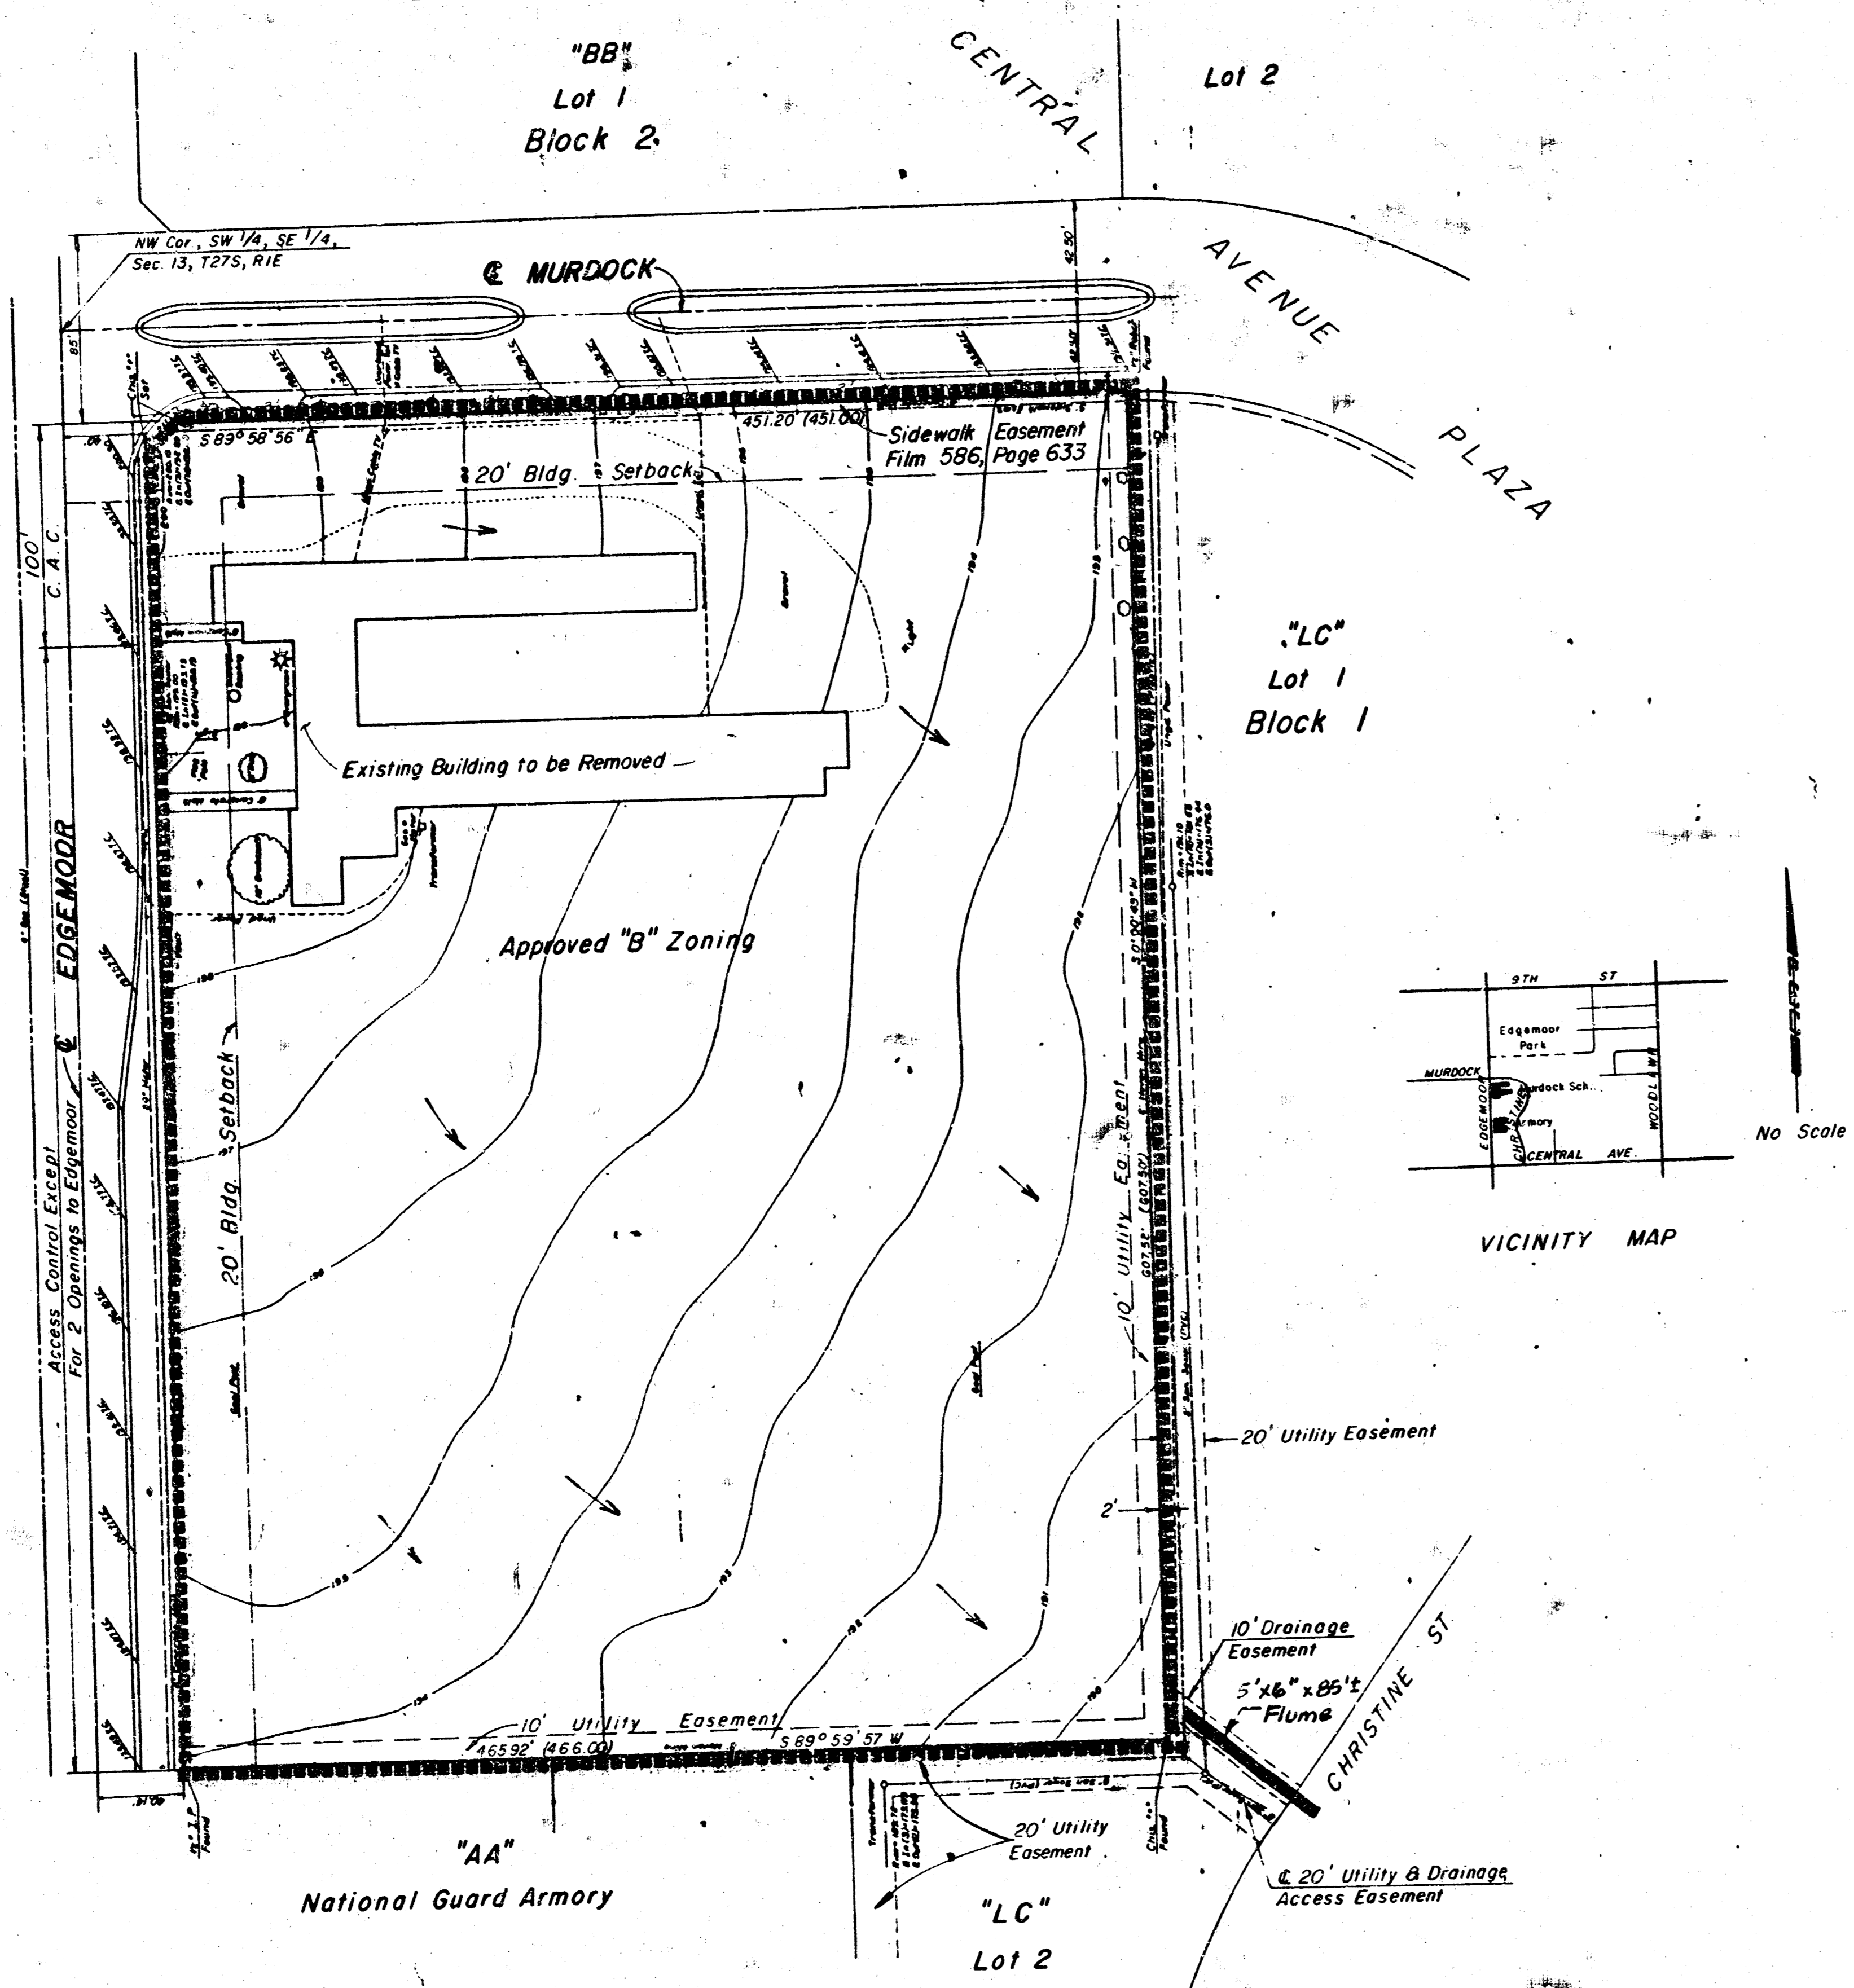


**DRAINAGE PLAN OF
 CARRIAGE PARK CARE CENTER**

Owner: U.S.D. 259
 Attn. Dr. Richard L. Holstead
 Engineer: P.E.C. p.o.
 1440 English, Wichita, Ks. 67211

Note: The 5' x 6" x 85" Flume shown is based on Q_s & based on draining 100% of the proposed plat. Upon completion of the Site Development & Site Grading Plans for the proposed improvements, the hydrology & hydraulics of the flume shall be revised as necessary.

10-1-85
 Revised 11-13-85

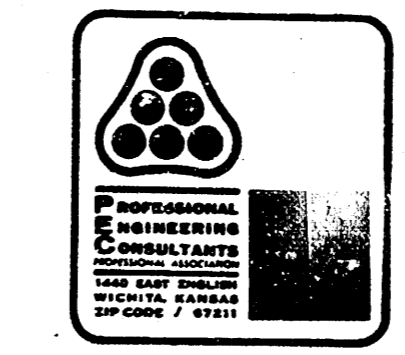

Date 11-13-85 Page 1 of 2
 Project Carriage Park Care Center
 Item Drainage

I Determine 5-yr. Runoff From Entire Site

- D.A. = 466' x 607.5' = 283,095'² = 6.5 Ac.
- C = 0.7
- t_c = 15 min ∴ I_s = 5.21

$$Q_s = C I_s A$$

$$= 0.7 \times 5.21 \times 6.5$$

$$= 23.7 \text{ cfs}$$

II Determine Flume Size to Handle Q_s

Use Mannings Eq'n 1

$$Q = \frac{1.486}{n} AR^{2/3} s^{1/2}$$

where n = 0.016 (conc.)
 s = 4.71%
 Req'd AR^{2/3} = .18

FILMED FROM THE BEST AVAILABLE COPY.....