
CEDAR CLIFF ADDITION
(DRAINAGE)

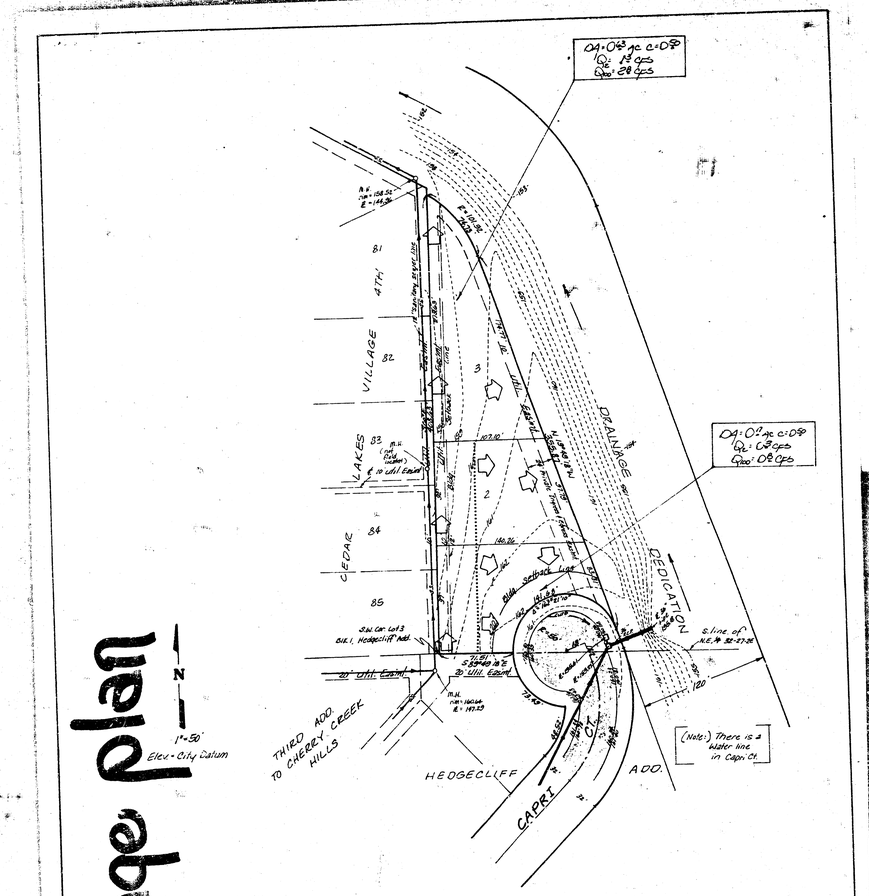


SKETCH PLAT
CEDAR CLIFF ADDITION
BEING A REPLAT OF LOTS 3 AND 4,
BLOCK 1, HEDGECLIFF ADDITION,
WICHITA, KANSAS

OWNER: MICHAEL D. HUFF

BAUGHMAN COMPANY, P.A.
SURVEYING & ENGINEERING
316/262-7271 • 330 LAURA • WICHITA, KANSAS 67211

5-27-83

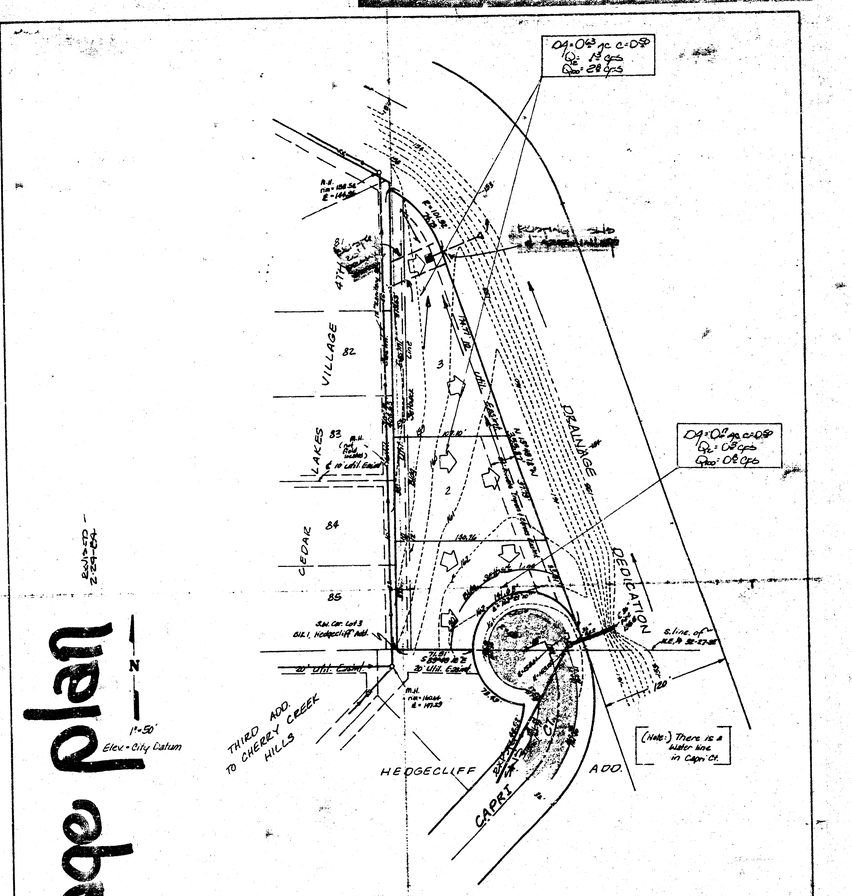

SKETCH PLAT
CEDAR CLIFF ADDITION
BEING A REPLAT OF LOTS 3 AND 4,
BLOCK 1, HEDGECLIFF ADDITION,
WICHITA, KANSAS

OWNER: MICHAEL D. HUFF

BAUGHMAN COMPANY, P.A.
SURVEYING & ENGINEERING

5-27-83

BAUGHMAN COMPANY, P.A.
SURVEYING & ENGINEERING
316/262-7271 • 330 LAURA • WICHITA, KANSAS 67211

THRMA MEMO

PROJECT Cedar Cliff Addition
JOB NO.
DATE May 27, 1983
COPIES TO:
TO Chris Breitenstein
FROM B. Wooten
REFERENCE Drainage Plan

Final Plat is schedules for Subdivision for June 9, 1983.

Lots will be duplex lots. C = 0.50. Lot 1 will drain mostly to Capri Ct. which is discharged by an existing storm sewer as indicated. Lots 2 and 3 will drain to the drainage ditch as indicated to either the east or north.

PAGE __ OF ____