


SKETCH PLAT DANKA ADDITION

WICHITA, SEDGWICK COUNTY, KANSAS

NORTHEAST EXPRESSWAY RIGHT-OF-WAY
(FILM 511, PAGE 732)

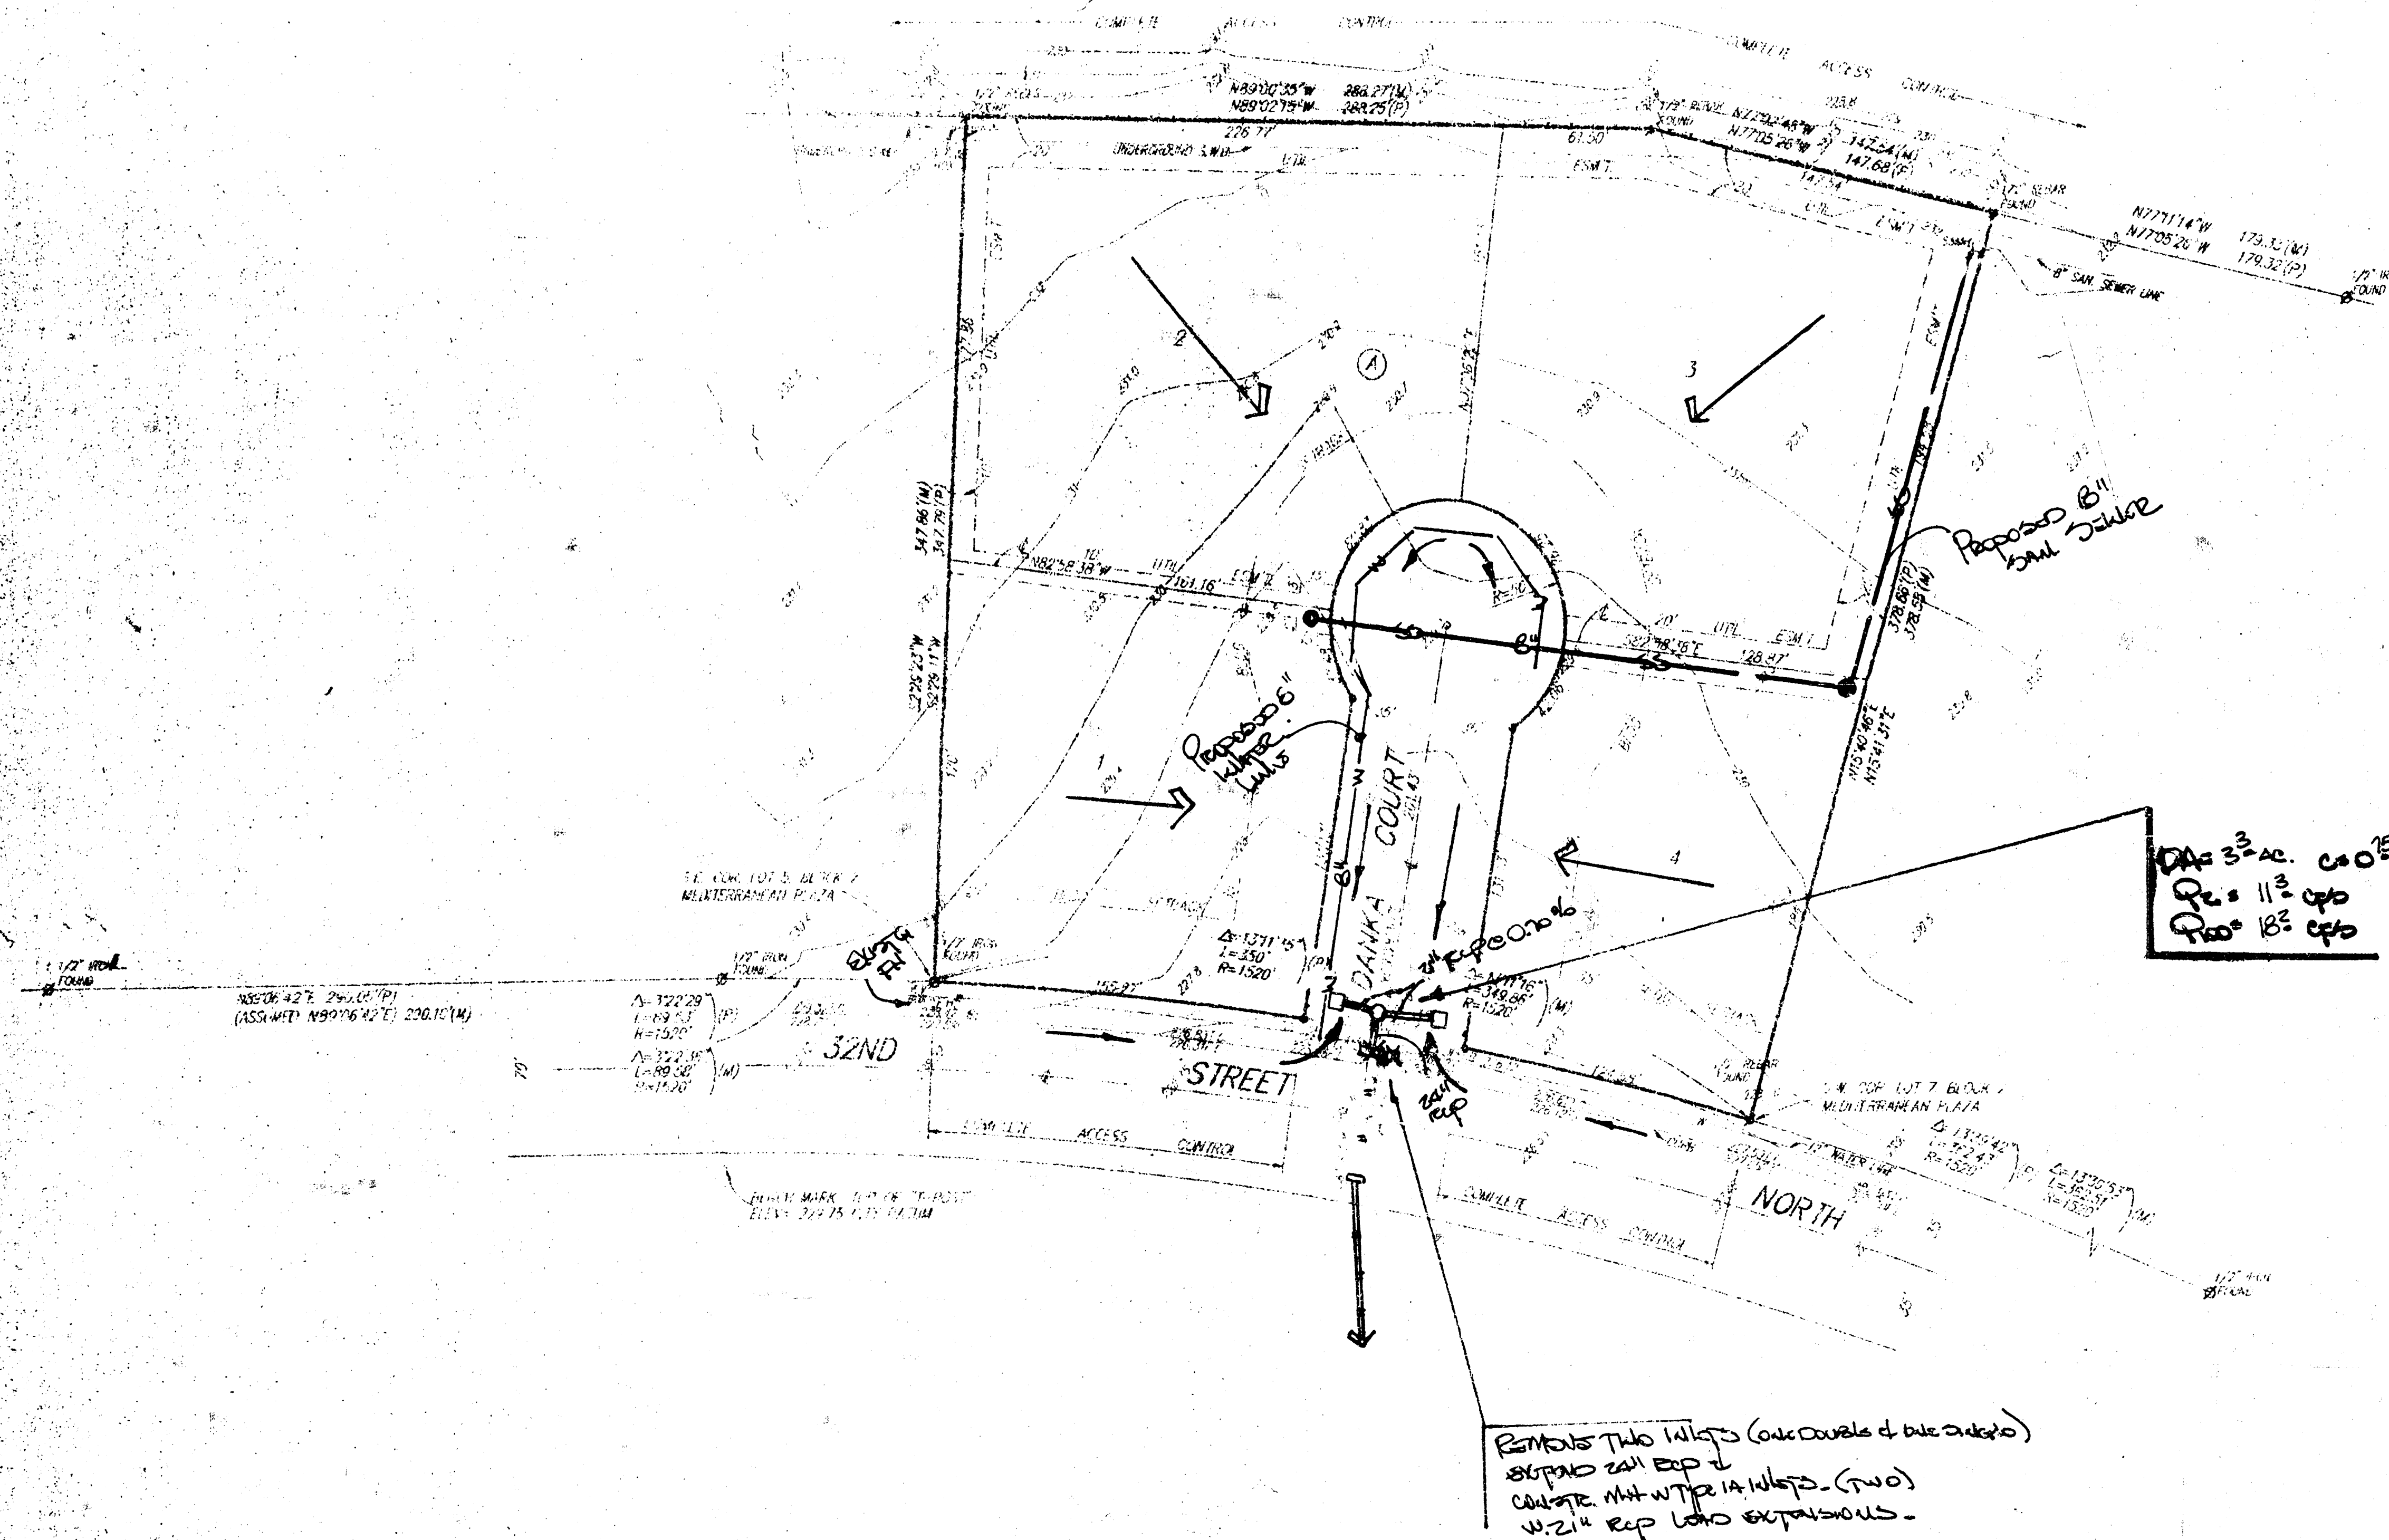

FOUND CORNERS ARE UNDESIGNED
ORIGIN UNLESS IDENTIFIED ON SKETCH

(P) = PLATTED
(M) = MEASURED
BEARING BASE = ASSUMED


- = 1/2" REBAR W/ "RANGEMAN" CAP (P)
- = 1/2" IRON (FOUND)
- = 1/2" REBAR (FOUND)

OWNER:

LEGAL DESCRIPTION:



ELEV. = 2294.42 CITY DATUM

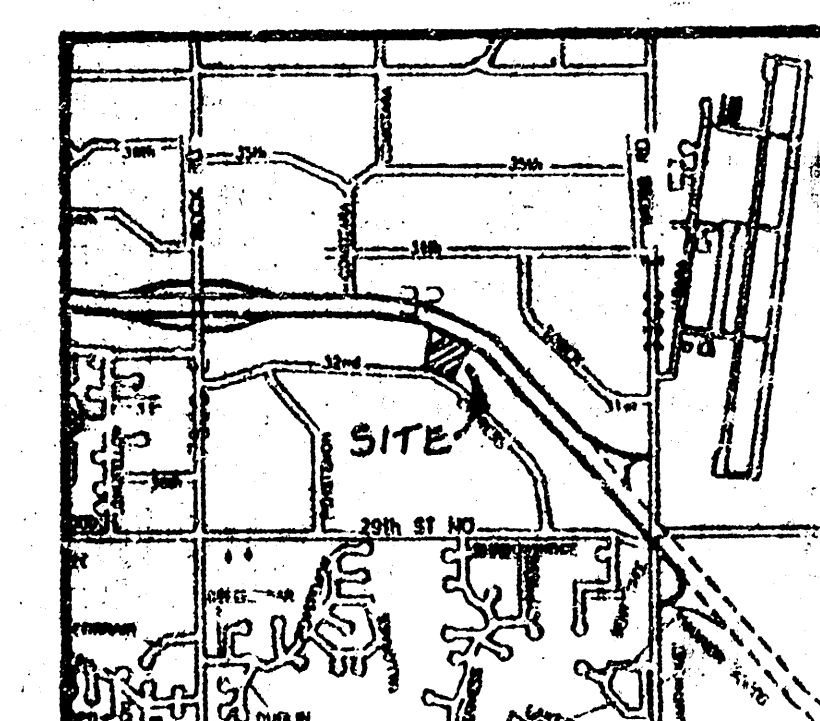

VICINITY MAP

DRAINAGE PLAN UTILITY PLAN

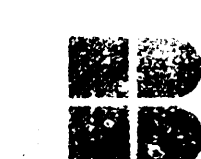

BAUGHMAN COMPANY, P. A.
SURVEYING & ENGINEERING
315/252-7271 • 315 ELLIS • WICHITA, KANSAS 67211

21 OCT 1993