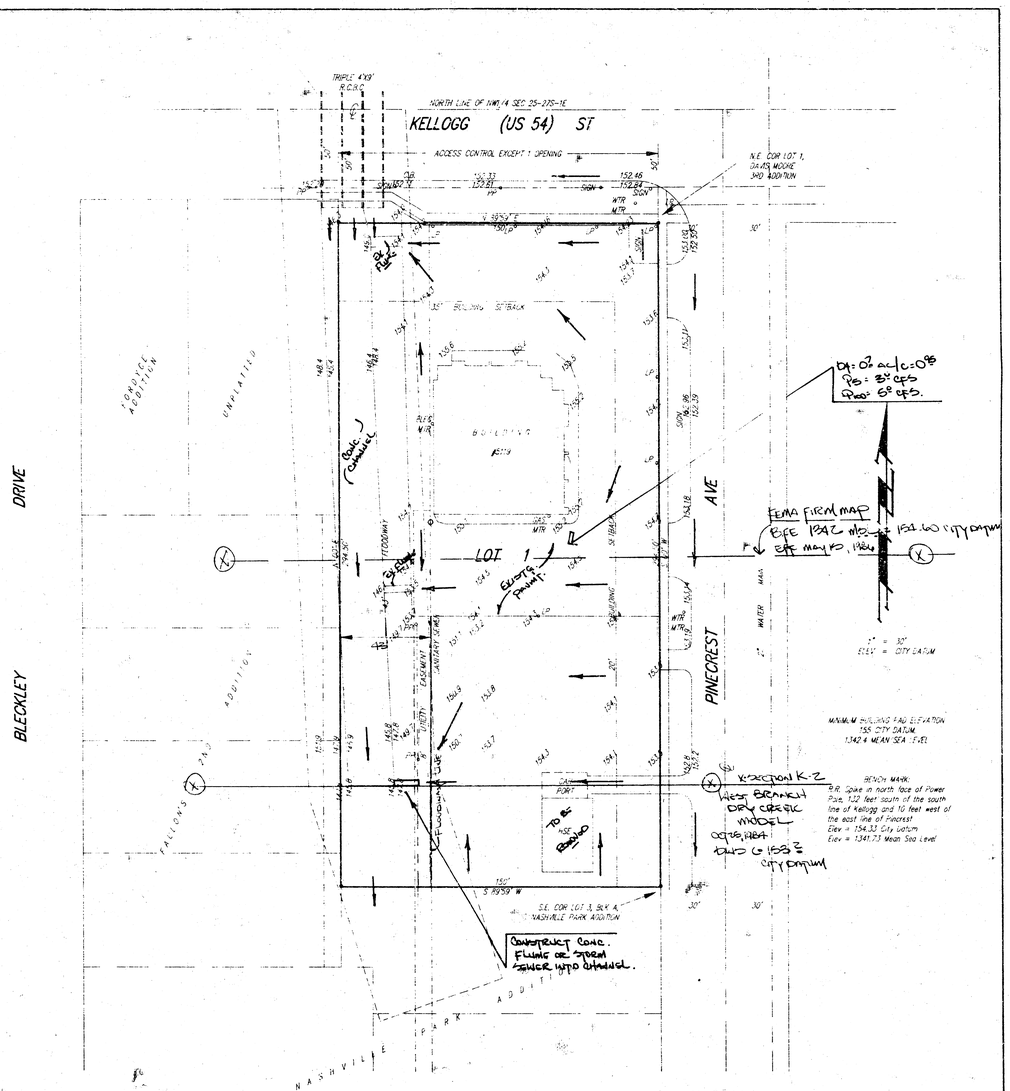


SKETCH PLAT

DAVIS-MOORE 10TH ADDITION

WICHITA, SEDGWICK COUNTY, KANSAS

LOT 1, DAVIS MOORE 3RD ADDITION, WICHITA, KANSAS AND THE SOUTH 6.5 FEET OF LOT 1 AND ALL OF LOTS 2 AND 3, BLOCK A, NASHVILLE PARK ADDITION TO THE CITY OF WICHITA, SEDGWICK COUNTY, KANSAS.

LAND PARTNERSHIP
% DEALERS LEASING
ATTN: DAVID J ANDERSON
5119 E. KELLOGG
WICHITA, KS 67218
PH: 683-6581

DRAINAGE PLAN

8/10/92

BAUGHMAN COMPANY P. A.
SURVEYING & ENGINEERING
316/262-7271 • 315 ELLIS • WICHITA, KANSAS 67211

JULY 2, 1992