

SKETCH PLAT

DEPARTMENT OF TRANSPORTATION 2ND ADDITION

LOT GRADING PLAN

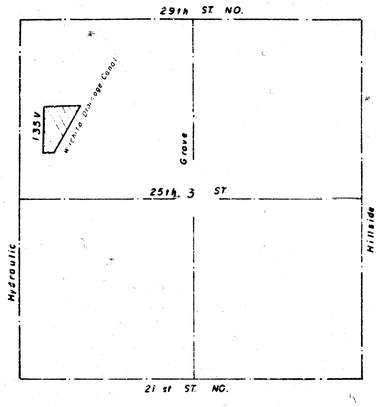

VICINITY MAP

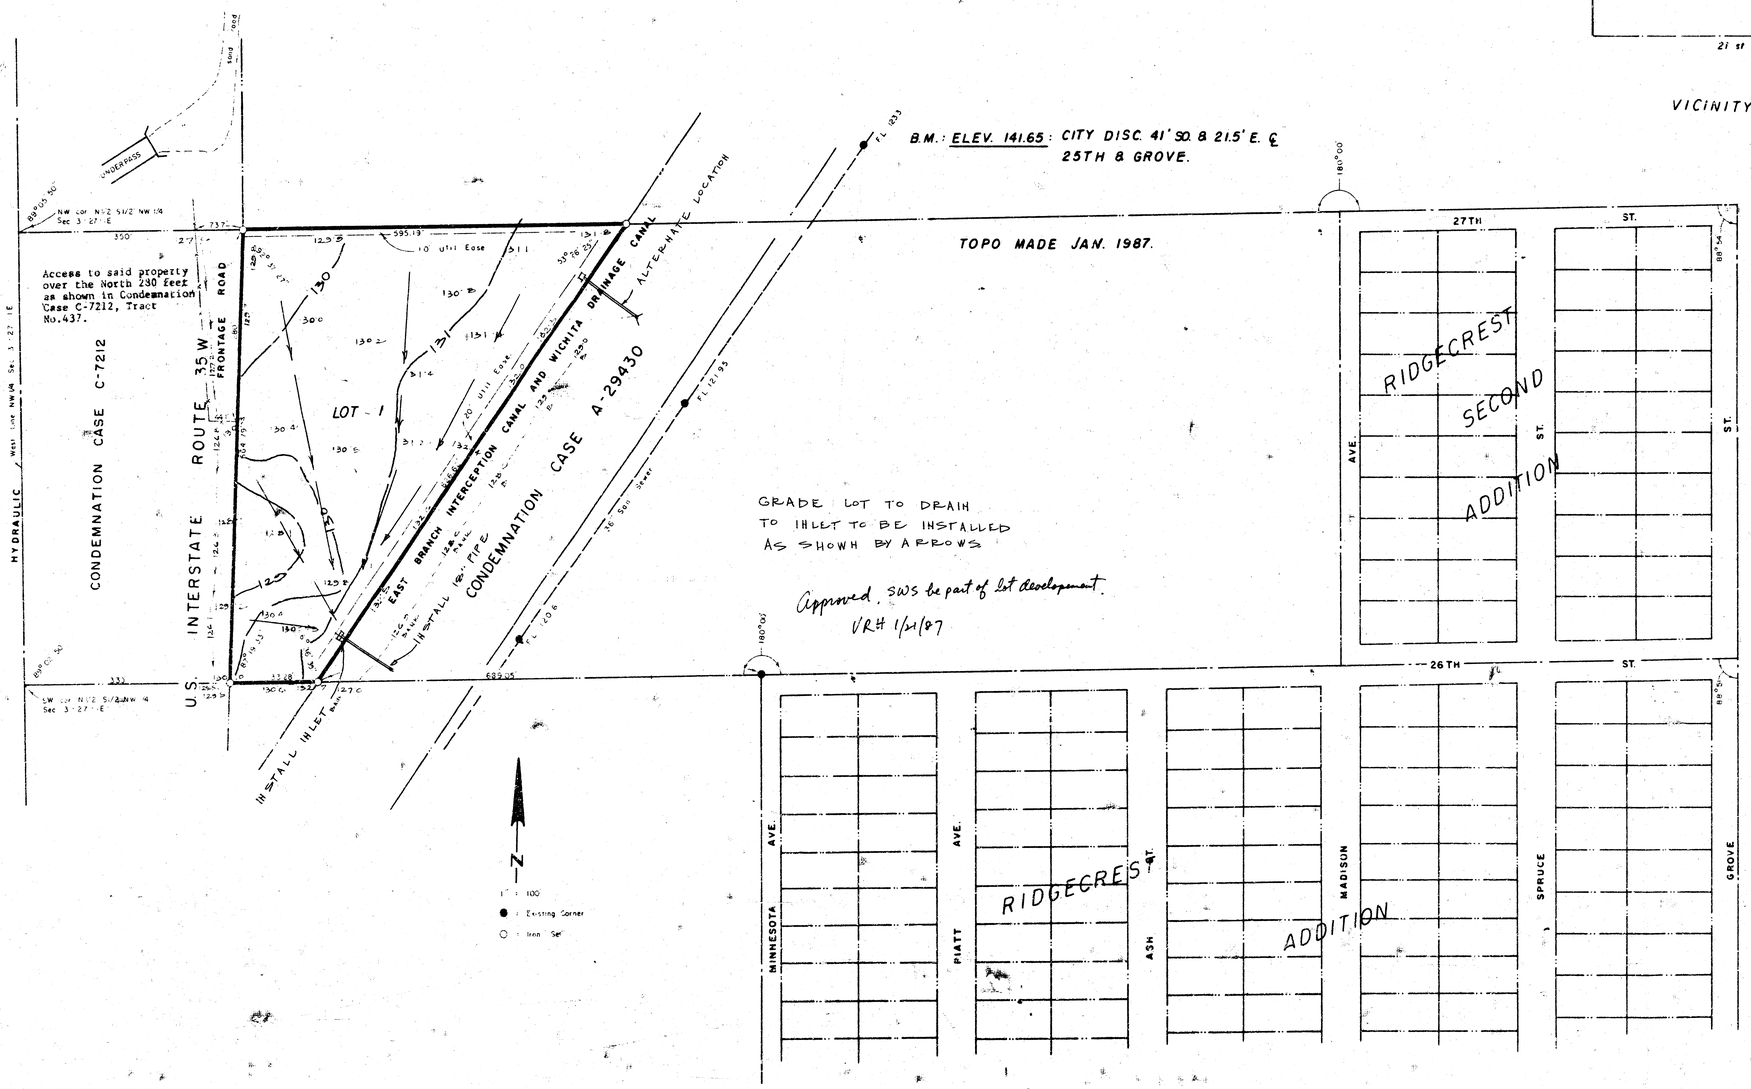

LOWELL D. HIGH
JAN. 16, 1987

FOR: CITY OF WICHITA