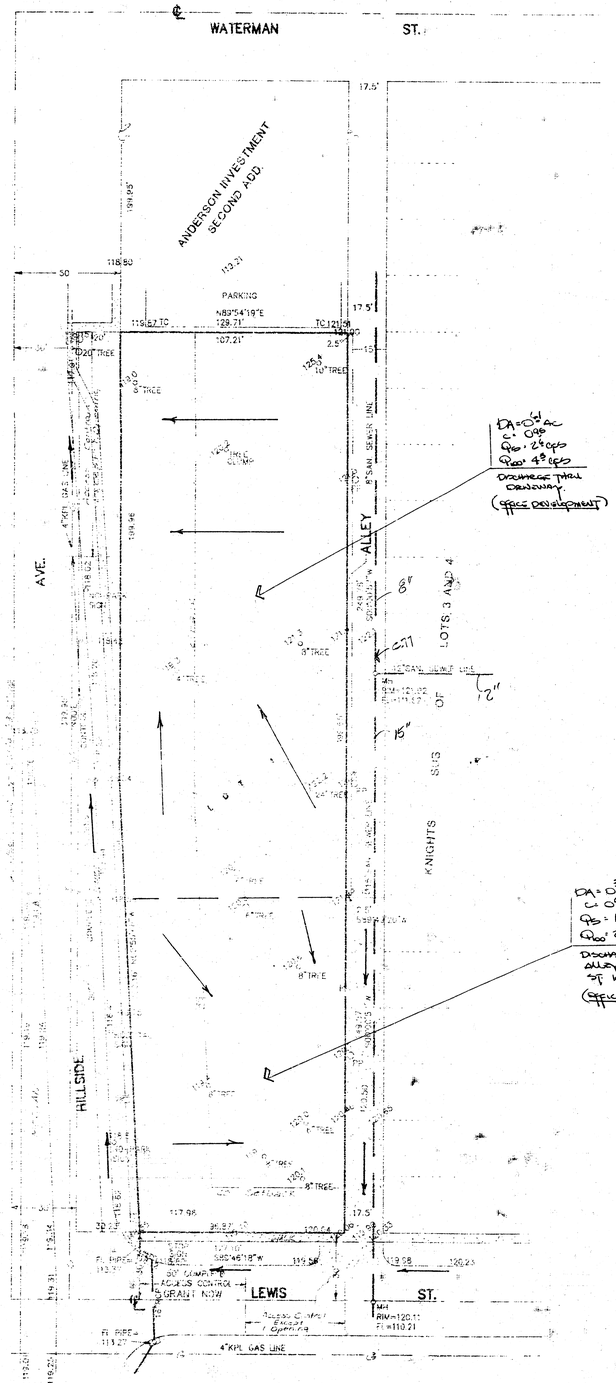


SKETCH PLAT

DEPARTMENT OF TRANSPORTATION 3RD ADDITION

REPLAT OF LOTS 17, 19, 21, AND 23, KNIGHTS SUB-DIVISION OF LOTS 3 AND 4, IN BLOCK 2, GRAND VIEW ADDITION TO WICHITA, KANSAS, TOGETHER WITH LOTS 1, 3, 5, 7, 9, AND 11, RAWLINS AND BROWN'S SUB-DIVISION OF LOTS 5 AND 6, IN BLOCK 1, GRAND VIEW ADDITION TO WICHITA, KANSAS, TOGETHER WITH LOT 1, HERMAN ADDITION, WICHITA, KANSAS

DRAINAGE PLAN

BAUGHMAN COMPANY, P.A.
PLANNING & ENGINEERING