
DRAINAGE PLAN
DOUBLE L ADDITION

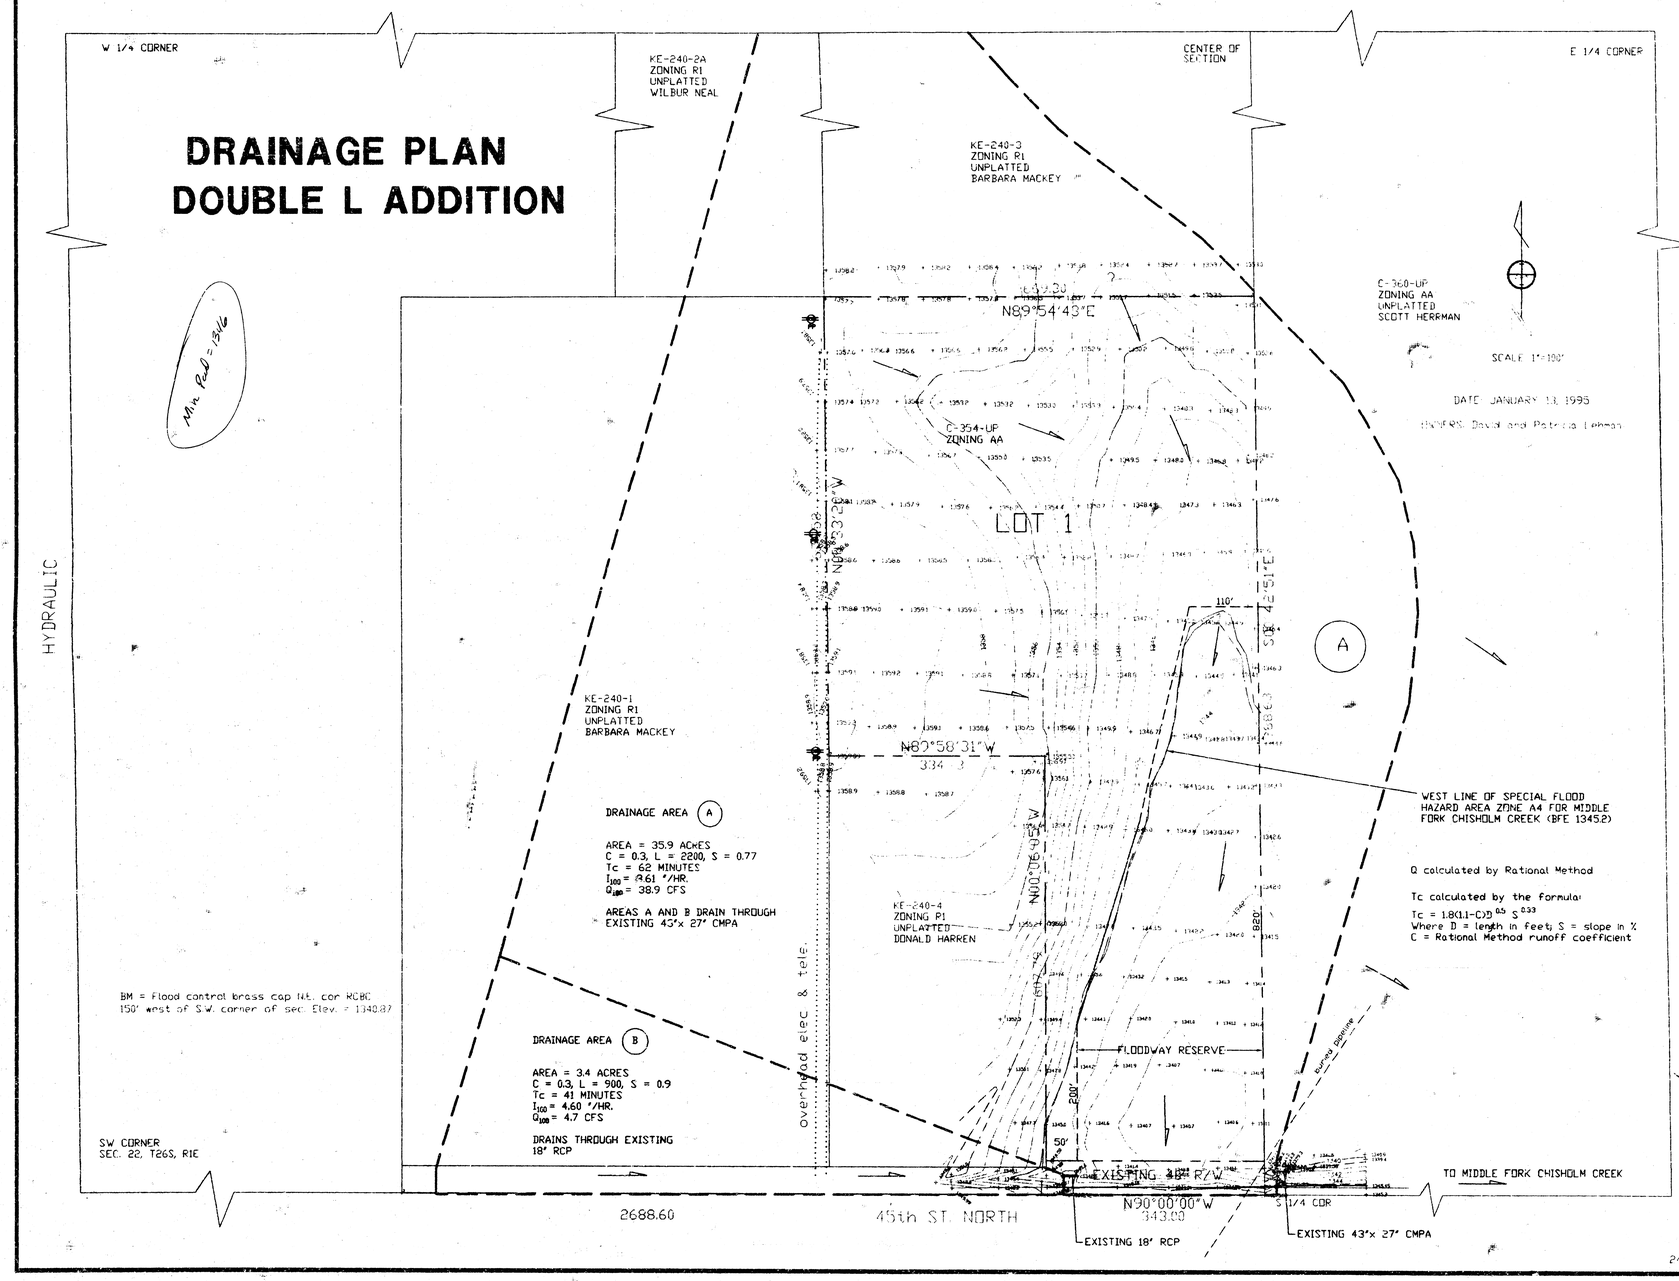

250 Matthewson
Wichita, KS 67211
(316) 263-0082

ARMSTRONG LAND SURVEY, P.A.

LICENSED LAND SURVEYOR
0821
1-30-95
KANSAS