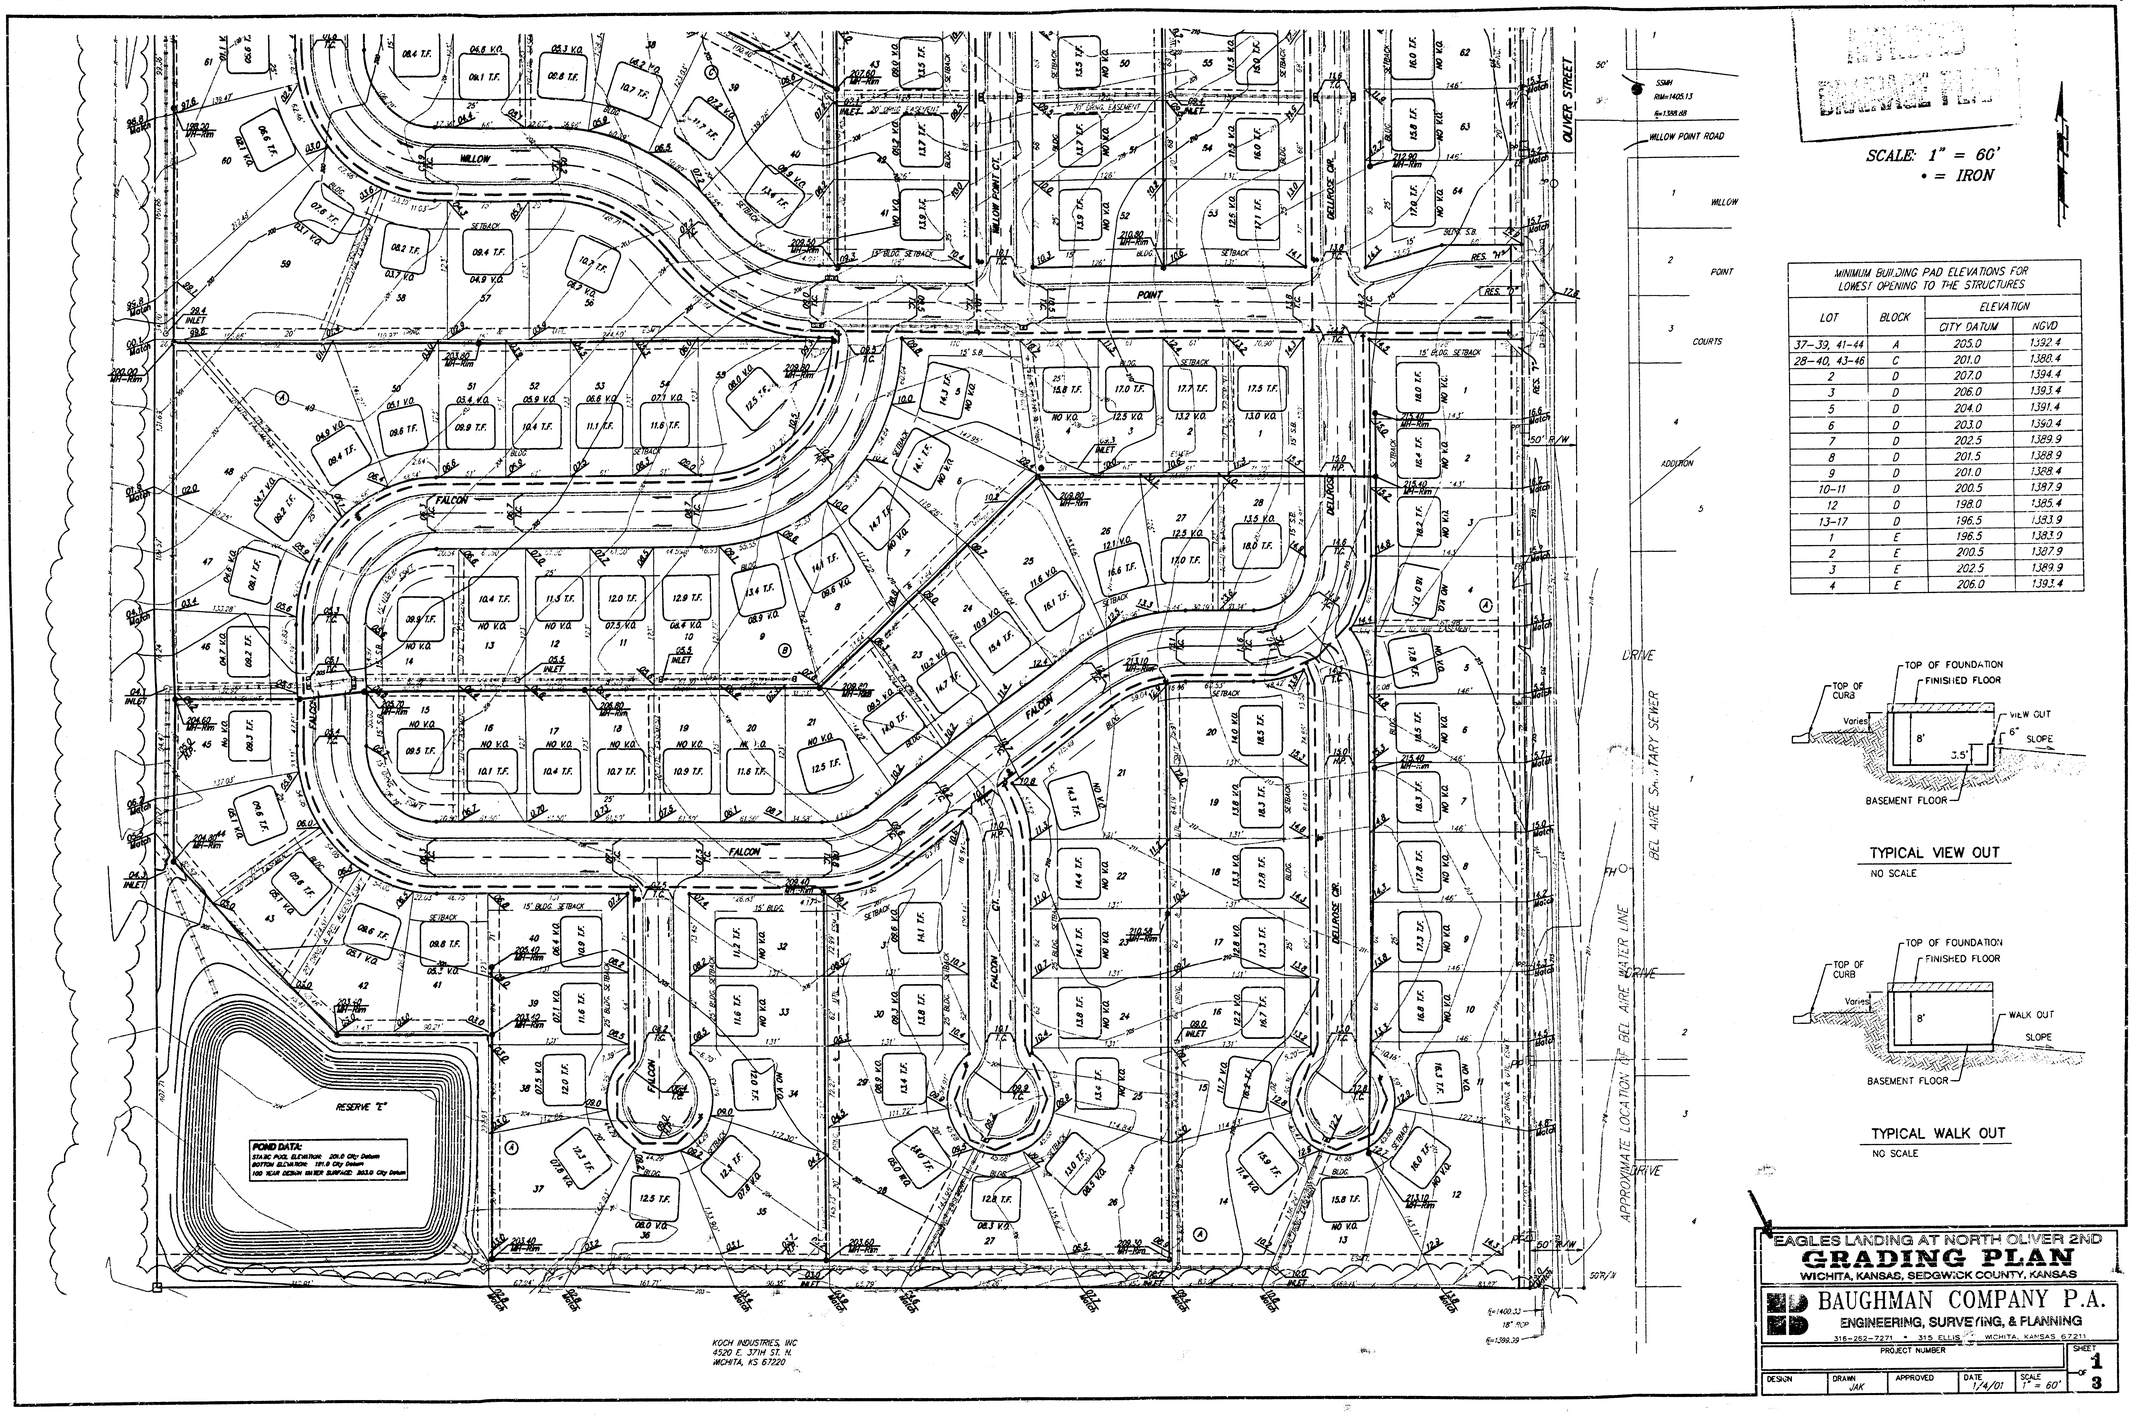


SCALE: 1" = 60'
• = IRON

MINIMUM BUILDING PAD ELEVATIONS FOR LOWEST OPENING TO THE STRUCTURES			
LOT	BLOCK	ELEVATION	
		CITY DATUM	NGVD
37–39, 41–44	A	205.0	1392.4
28–40, 43–46	C	201.0	1388.4
2	D	207.0	1394.4
3	D	206.0	1393.4
5	D	204.0	1391.4
6	D	203.0	1390.4
7	D	202.5	1389.9
8	D	201.5	1388.9
9	D	201.0	1388.4
10–11	D	200.5	1387.9
12	D	198.0	1385.4
13–17	D	196.5	1383.9
1	E	196.5	1383.9
2	E	200.5	1387.9
3	E	202.5	1389.9
4	E	206.0	1393.4

TYPICAL VIEW OUT
NO SCALE


TYPICAL WALK OUT
NO SCALE

EAGLES LANDING AT NORTH OLIVER 2ND
GRADING PLAN
WICHITA, KANSAS, SEDGWICK COUNTY, KANSAS

BAUGHMAN COMPANY P.A.
ENGINEERING, SURVEYING, & PLANNING
316-262-7271 • 315 ELLIS • WICHITA, KANSAS 67211

PROJECT NUMBER


DESIGN	DRAWN	APPROVED	DATE	SCALE	SHEET
	JAK		1/4/01	1" = 60'	1 OF 3

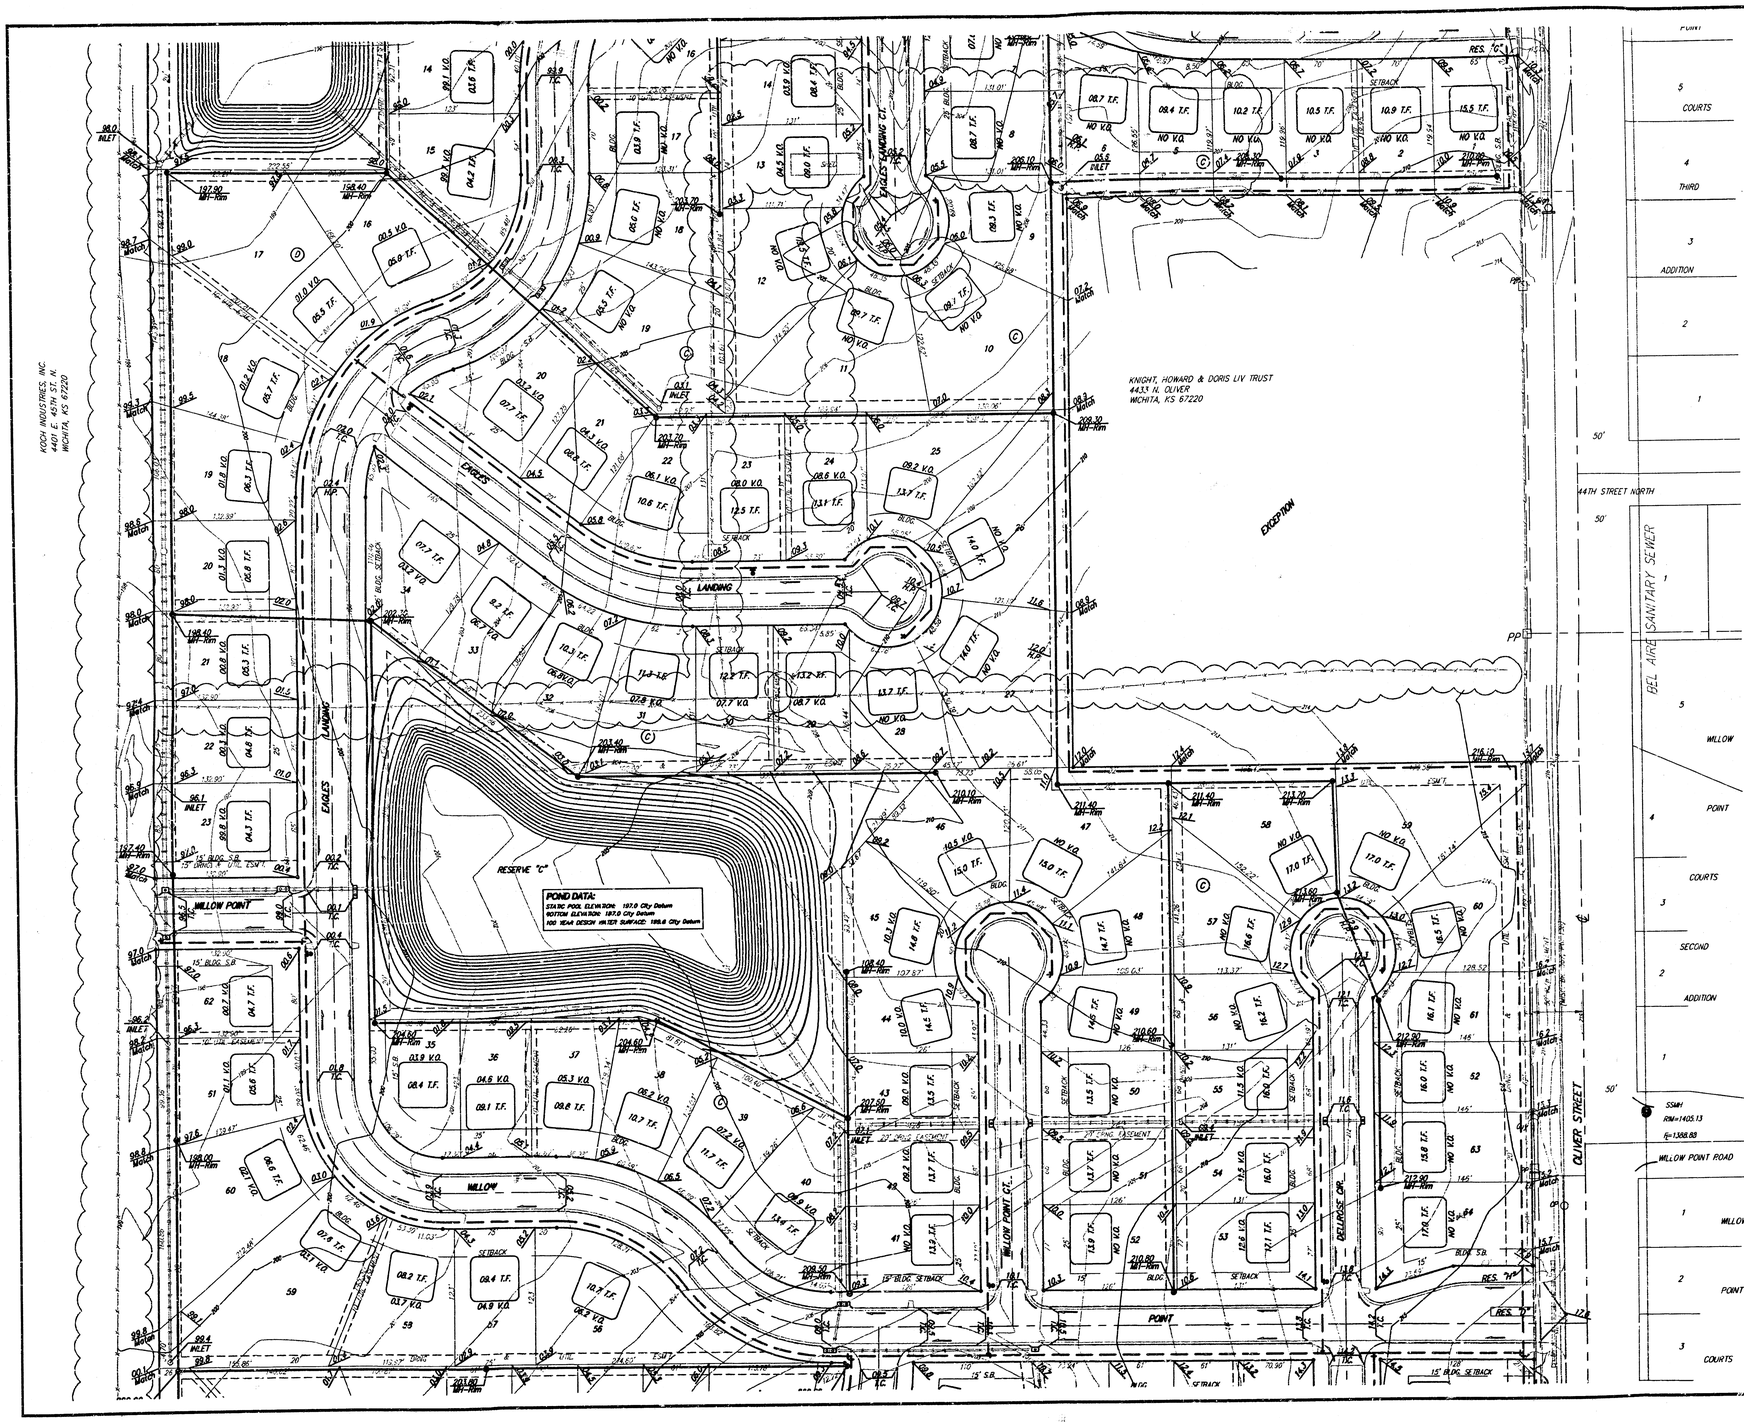

SCALE: 1" = 60'


• = IRON

MINIMUM BUILDING PAD ELEVATIONS FOR LOWEST OPENING TO THE STRUCTURES			
LOT	BLOCK	ELEVATION	
		CITY DATUM	NGVD
37–39, 41–44	A	205.0	1392.4
28–40, 43–46	C	201.0	1388.4
2	D	207.0	1394.4
3	D	206.0	1393.4
5	D	204.0	1391.4
6	D	203.0	1390.4
7	D	202.5	1389.9
8	D	201.5	1388.9
9	D	201.0	1388.4
10–11	D	200.5	1387.9
12	D	198.0	1385.4
13–17	D	196.5	1383.9
1	E	196.5	1383.9
2	E	200.5	1387.9
3	E	202.5	1389.9
4	E	206.0	1393.4

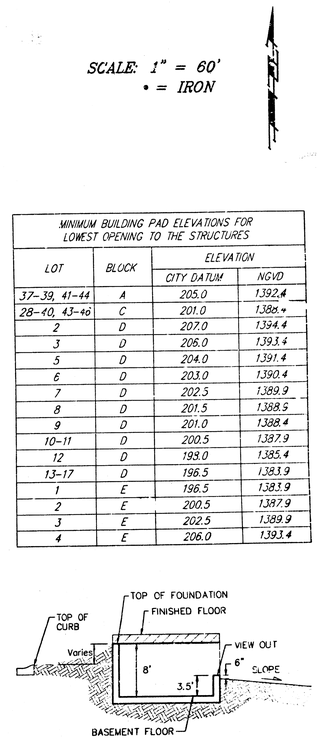

TYPICAL VIEW OUT

NO SCALE

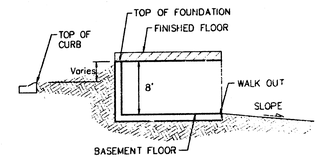

TYPICAL WALK OUT

NO SCALE

EAGLES LANDING AT NORTH OLIVER 2ND

GRADING PLAN

WICHITA, KANSAS, SEDGWICK COUNTY, KANSAS

BAUGHMAN COMPANY P.A.


ENGINEERING, SURVEYING, & PLANNING

316-262-7271 • 315 ELLIS • WICHITA, KANSAS 67211


PROJECT NUMBER					SHEET
					2 OF 3
DESIGN	DRAWN JAK	APPROVED	DATE 1/4/11	SCALE 1" = 60'	

SCALE: 1" = 60'
• = IRON

MINIMUM BUILDING PAD ELEVATIONS FOR LOWEST OPENING TO THE STRUCTURES			
LOT	BLOCK	ELEVATION	
		CITY DATUM	NGVD
37–39, 41–44	A	205.0	1392.4
28–40, 43–46	C	201.0	1388.4
2	D	207.0	1394.4
3	D	206.0	1393.4
5	D	204.0	1391.4
6	D	203.0	1390.4
7	D	202.5	1389.9
8	D	201.5	1388.9
9	D	201.0	1388.4
10–11	D	200.5	1387.9
12	D	198.0	1385.4
13–17	D	196.5	1383.9
1	E	196.5	1383.9
3	E	202.5	1389.9
4	E	206.0	1393.4

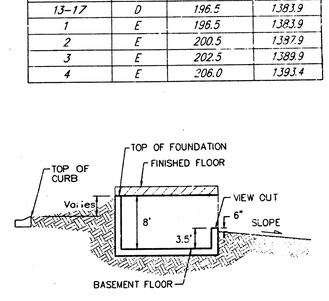

TYPICAL VIEW OUT
NO SCALE

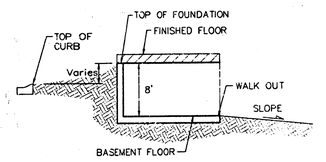

TYPICAL WALK OUT
NO SCALE

KOCH INDUSTRIES, INC.
4111 E. 37TH ST. N.
WICHITA, KS 67220

KNIGHT, HOWARD & DORIS LIV TRUST
4433 N. OLIVER
WICHITA, KS 67220

EAGLES LANDING AT NORTH OLIVER 2ND
GRADING PLAN
WICHITA, KANSAS, SEDGWICK COUNTY, KANSAS

BAUGHMAN COMPANY P.A.
ENGINEERING, SURVEYING, & PLANNING
316-262-7271 • 315 ELLIS • WICHITA, KANSAS 67211

PROJECT NUMBER					SHEET
DESIGN	DRAWN JAK	APPROVED	DATE 1/4/01	SCALE 1" = 60'	3 of 3