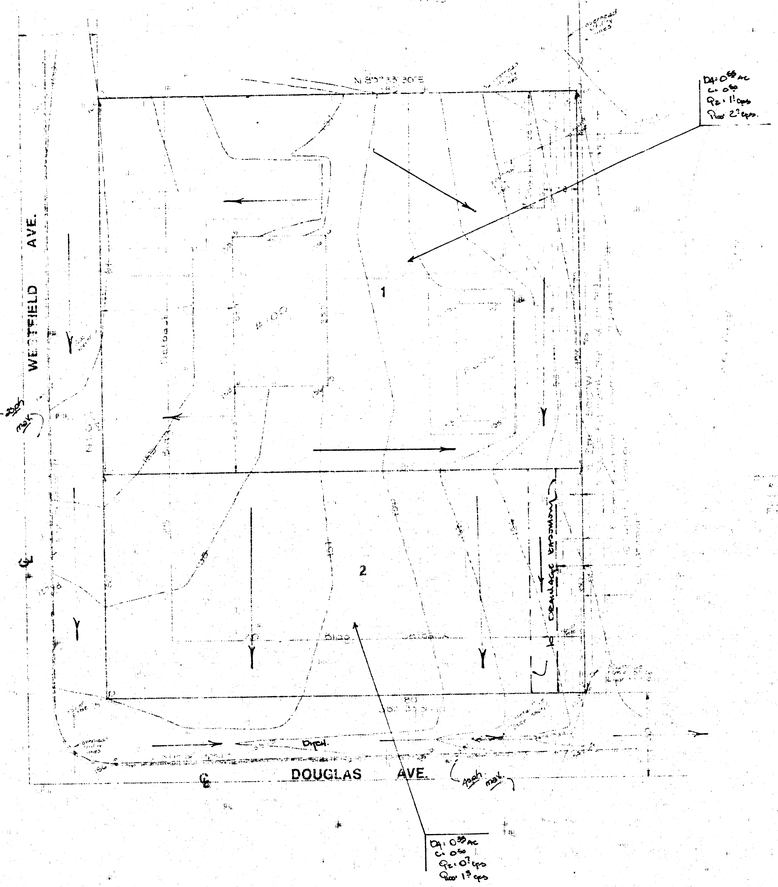


SKETCH PLAT

EARLINE'S ADDITION

THE WEST 180 FEET OF THE SOUTH 214 FEET OF LOT 19, WESTFIELD ACRES, SEDGWICK COUNTY, KANSAS

OWNER: EARLINE AND S. E. SIMPSON

DRAINAGE PLAN

BAUGHMAN COMPANY, P.A.
SURVEYING & ENGINEERING