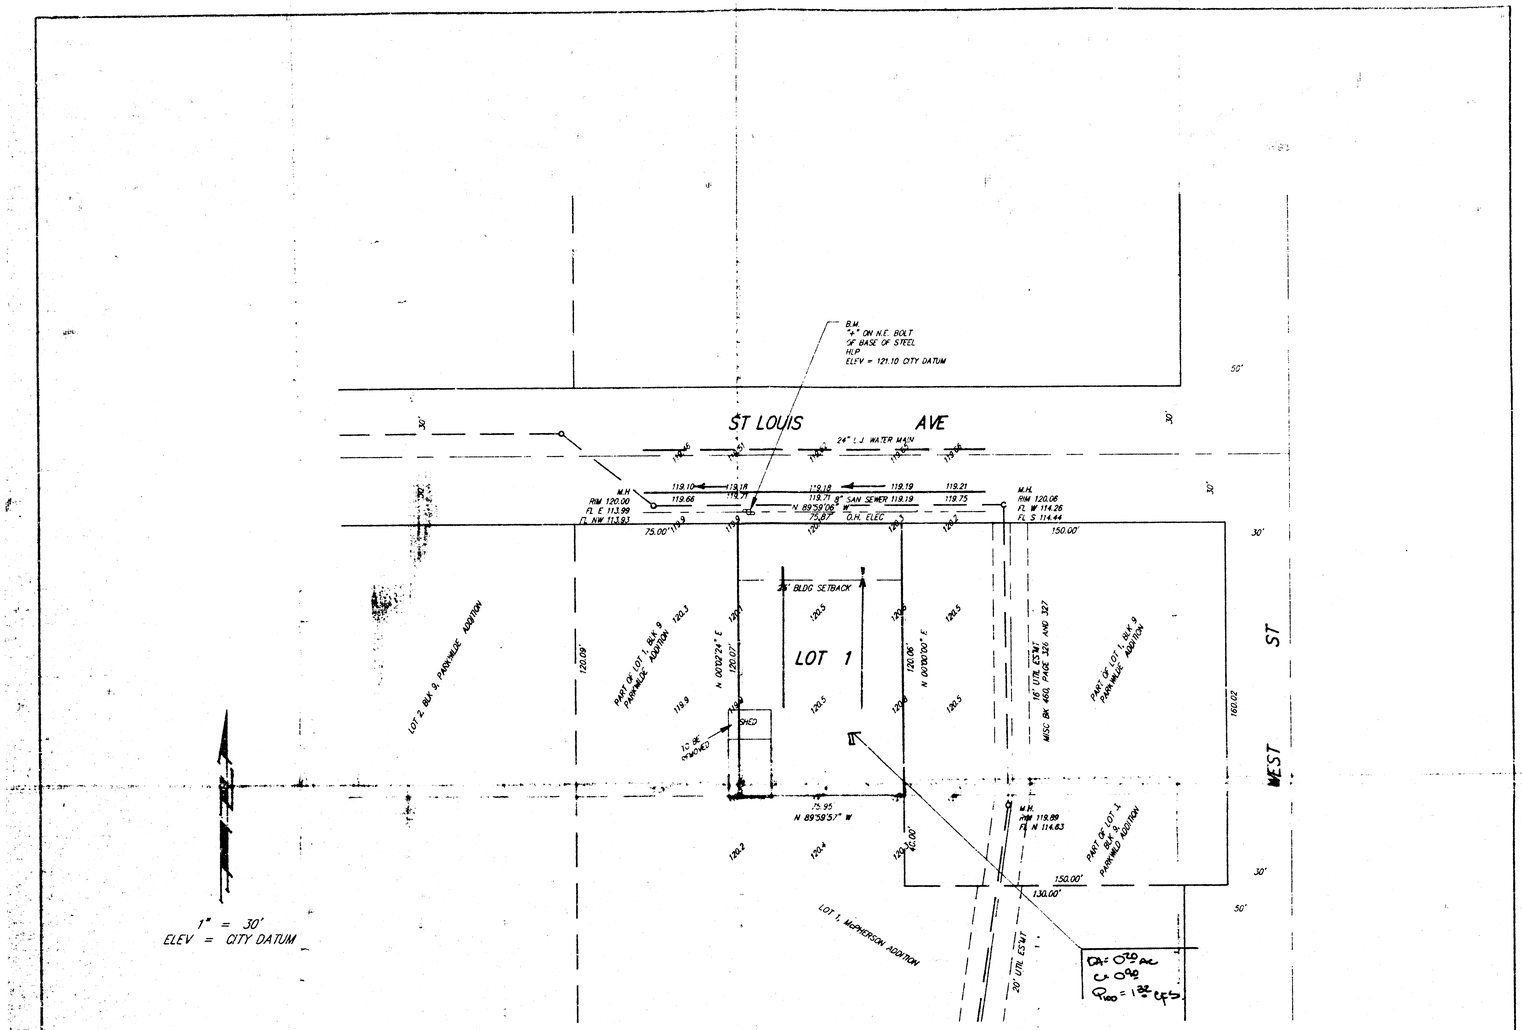


SKETCH PLAT

E.C.I. 2ND ADDITION

LOT 1, EXCEPT THE EAST 150 FEET THEREOF AND EXCEPT THE WEST 75 FEET THEREOF, BLOCK 9, PARKWILDE ADDITION TO WICHITA, KANSAS.

ELECTRICAL CONTRACTORS, INC.
KENT SEILER, PRESIDENT
2420 WHEATRIDGE DR.
WICHITA, KS 67233

PH 722-0204

DRAINAGE PLAN

BAUGHMAN COMPANY P. A.
SURVEYING & ENGINEERING
316/262-7271 • 315 ELLIS • WICHITA, KANSAS 67211

22 NOV 91

FILMED FROM THE BEST