
REVISED

SKETCH PLAT

ELIZABETH,S ADDITION

BEING A REPLAT OF THE RESERVE, BLOCK 1, EXCEPT THE WEST 392 FEET THEREOF, SHADYBROOK ADDITION, WICHITA, SEDGWICK COUNTY, KANSAS

OWNERS: JULIUS SMITH
LEE LUINSTRA

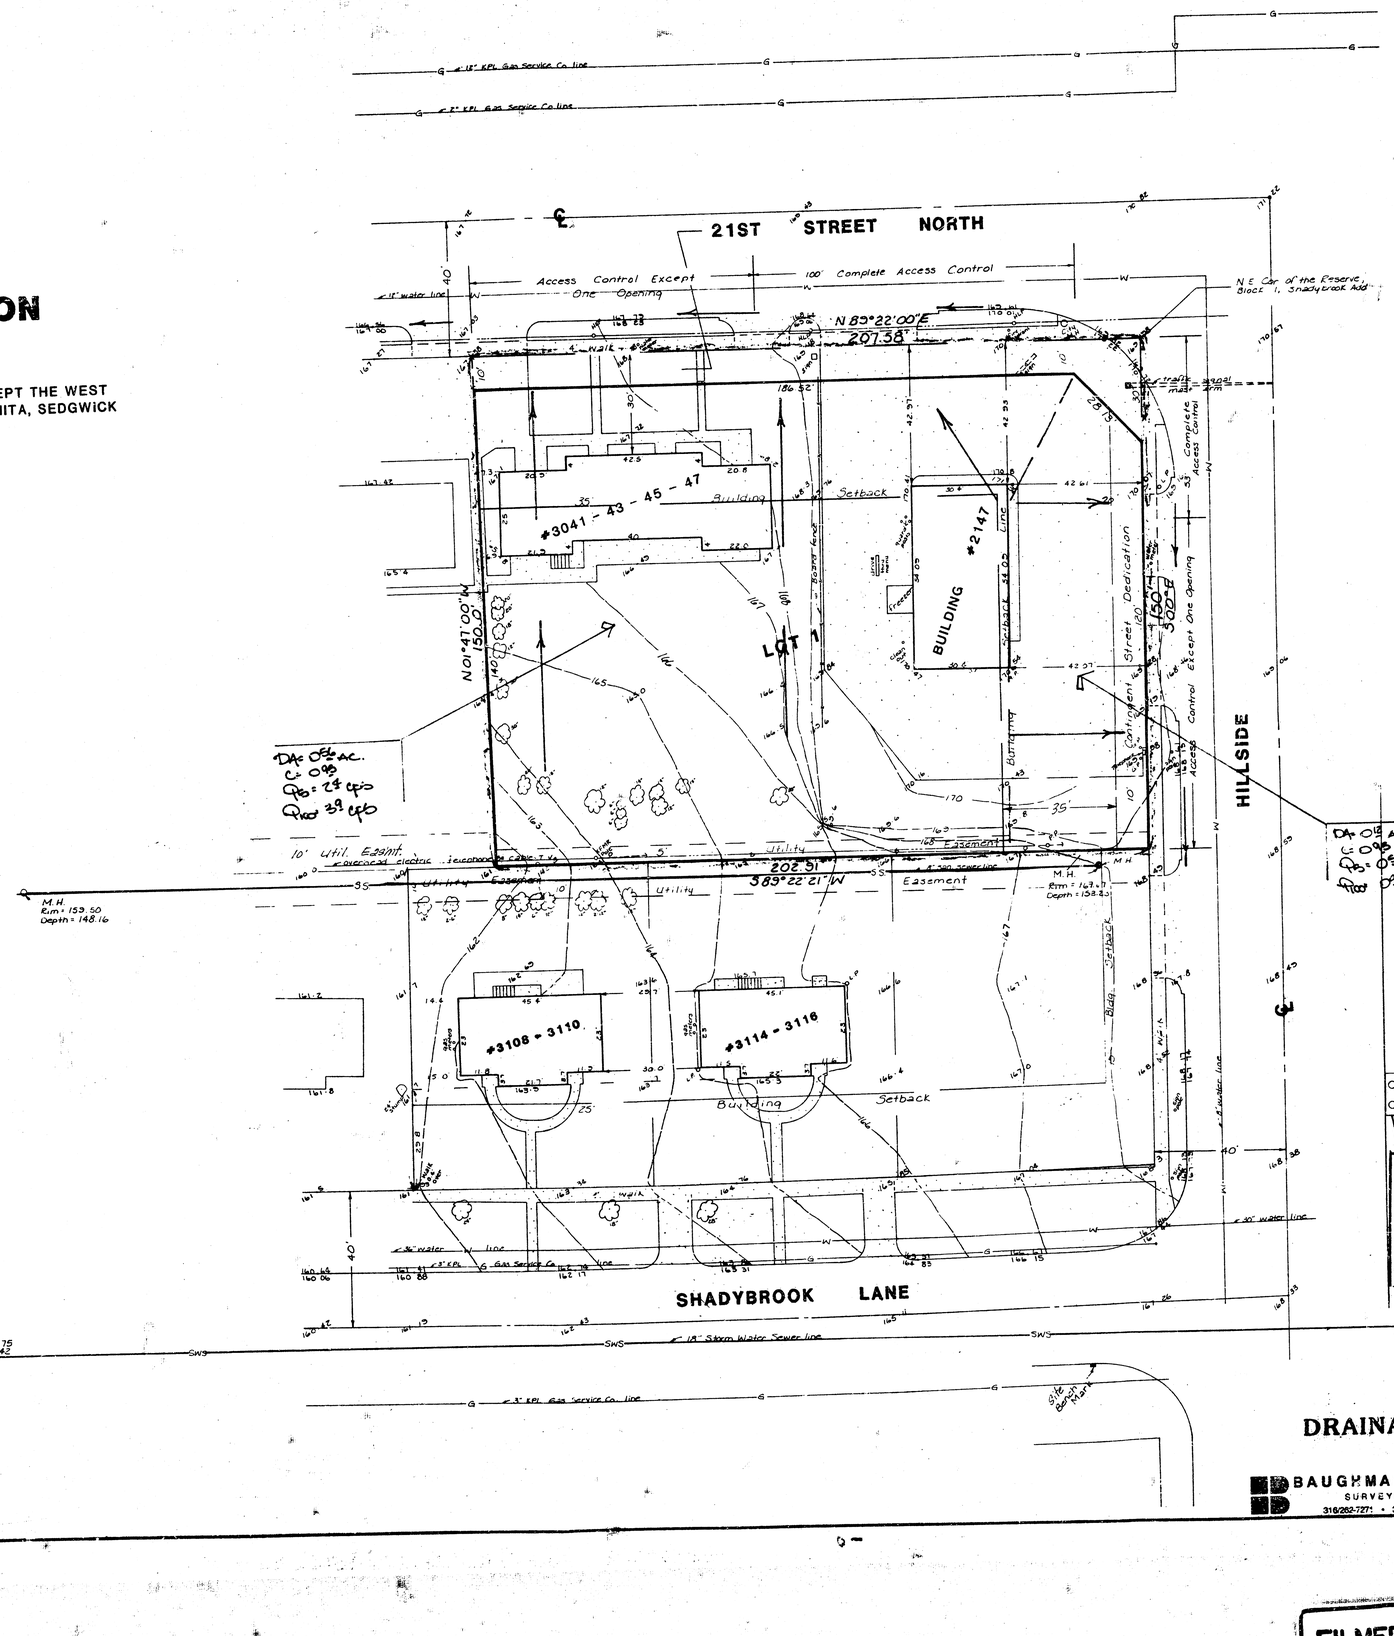

APPROVED
DRAINAGE PLAN

DRAINAGE PLAN

Revised MAR 5, 91

BAUGHMAN COMPANY, P.A.
SURVEYING & ENGINEERING
316/262-7271 • 315 ELLIS • WICHITA, KANSAS 67211

12-28-90

FILMED FROM THE BEST AVAILABLE COPY