


Fachner

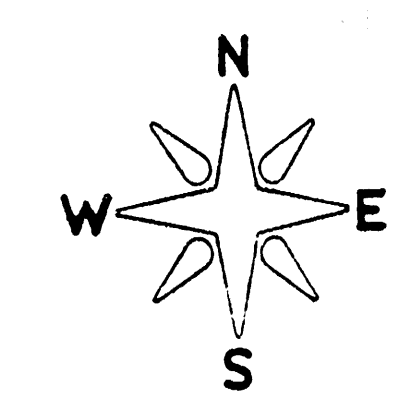

1" = 20'

Legend -

- W = Water Main
- G = Gas Main
- SWS = Storm Water Sewer
- UP = Utility Pole
- GM = Gas Meter
- SE = Spot Elevation
- OE = Overhead Electric
- TC = Top of Curb
- FL = Flow Line
- MH = Manhole
- SS = Sanitary Sewer

Benchmark -

"B" on E. Curb of West St.
Opposite N.W. Prop. Cor.
Elev. 102.33 City Datum.

DRAINAGE PLAN

for

FACHNER ADDITION TO WICHITA, SEDGWICK COUNTY, KANSAS


LEGAL DESCRIPTION -



THE SOUTH HALF OF LOT 10, BLOCK 1, FOURTH ADDITION TO
SOUTHWEST VILLAGE, WICHITA, SEDGWICK COUNTY, KANSAS,
TOGETHER WITH THE WEST HALF OF THE VACATED ALLEY
ADJOINING ON THE EAST.

NOTE -

Surface water drainage to be directed to adjacent streets,
via storm sewers, drives, flumes or other approved openings.

MOEHRING & ASSOCIATES
CONSULTING ENGINEERS
WICHITA
Nov. 14, 1988

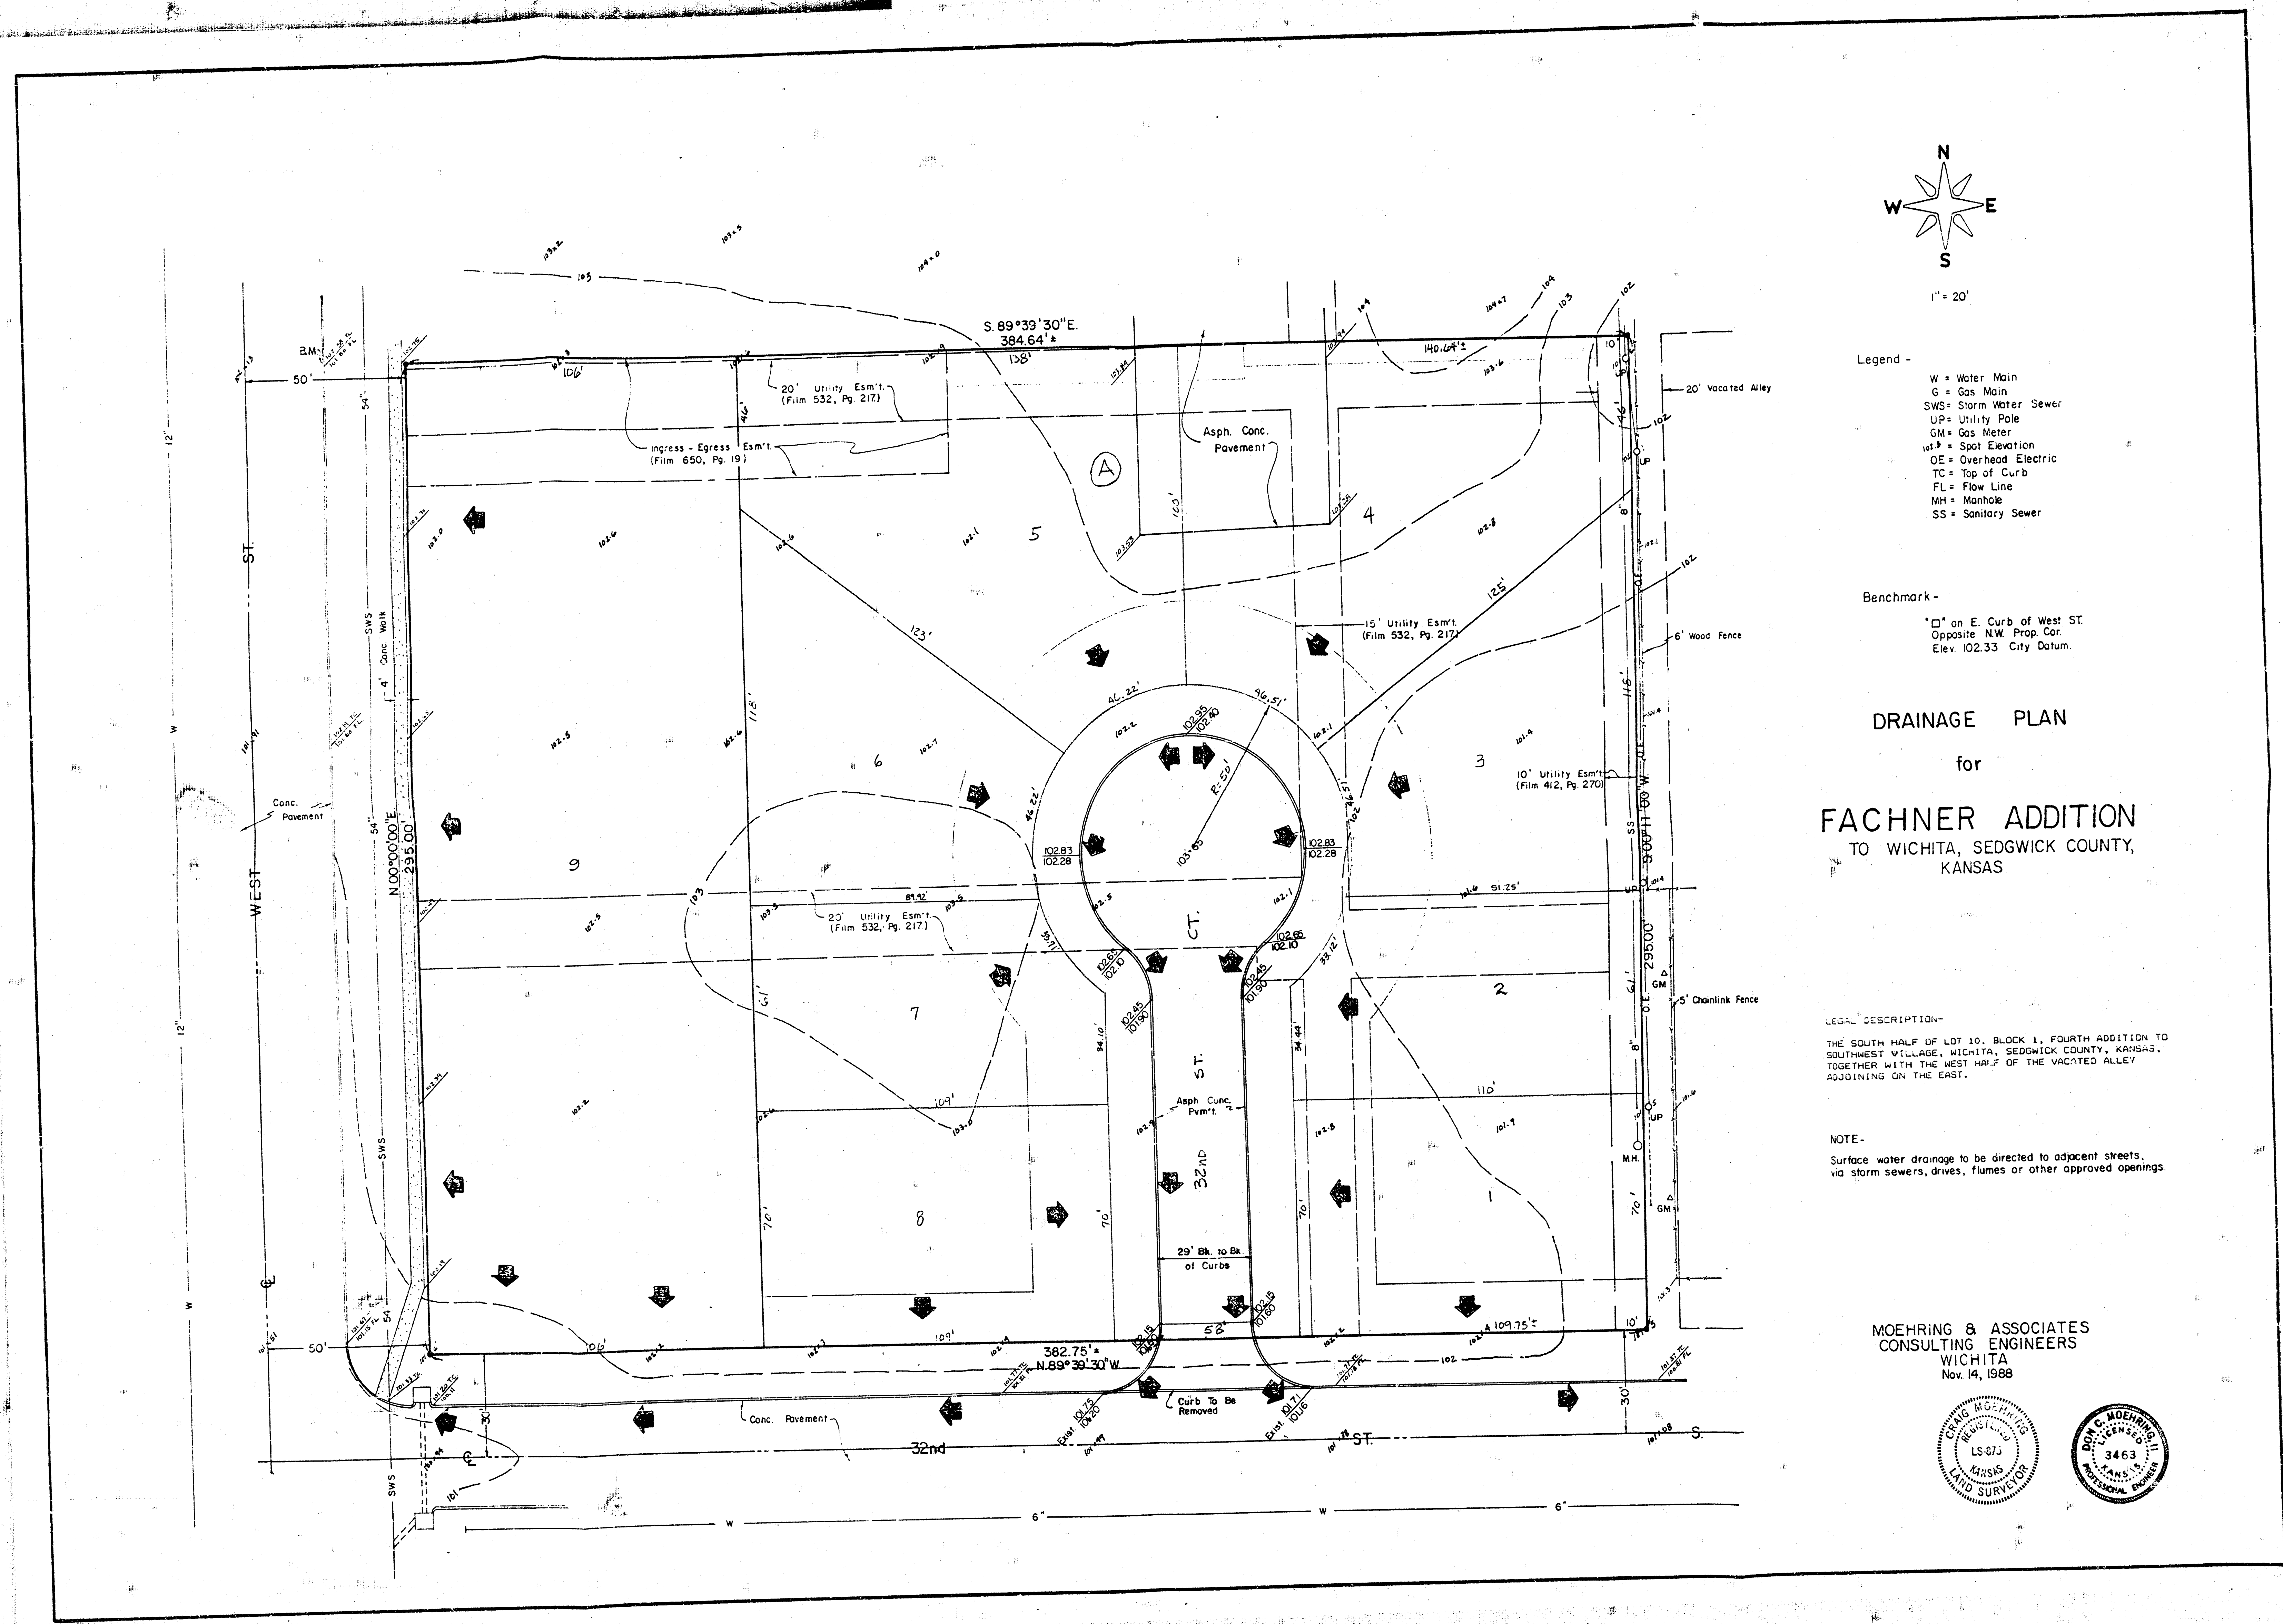

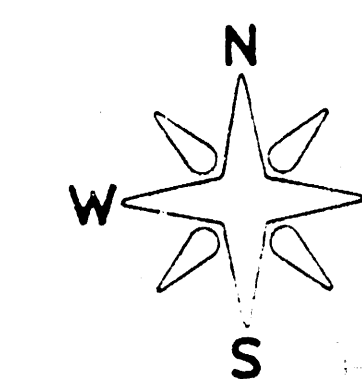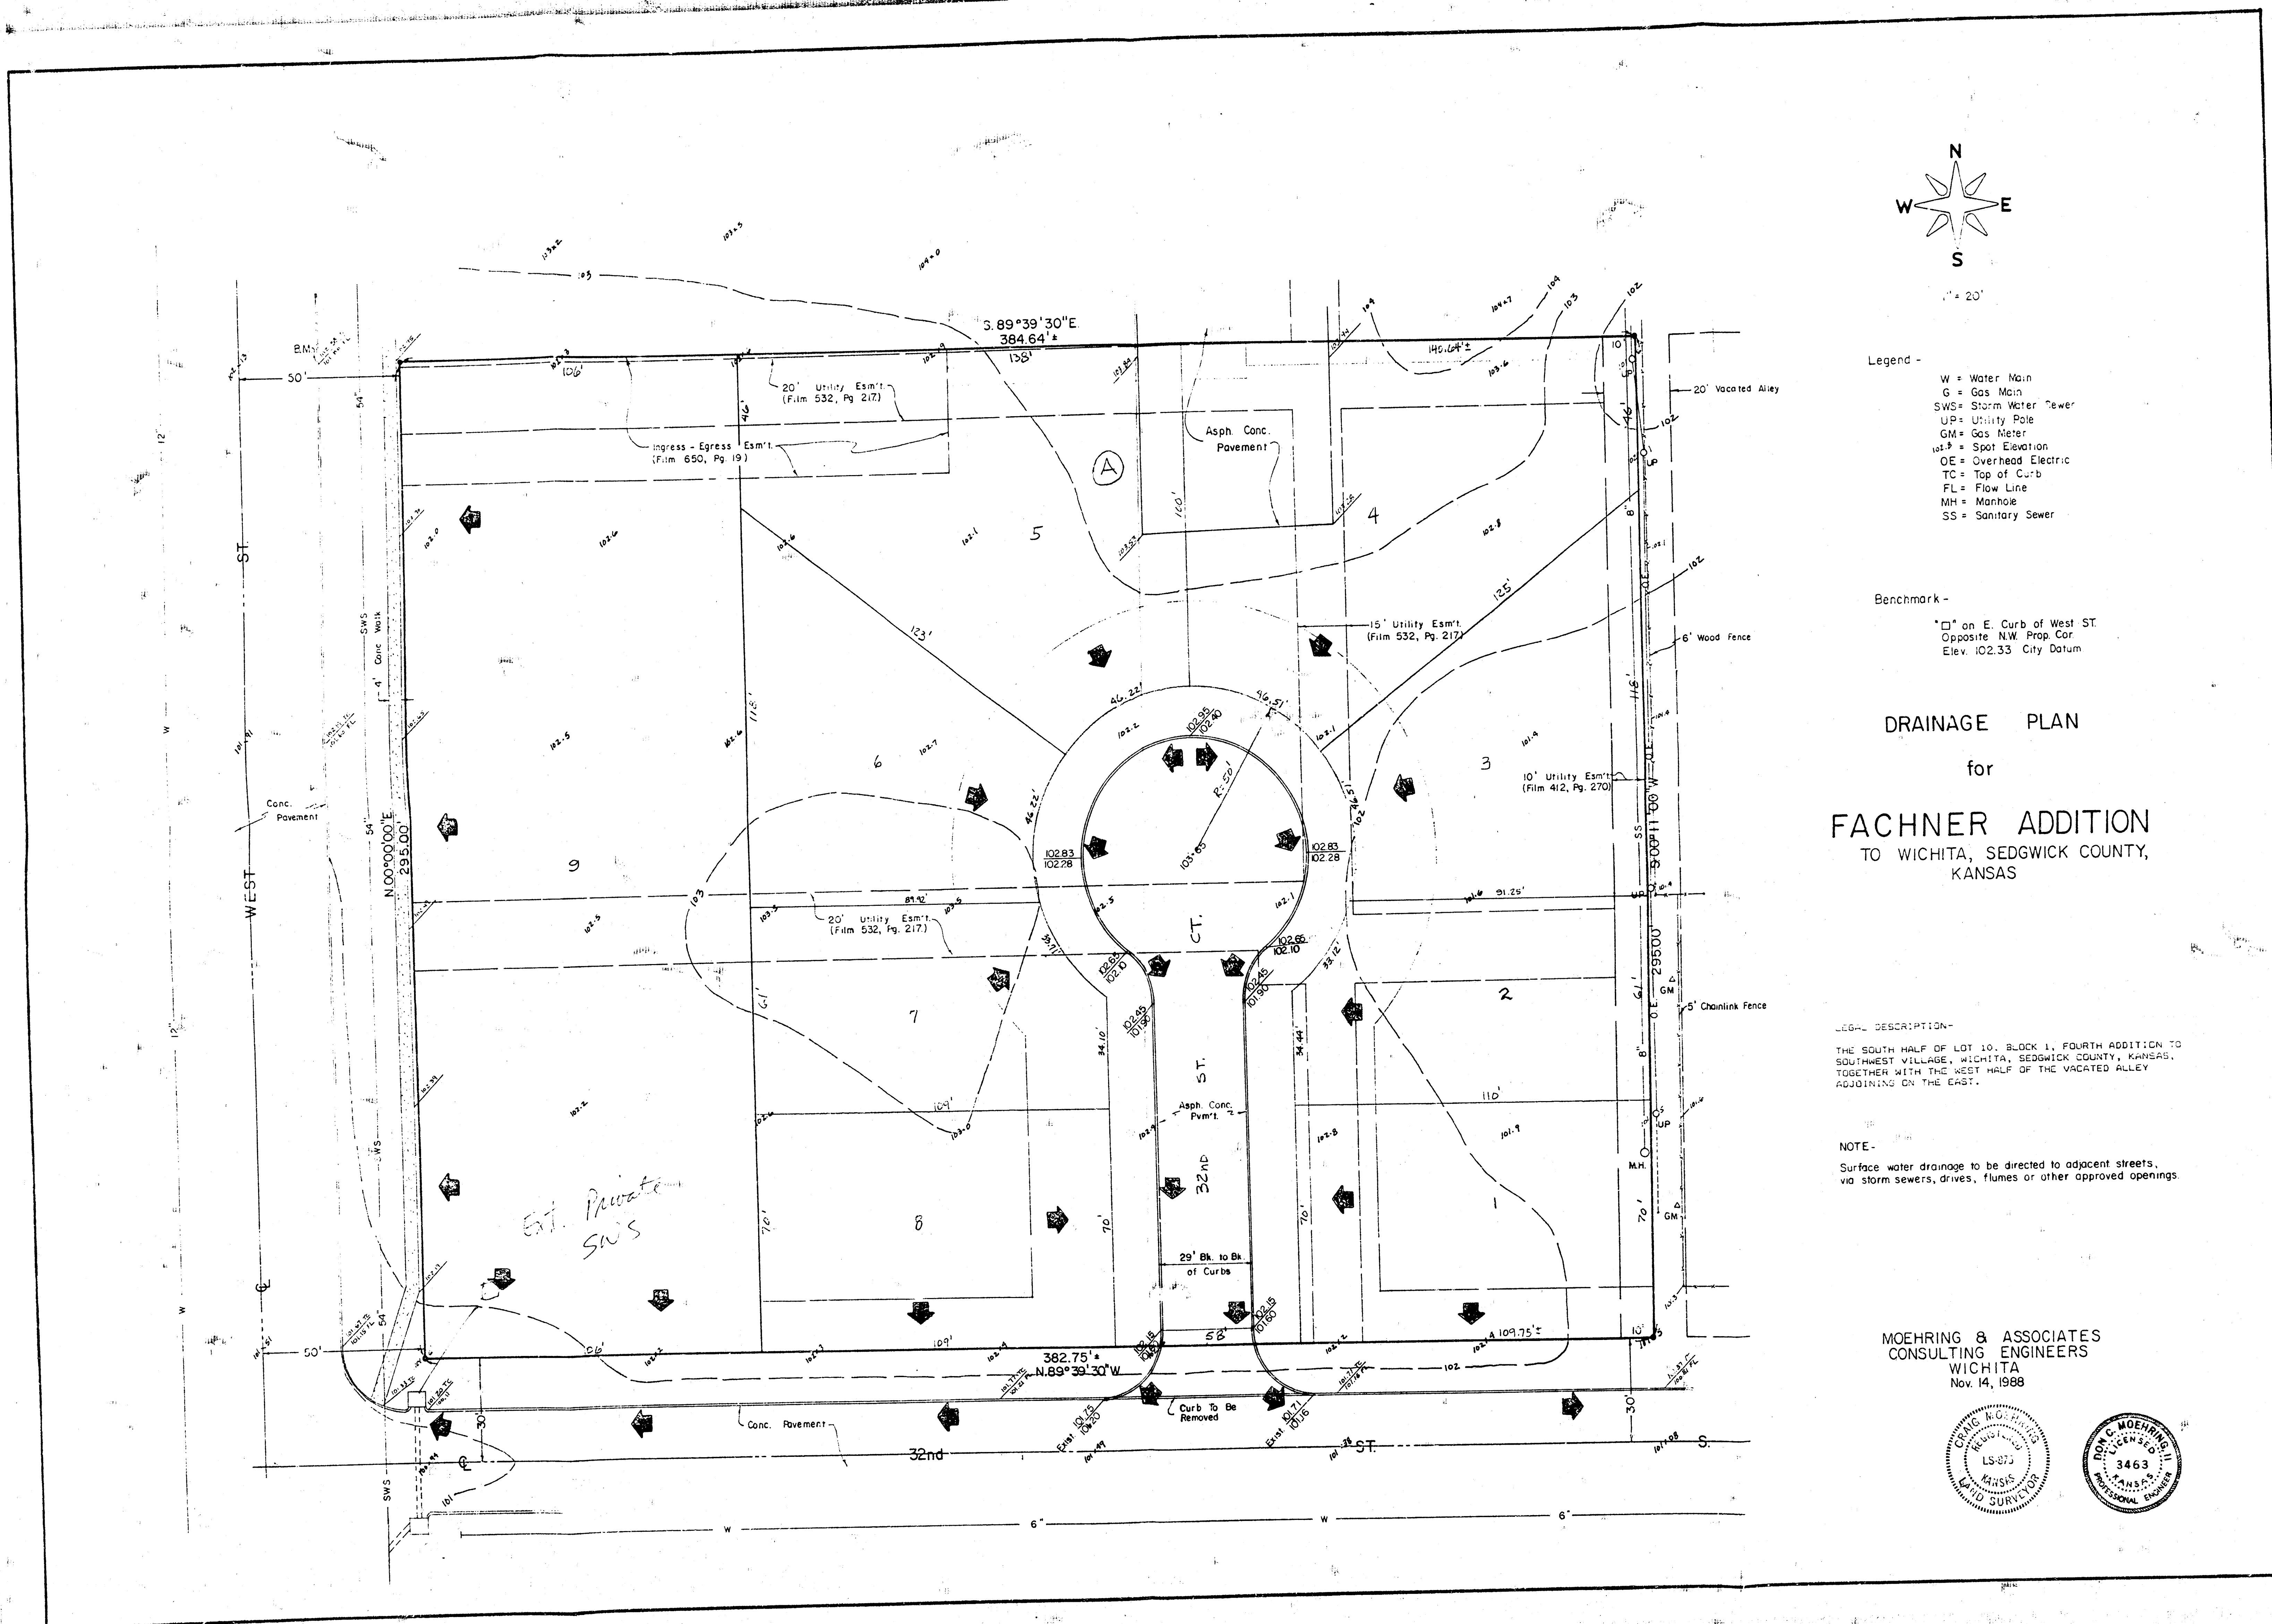

Legend -

- W = Water Main
- G = Gas Main
- SWS = Storm Water Sewer
- UP = Utility Pole
- GM = Gas Meter
- SP = Spot Elevation
- OE = Overhead Electric
- TC = Top of Curb
- FL = Flow Line
- MH = Manhole
- SS = Sanitary Sewer

Benchmark -



BM on E. Curb of West St.
Opposite NW Prop. Cor.
Elev. 102.33 City Datum


DRAINAGE PLAN
for
FACHNER ADDITION
TO WICHITA, SEDGWICK COUNTY,
KANSAS

LEGAL DESCRIPTION -
THE SOUTH HALF OF LOT 10, BLOCK 1, FOURTH ADDITION TO
SOUTHWEST VILLAGE, WICHITA, SEDGWICK COUNTY, KANSAS,
TOGETHER WITH THE WEST HALF OF THE VACATED ALLEY
ADJOINING ON THE EAST.

NOTE -
Surface water drainage to be directed to adjacent streets,
via storm sewers, drives, flumes or other approved openings.

MOEHRING & ASSOCIATES
CONSULTING ENGINEERS
WICHITA
Nov. 14, 1988

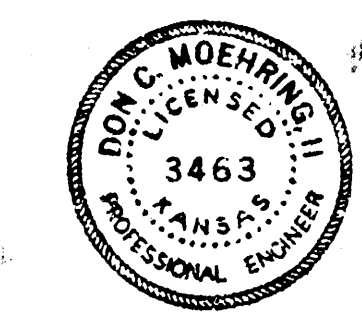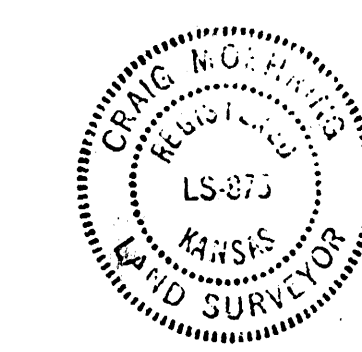

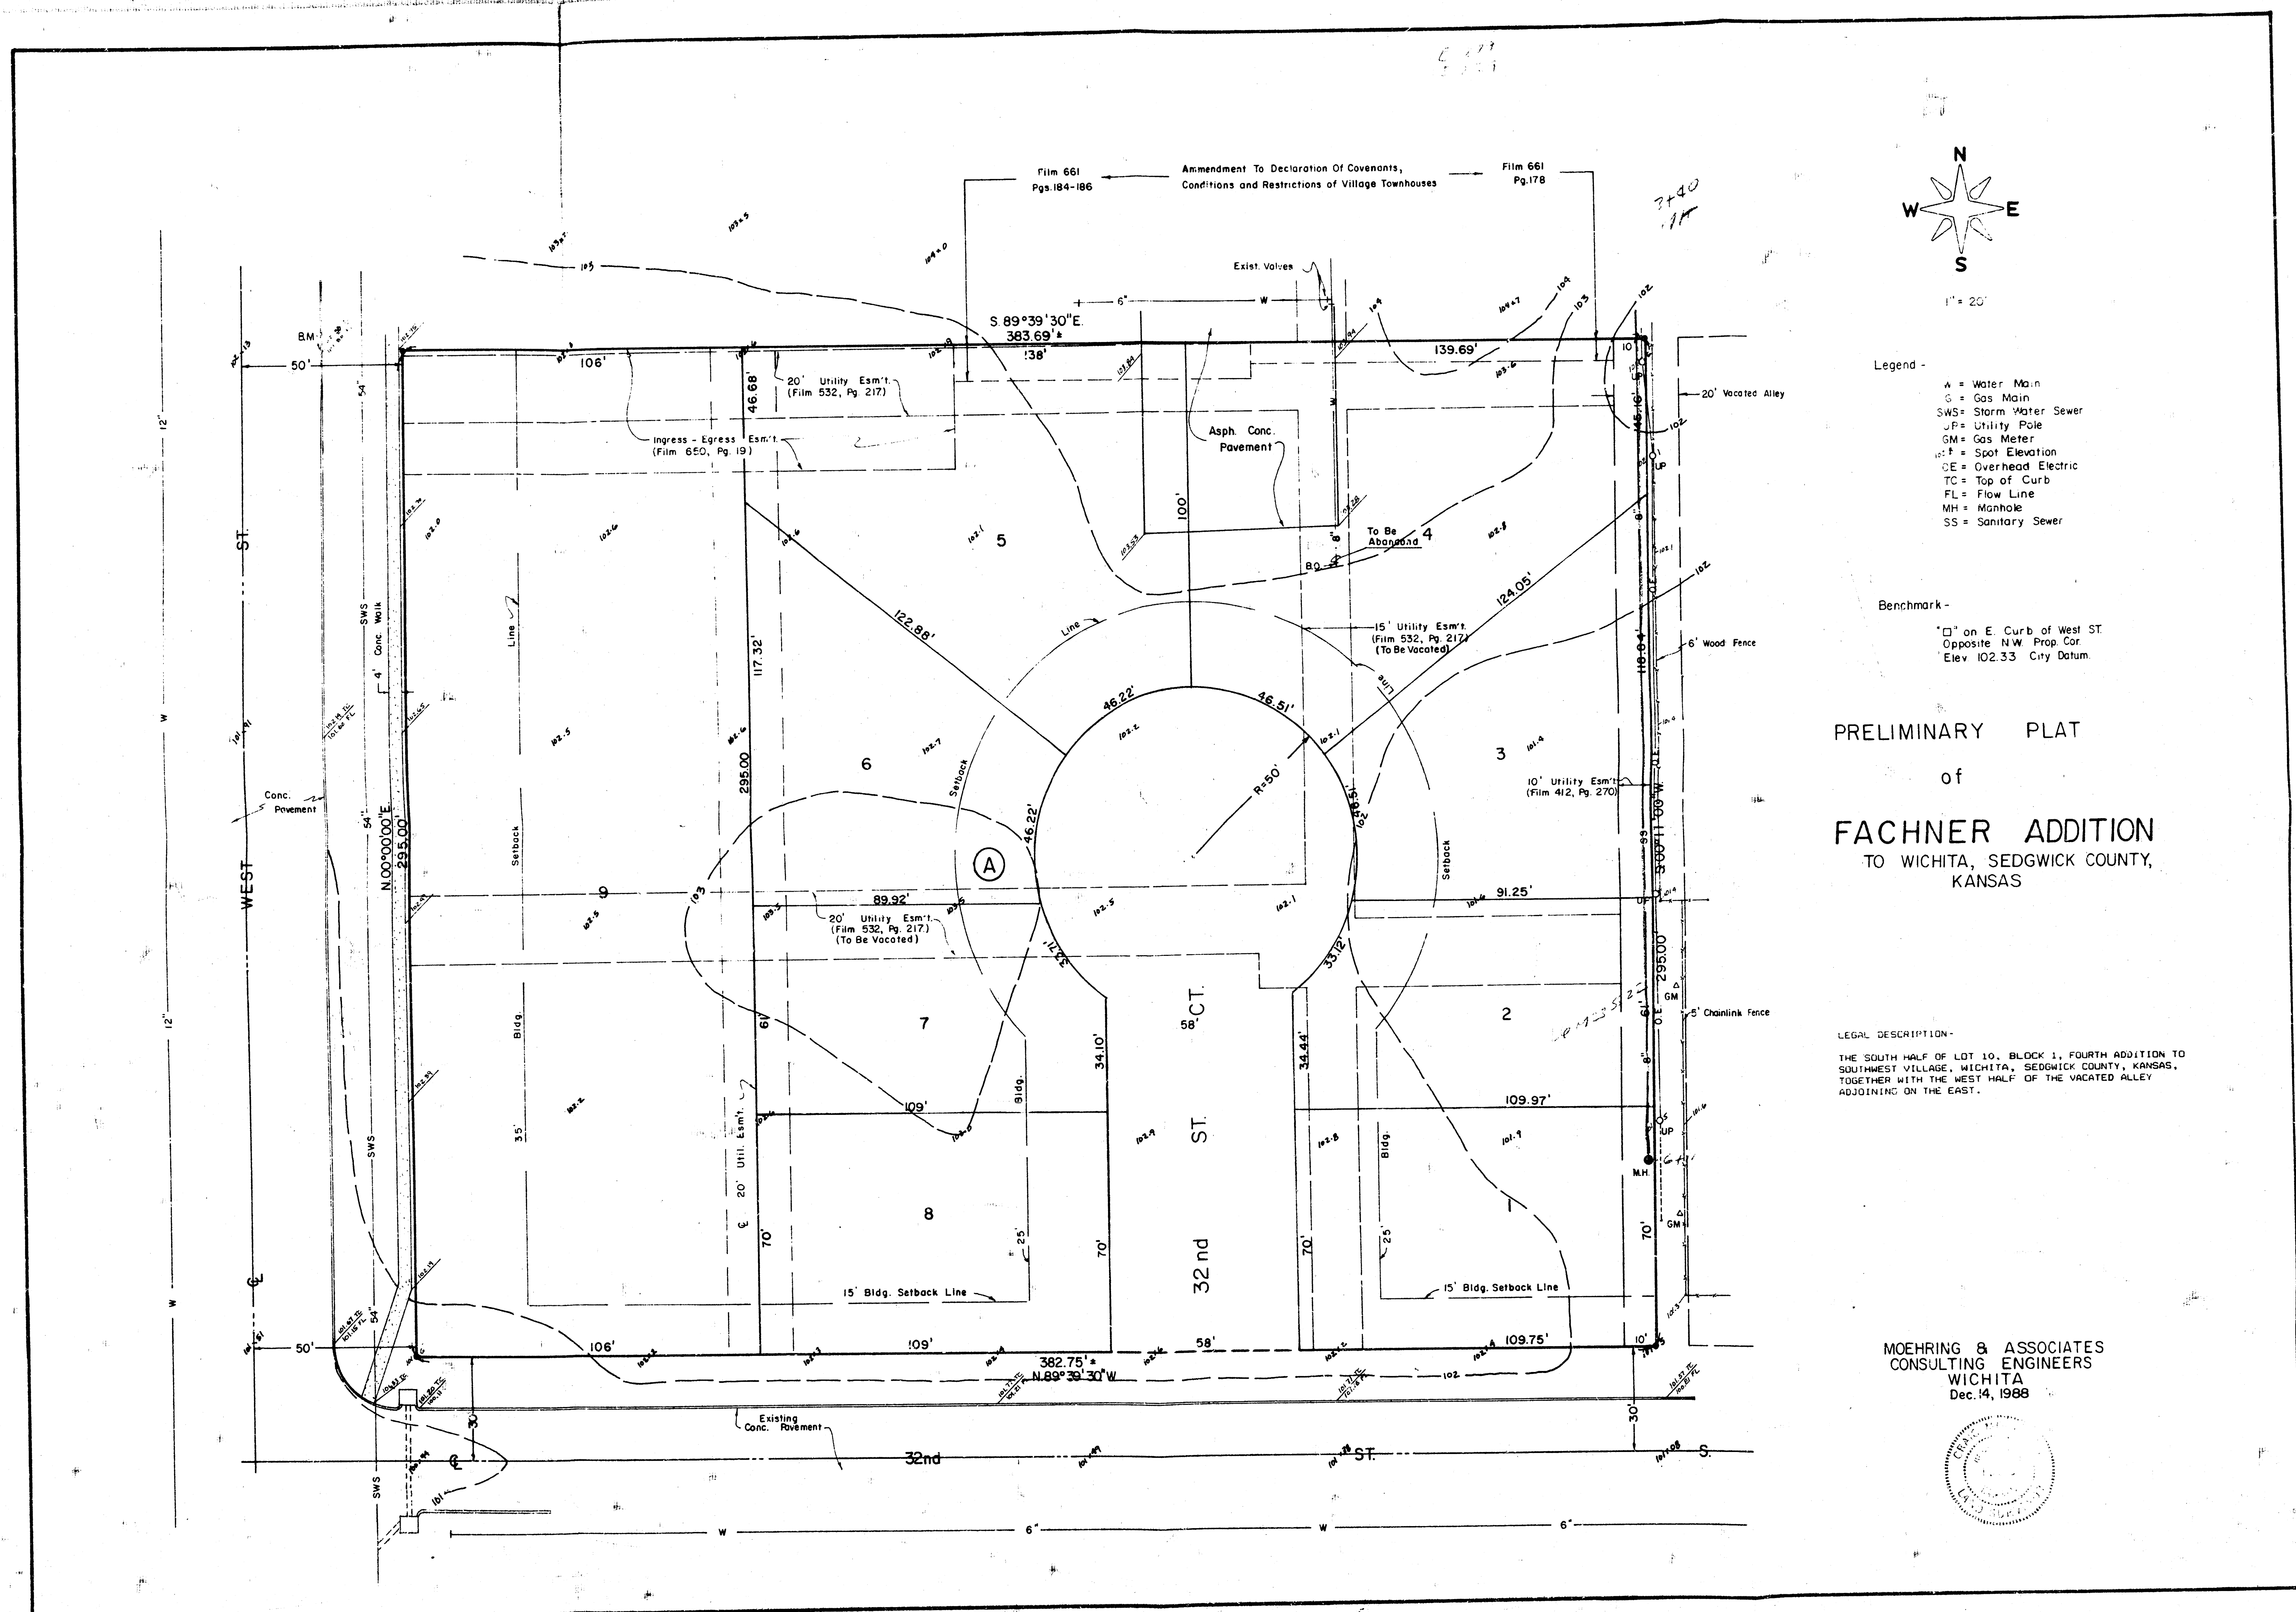

Legend -

- W = Water Main
- G = Gas Main
- SWS = Storm Water Sewer
- UP = Utility Pole
- GM = Gas Meter
- st = Spot Elevation
- OE = Overhead Electric
- TC = Top of Curb
- FL = Flow Line
- MH = Manhole
- SS = Sanitary Sewer

Benchmark -

□ on E. Curb of West St.
Opposite N.W. Prop. Car.
Elev. 102.33 City Datum.

PRELIMINARY PLAT
of
FACHNER ADDITION
TO WICHITA, SEDGWICK COUNTY,
KANSAS

LEGAL DESCRIPTION -

THE SOUTH HALF OF LOT 10, BLOCK 1, FOURTH ADDITION TO
SOUTHWEST VILLAGE, WICHITA, SEDGWICK COUNTY, KANSAS,
TOGETHER WITH THE WEST HALF OF THE VACATED ALLEY
ADJOINING ON THE EAST.

MOEHRING & ASSOCIATES
CONSULTING ENGINEERS
WICHITA
Dec. 4, 1988

