
DRAINAGE PLAN
FAWN GROVE AT SUNSET LAKES
WICHITA, KANSAS

Scale: 1" = 100'

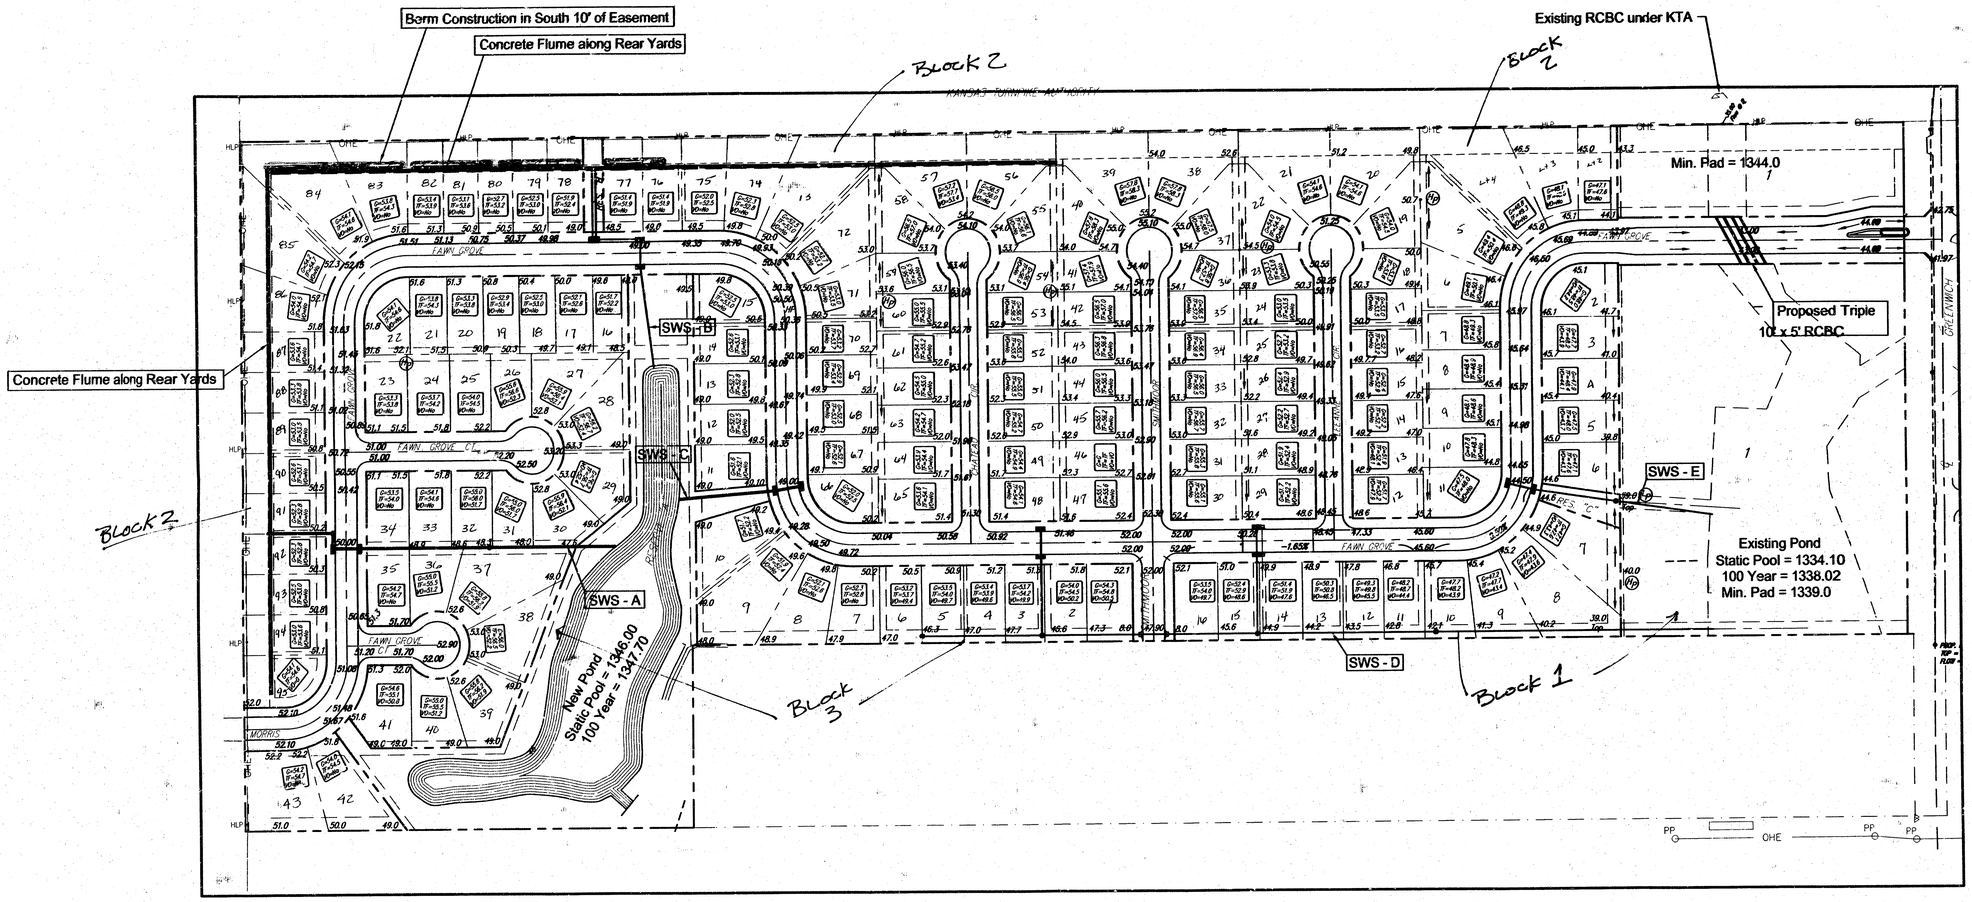

APPROVED
DRAINAGE PLAN

BRIAN LEWIN GLOVER
LICENSED
8144
1-19-05
KANSAS
PROFESSIONAL ENGINEER

DRAINAGE PLAN
FAWN GROVE AT SUNSET LAKES
WICHITA, KANSAS

Ruggles & Bohm, P.A.
Engineering, Surveying, Land Planning
924 North Main (316) 264-8008
Wichita, Kansas 67203 (316) 264-4621 fax
www.rbkansas.com E-mail: info@rbkansas.com

DESIGN	CMB
DRAWN	CMB
REVIEW	
UTILITY	
DATE	01/18/05
RB JOB	
SHEET	1 OF 1
DRAWING FILE	base/site grading plan
PROJECT NUMBER	2422P