


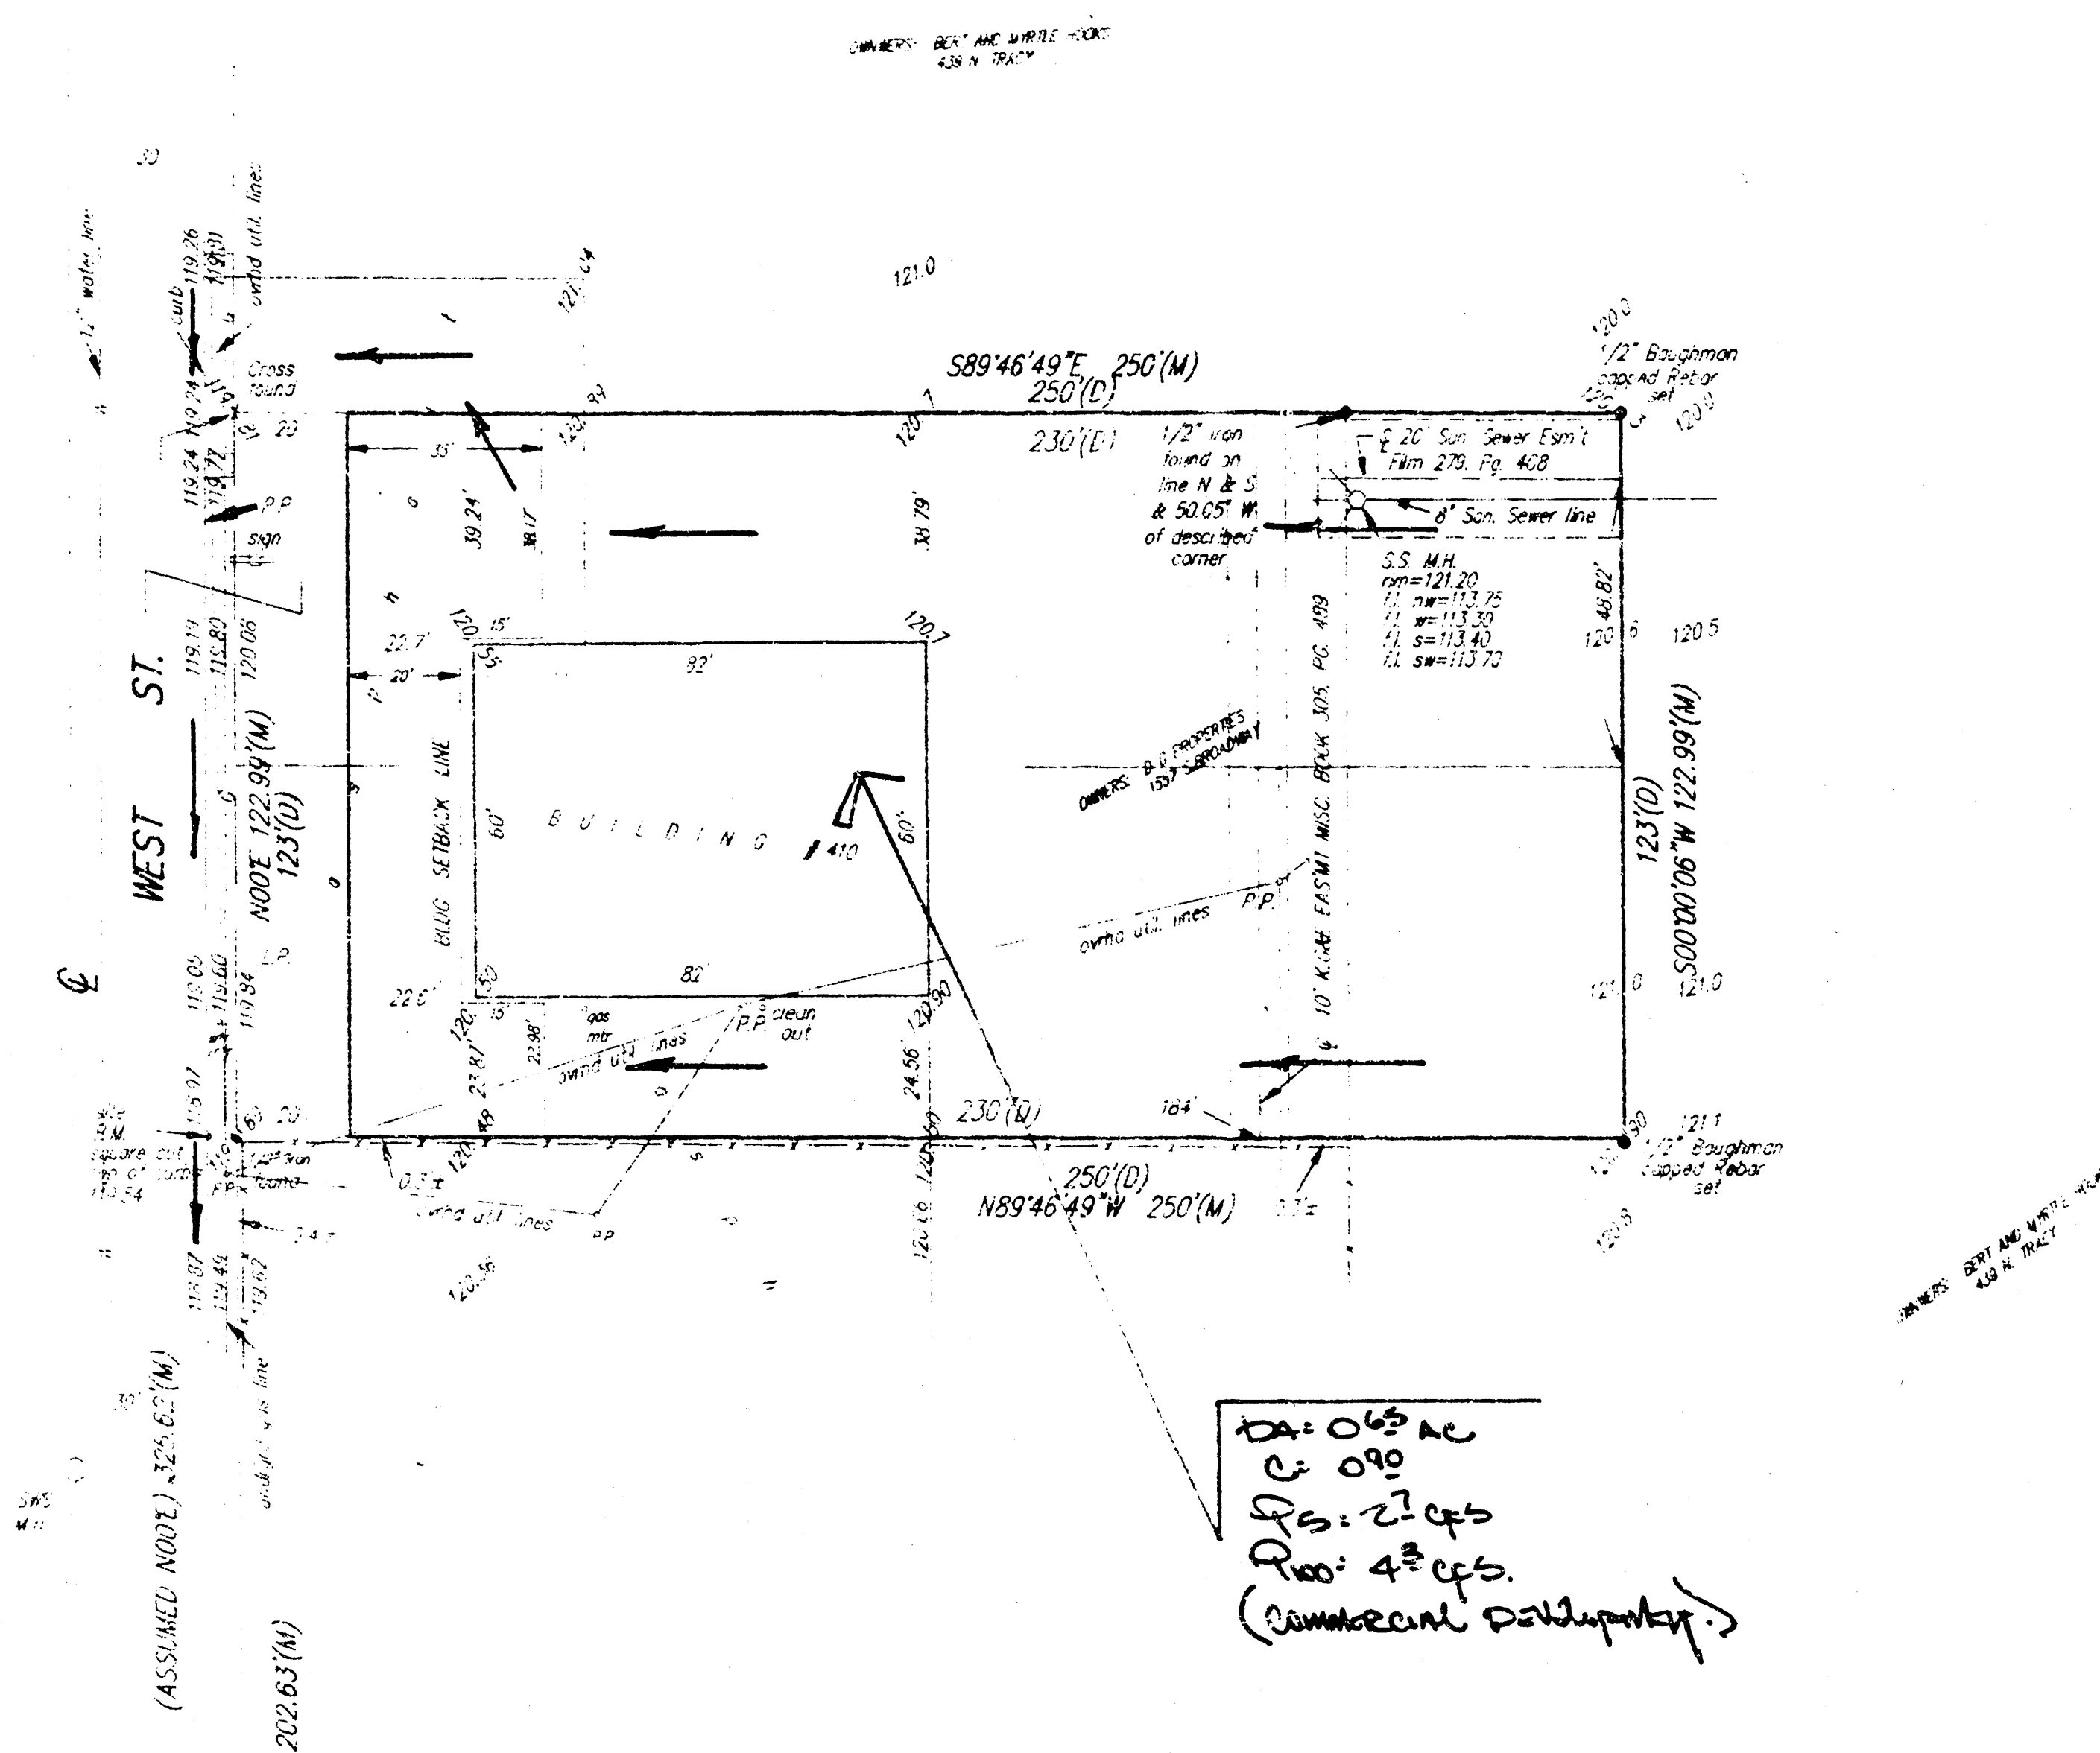

DRAINAGE PLAN

SKETCH PLAT

GEORGE'S WEST ADDITION

WICHITA, SEDGWICK COUNTY, KANSAS

Replat of the west 250 feet of the south 60 feet of Lot 37,
and the west 250 feet of the north 67 feet of Lot 38, Knight
Addn, Wichita, Sedgwick County, Kansas

OWNER:


D. G. Properties
1517 S. Broadway
Wichita, KS 67211

AND

Bert and Myrtle Hays
439 N. Tracy
Wichita, KS 67212


Scale 1"=30'
Found corners are of unidentified
origin unless identified on sketch
(P) = Platted
(M) = Measured
(D) = Described
dearing Base = Assumed
Y = Cross Found
● = 1/2" Baughman capped Rebar set
○ = 1/2" Rebar found
○ = 1/2" Iron found

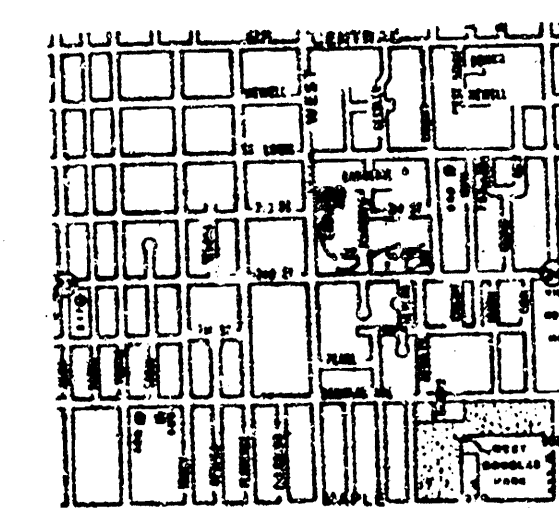

Vicinity Map

BENCH MARK
City Plat 34 west 18' south of
centerlines of 2nd St. & West St.
Elevation = 118.97 City Datum