
DAVID MATTHEW GRANT ADDITION
(Drainage)

TERRA TECH
LAND SURVEYING INC.

2475 West Devonshire
Wichita, Kansas 67213 - 2607
(316) 267-0744 / 267-2348

VICINITY MAP
Part of NE¼ Sec. 19, T27S, R1E.

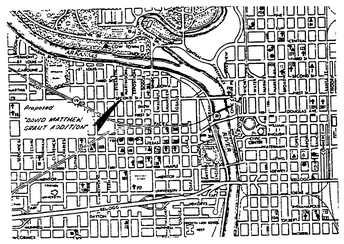

Owners / Subdividers:

Billy C. & Cathy O. Grant
406 W. Second Street
Wichita, Kansas 67203


NOT TO SCALE

Proposed Plat Name:

"DAVID MATTHEW GRANT ADDITION"
Wichita, Sedgwick County, Kansas

1 AUGUST, 1986

Site Drainage Plan

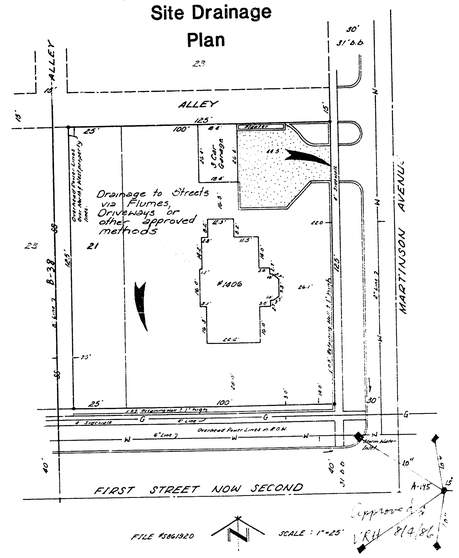

FILE #861320

SCALE : 1"=25'