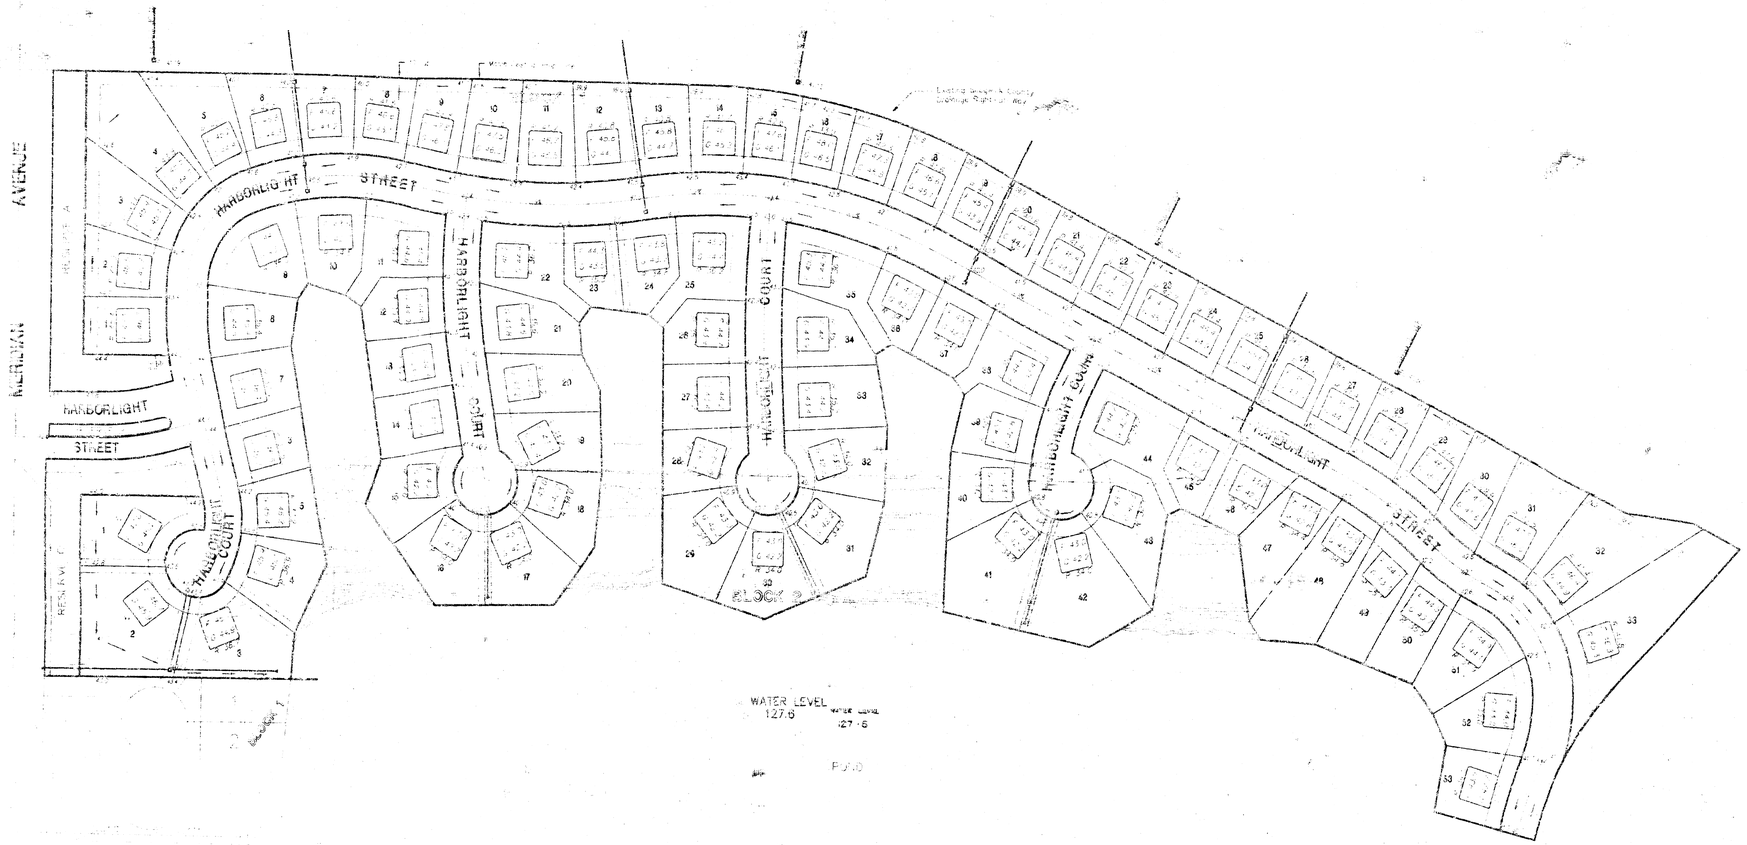

APPROVED
DRAINAGE PLAN

7/28/99

VICINITY MAP

NOTES:

LEGEND:

BENCHMARKS

LOT GRADING PLAN- REVISED

HARBOR ISLE 2ND ADDITION

TO WICHITA - SEDGWICK COUNTY, KANSAS

DATE: FEB. 1, 1999 REVISED 7/28/99

POE & ASSOCIATES OF KANSAS, INC.

HARBOR ISLE 2ND 7-28-99 Review