
JACOBUS ADDITION
(Drainage)

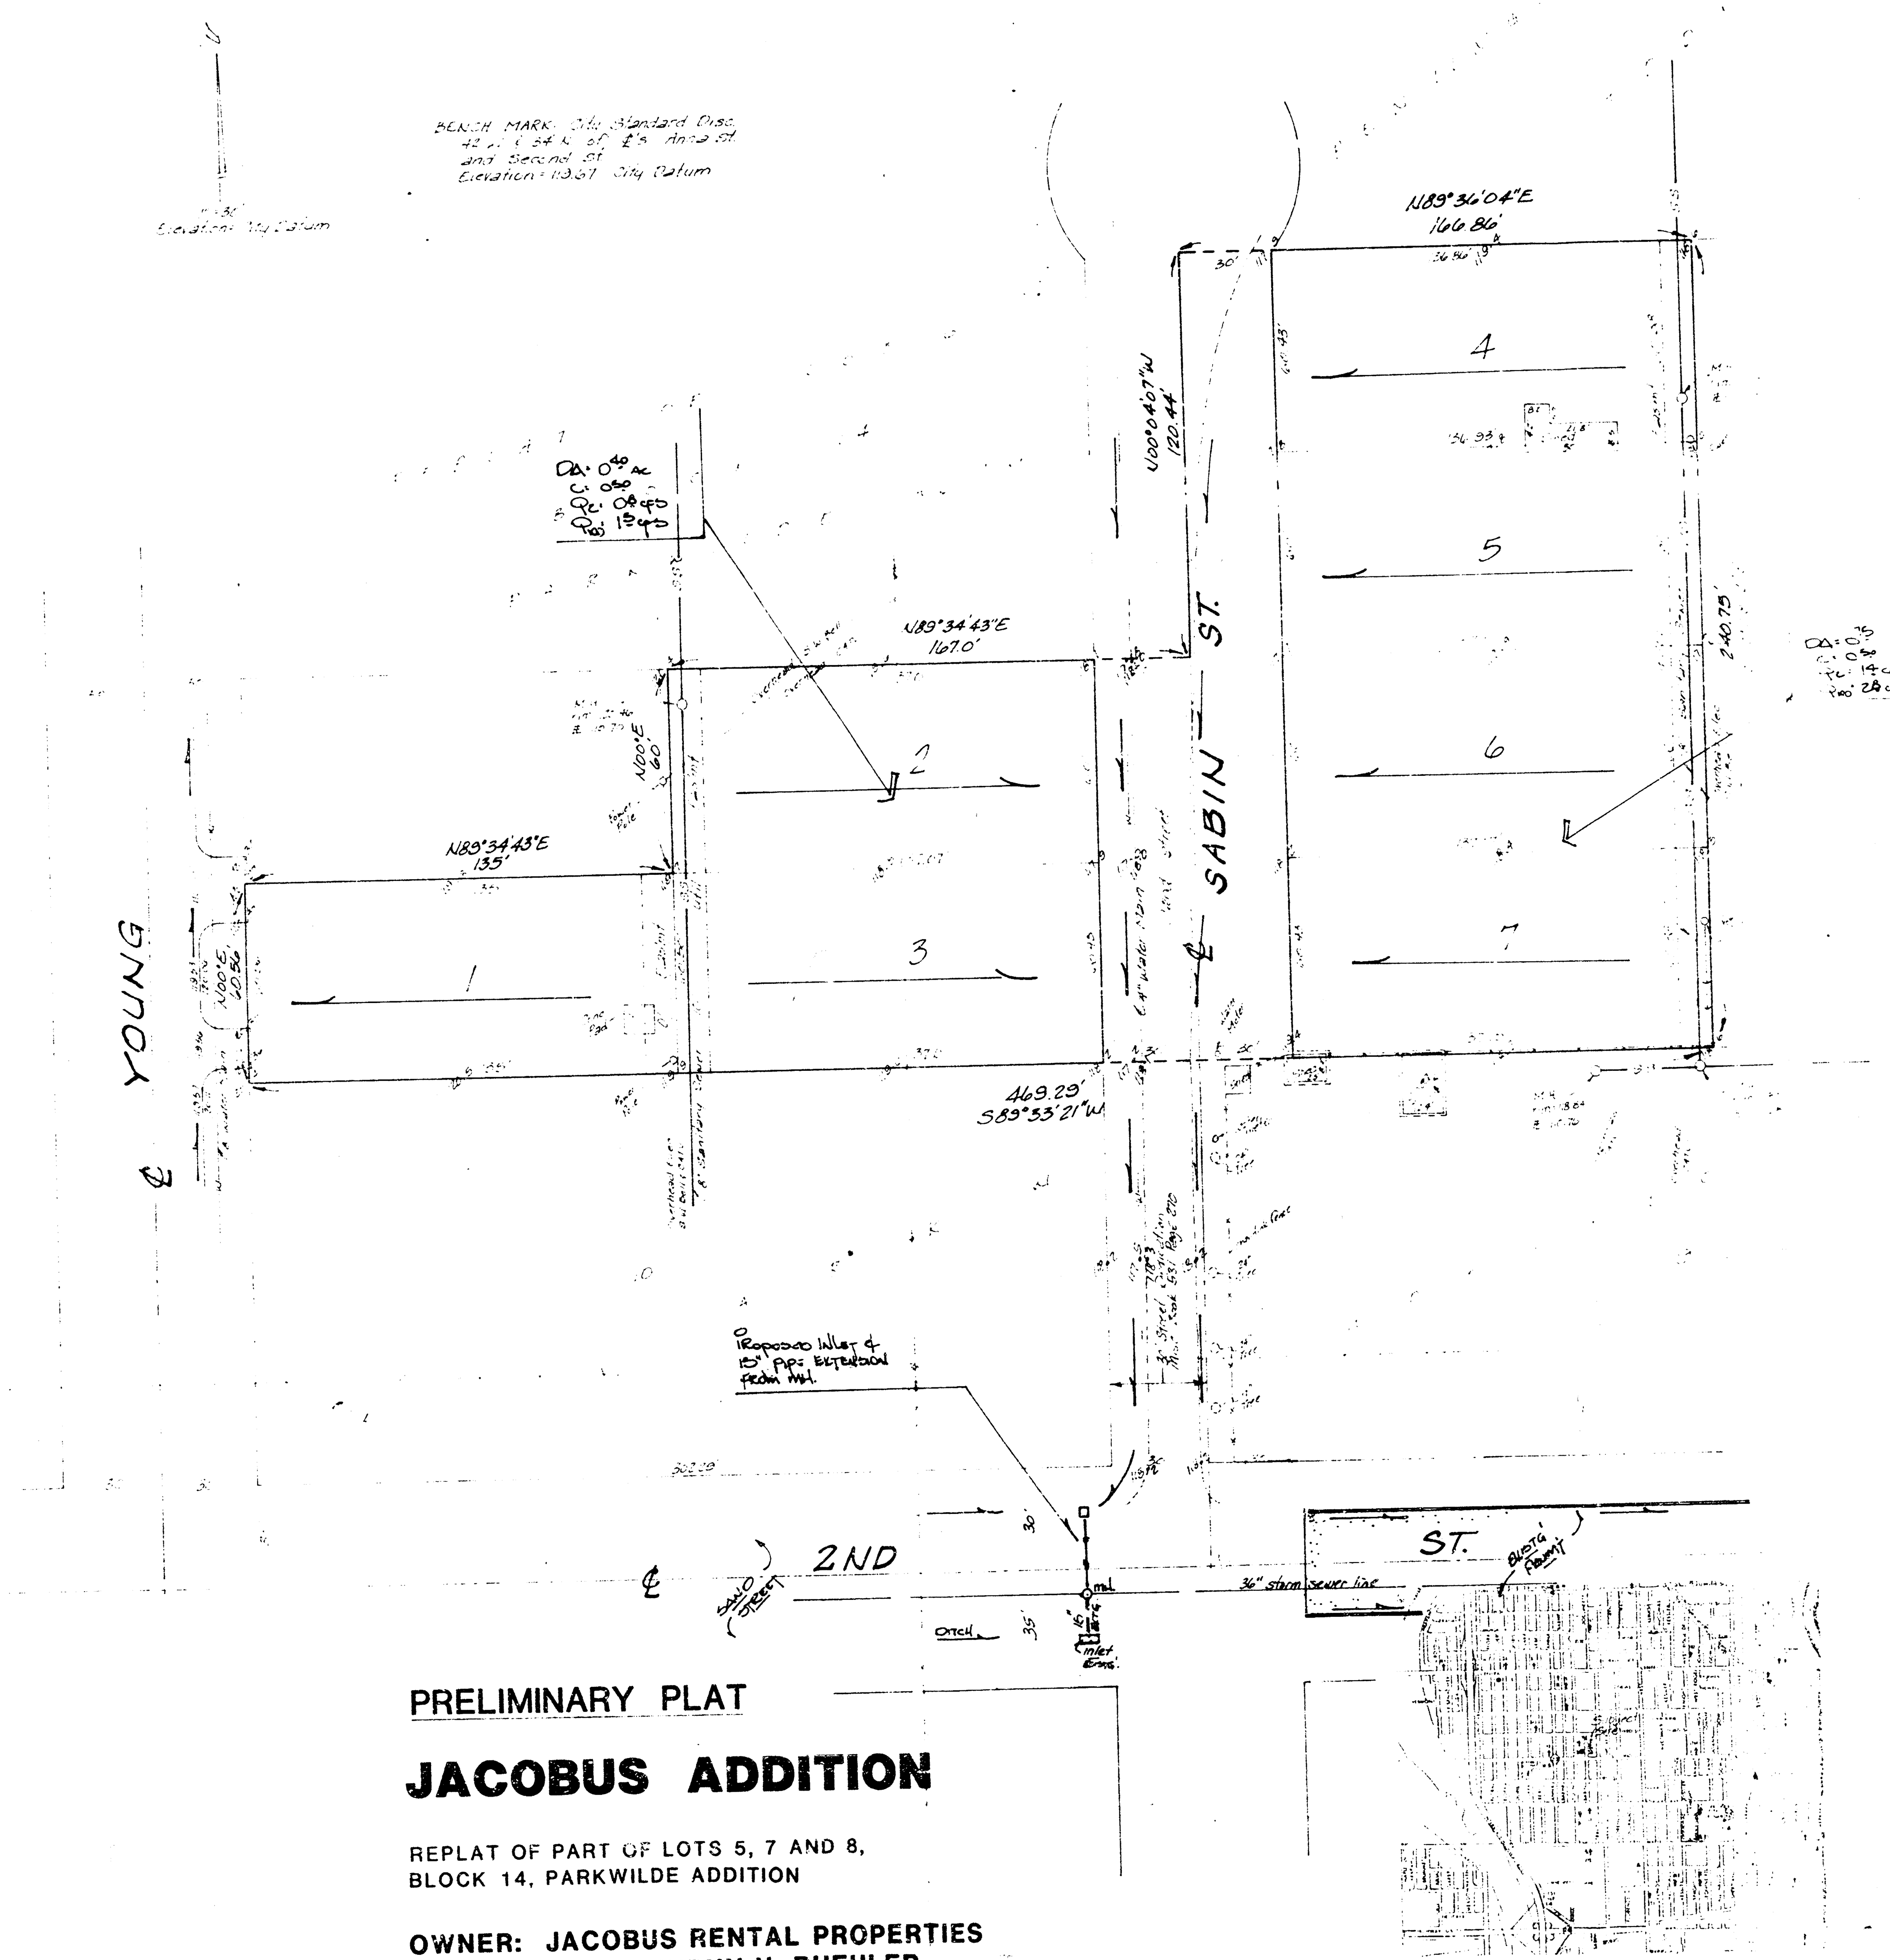

PRELIMINARY PLAT

JACOBUS ADDITION

REPLAT OF PART OF LOTS 5, 7 AND 8,
BLOCK 14, PARKWILDE ADDITION

OWNER: JACOBUS RENTAL PROPERTIES
c/o KATHRYN V. BUEHLER

DRAINAGE CONCEPT

BAUGHMAN COMPANY, P.A.
SURVEYING & ENGINEERING
316-262-7271 • 315 ELLIS • WICHITA, KANSAS