


WICHITA, SEDGWICK COUNTY, KANSAS

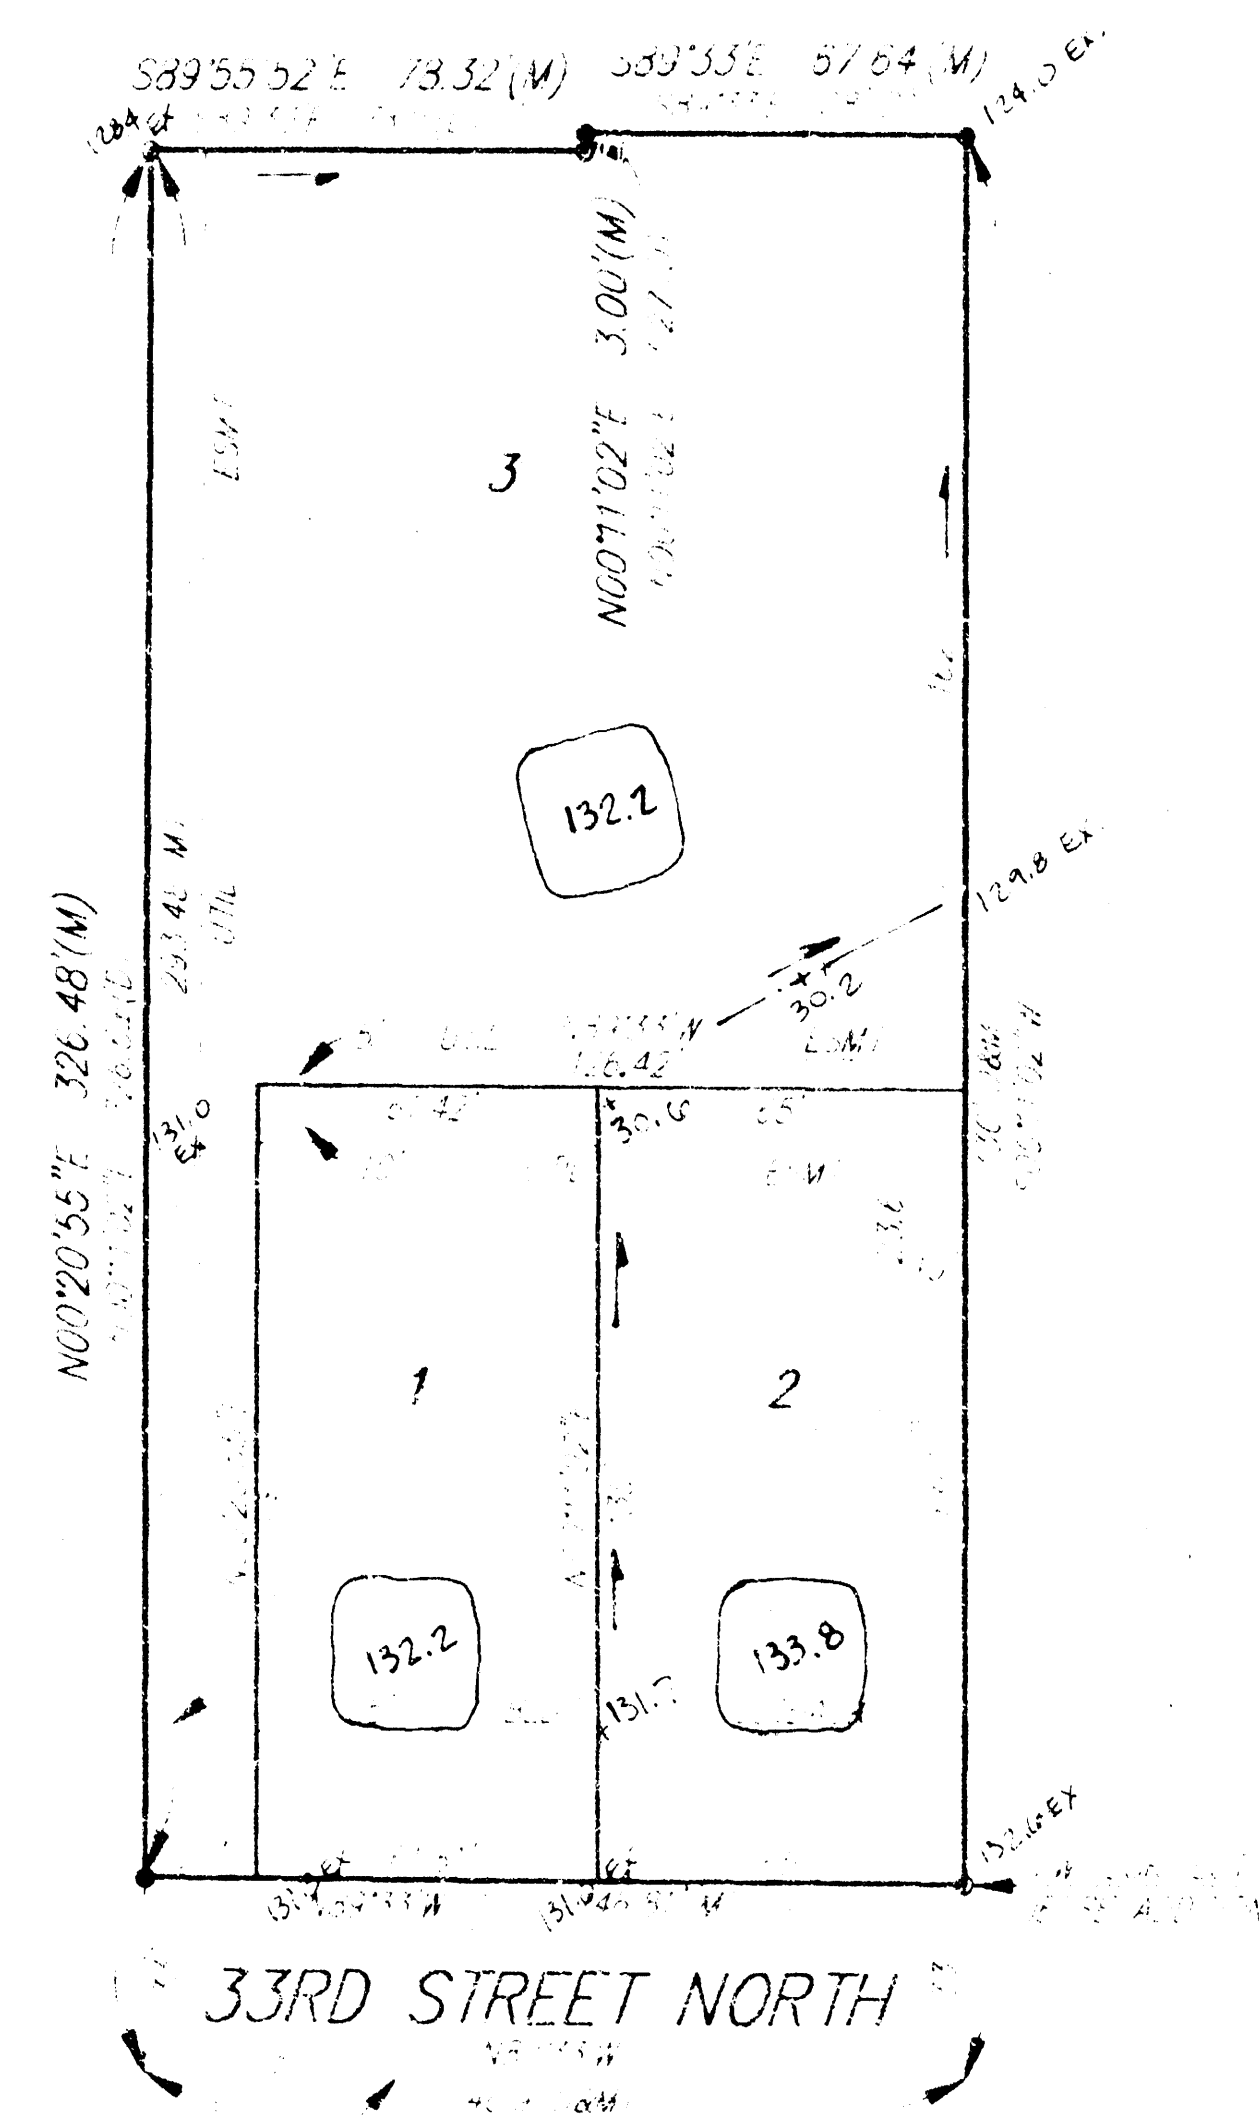


**APPROVED
DRAINAGE PLAN**

Subdivision Lot Grading Plan


June 7, 83



BAUGHMAN COMPANY P. A.
ENGINEERING & SURVEYING
316/262-7271 • 315 ELLIS • WICHITA, KANSAS 67203

WICHITA, SEDGWICK COUNTY, KANSAS

RICHARD P. JESSE
3201 WOODLAND
WICHITA, KS. 67204
PH: 833-4565

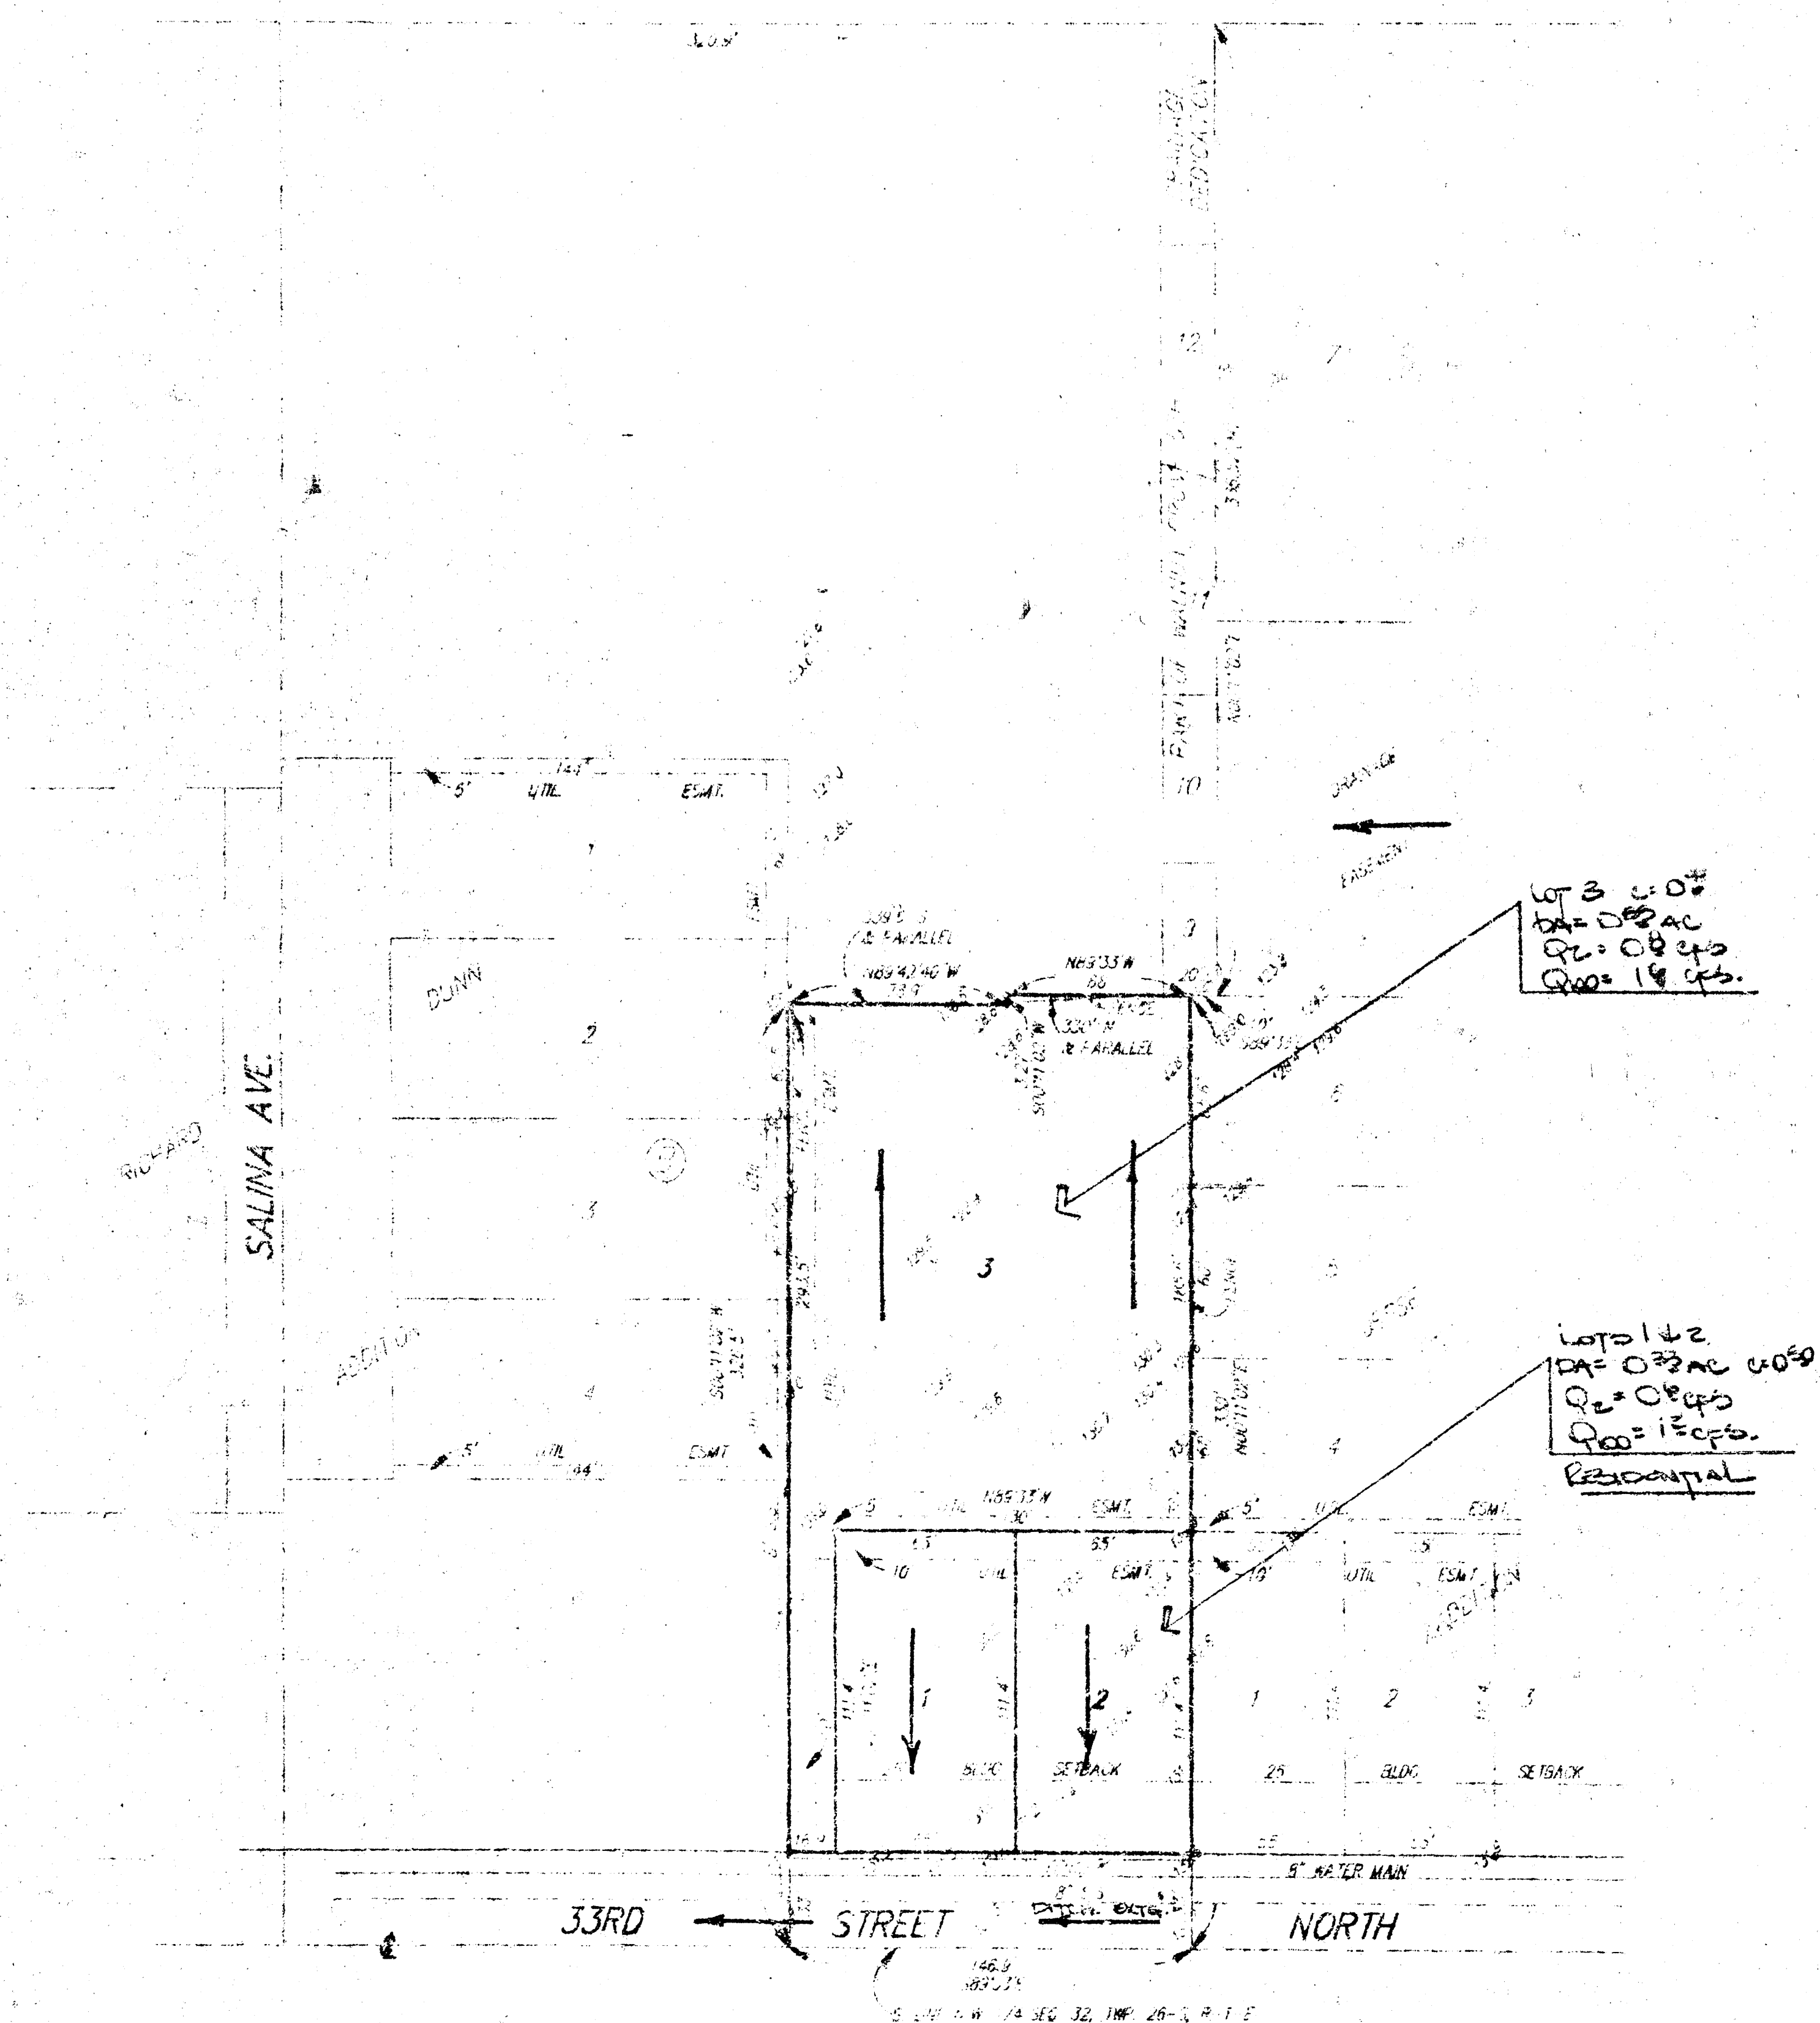

SCALE 1" = 50'
RA SPINE IN NW FACE
OF RR. 25' N. & 5' S.
ST. COR LOT 1, WALNUT
CRVE 3TH ADDITION
ELEV. = 13100

DRAINAGE PLAN



BAUGHMAN COMPANY P. A.
SURVEYING & ENGINEERING
316/262-7271 • 315 ELLIS • WORTH, KANSAS 67211