



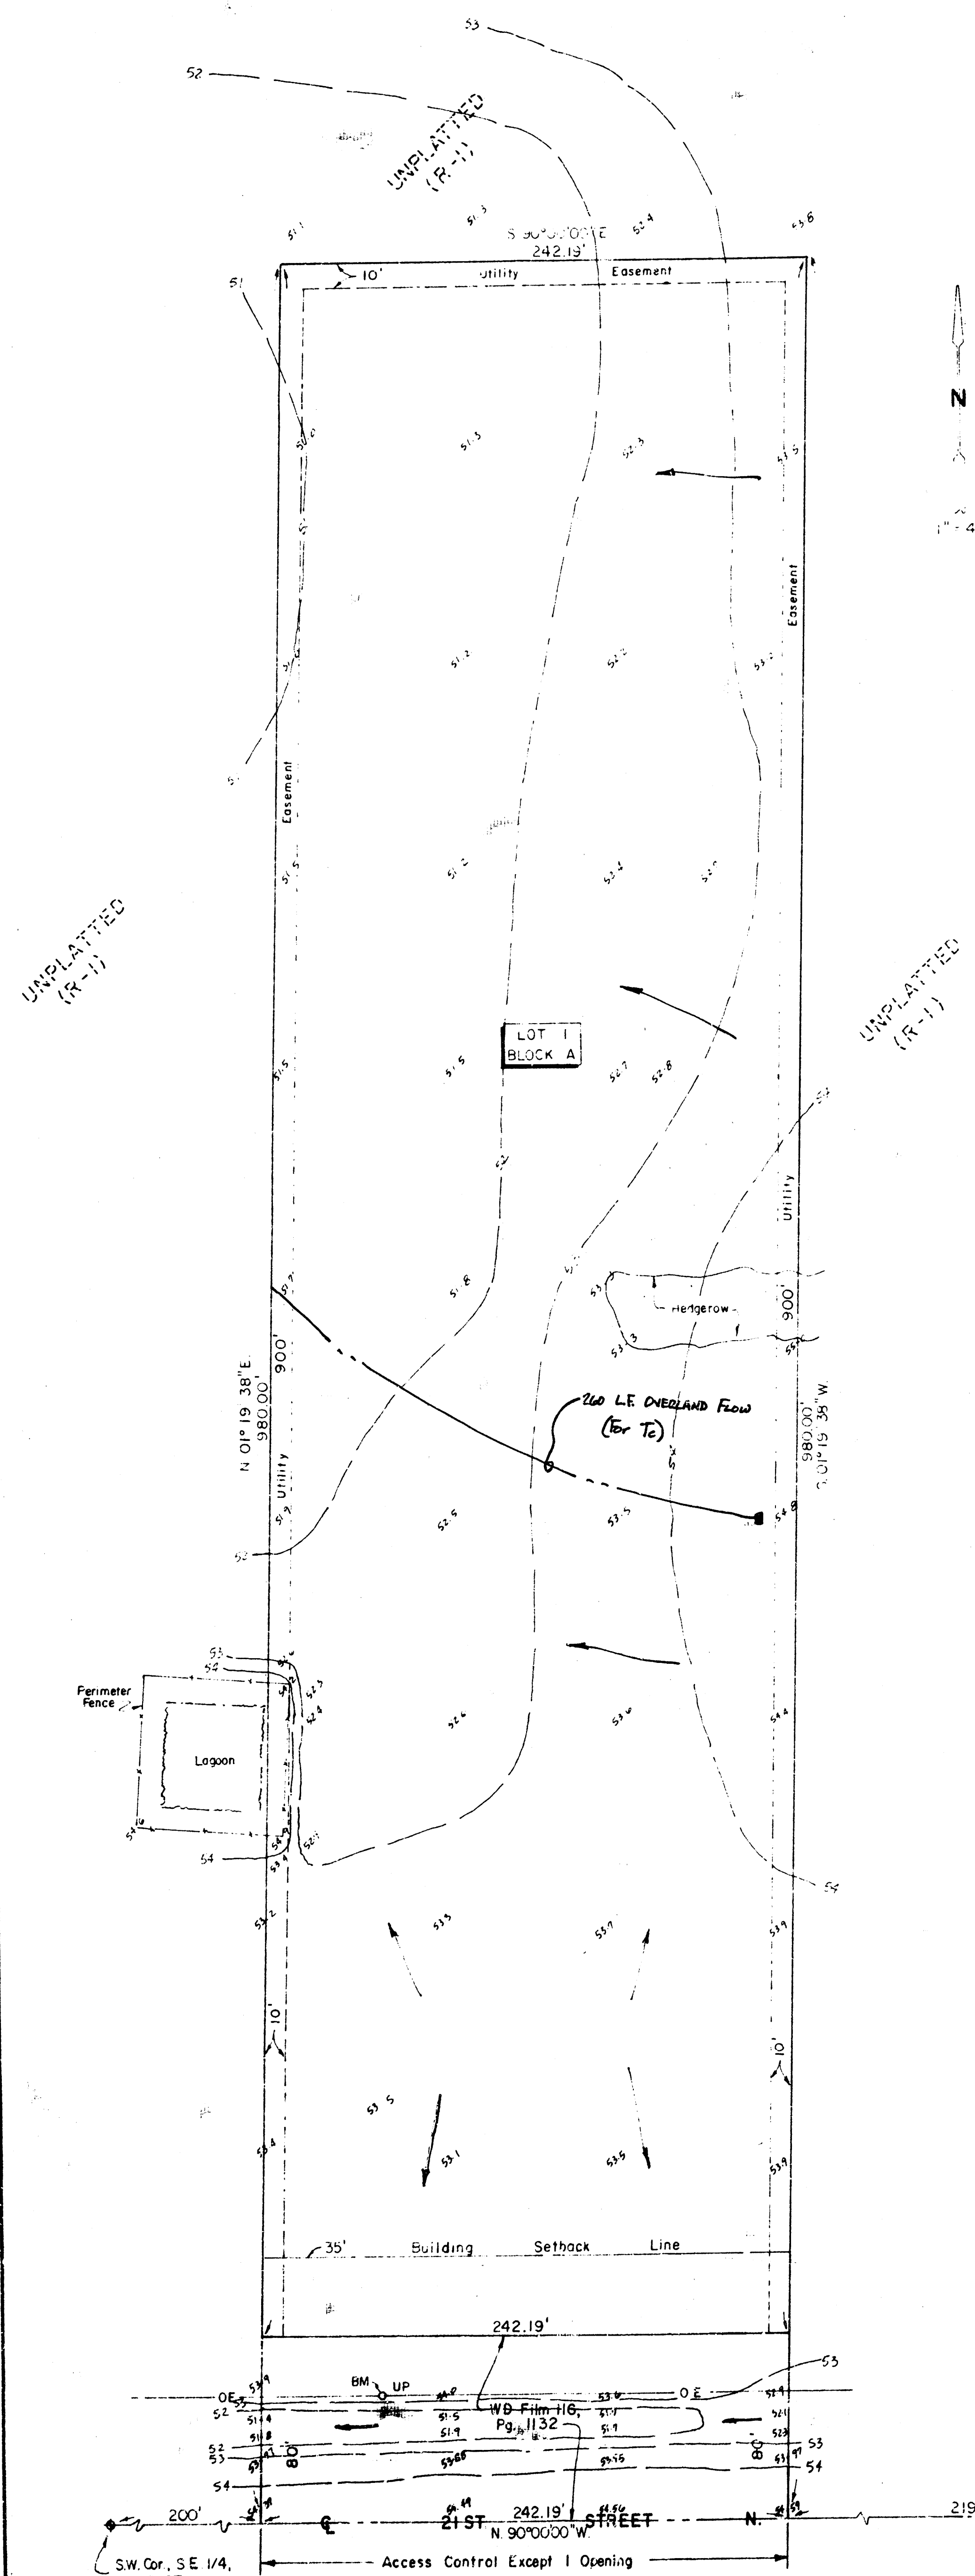

JACKIE KELLEY ADDITION WICHITA, SEDGWICK CO., KANSAS

- LEGAL DESCRIPTION -
BEGINNING AT A POINT 7.1945 FEET WEST OF THE SOUTHWEST CORNER OF THE SE 1/4 OF SECTION 6, TOWNSHIP 27 SOUTH, RANGE 1 WEST OF THE 6TH P.M., SEDGWICK COUNTY, KANSAS; THENCE WEST ALONG THE SOUTH LINE OF SAID SE 1/4, 242.19 FEET MORE OR LESS TO A POINT 200.0 FEET EAST OF THE SOUTHWEST CORNER OF SAID SE 1/4; THENCE NORTH 89.0 FEET; THENCE EAST PARALLEL TO THE SOUTH LINE OF SAID SE 1/4, A DISTANCE OF 242.19 FEET MORE OR LESS; THENCE SOUTH 89.0 FEET TO THE POINT OF BEGINNING, EXCEPT THE SOUTH 89.0 FEET THEREOF.

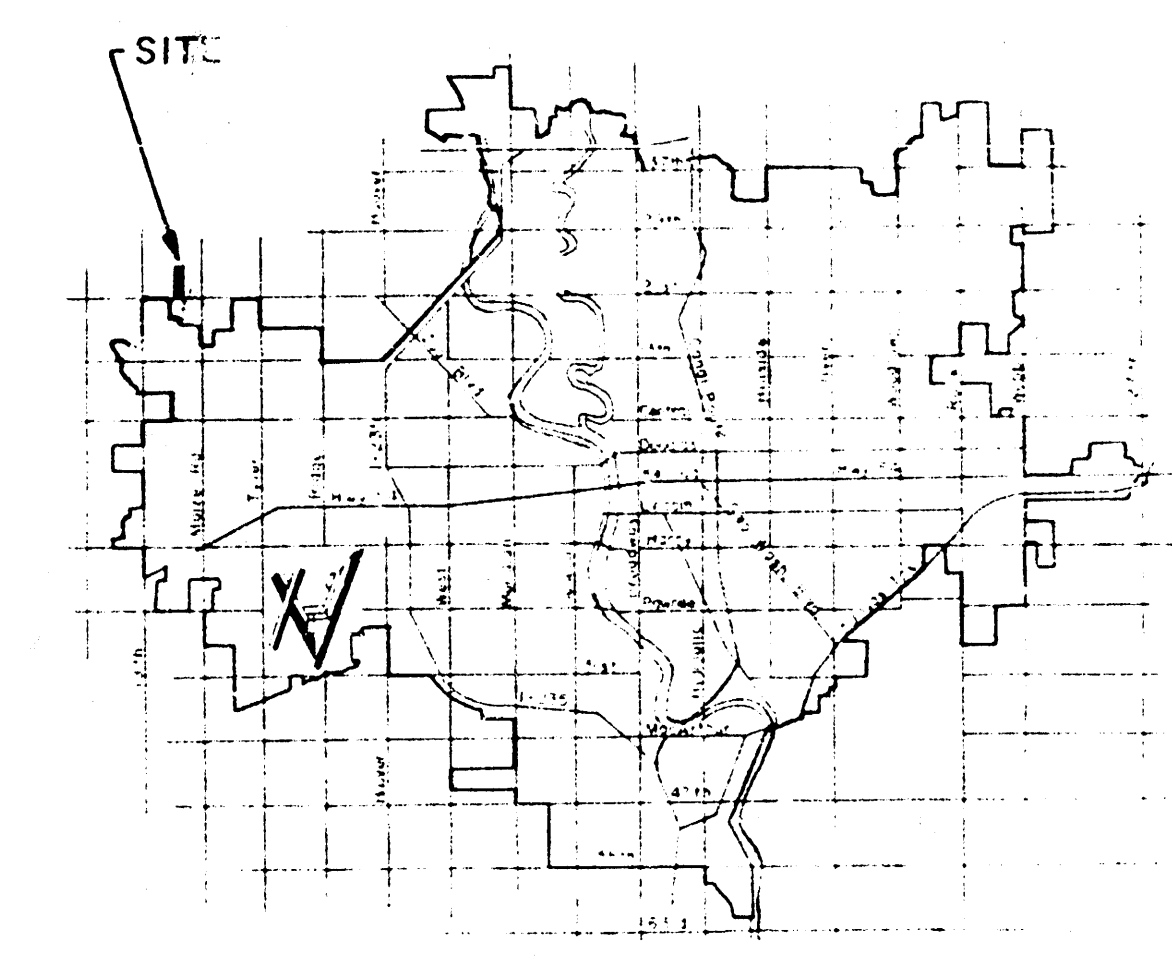

- BENCHMARK -
BM - 11 - Utility Pole, 65' E
of 11' N of S.W. Prop. Cor.
Elev. = 1354.34 M.S.L.
Note - Add 1300.00 to spot
elevations to convert to M.S.L.

**MOEHRING & ASSOCIATES
CONSULTING ENGINEERS
WICHITA
JUNE, 1991**