


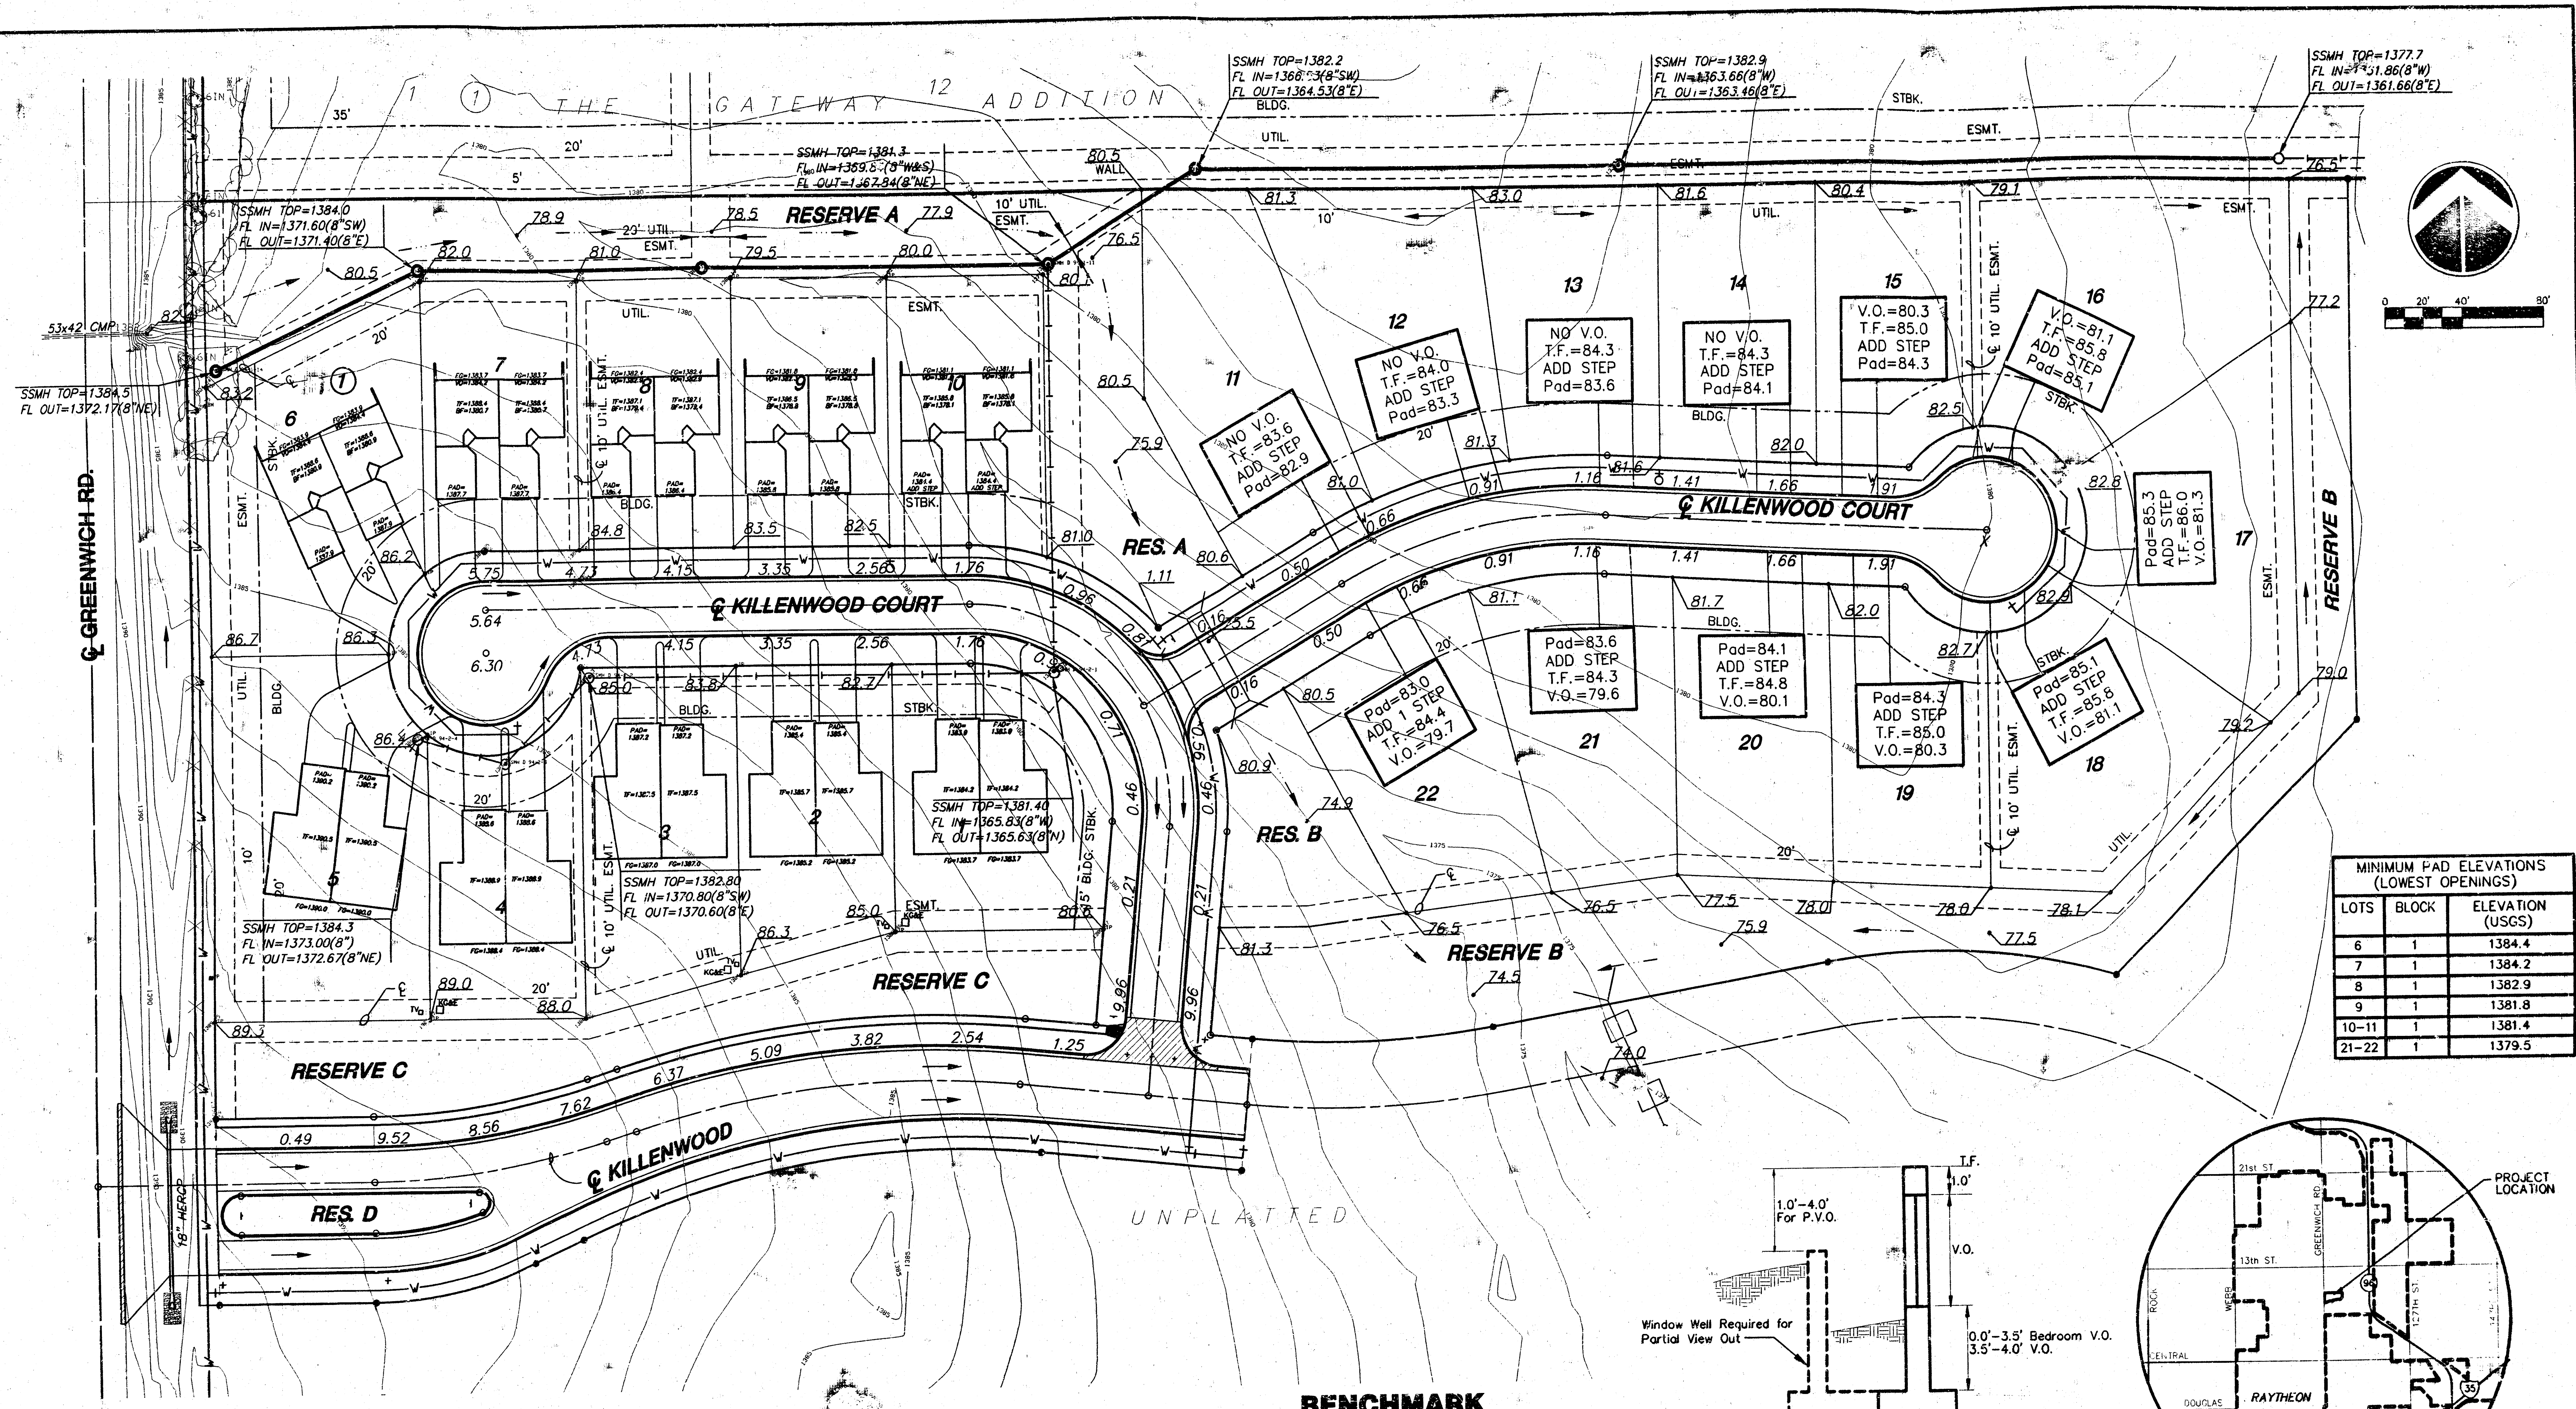


MINIMUM PAD ELEVATIONS (LOWEST OPENINGS)		
LOTS	BLOCK	ELEVATION (USGS)
6	1	1384.4
7	1	1384.2
8	1	1382.9
9	1	1381.8
10-11	1	1381.4
21-22	1	1379.5

GRADING PLAN **KILLENWOOD POINTE ADDITION**

REVISED: DECEMBER 2001 (LOTS 1-10)
DATE: AUGUST 2000

OWNERS/DEVELOPER: KISER GATEWAY, LLC & WILLARD J. KISER PROPERTIES, LLC.

APPROVED
DRAINAGE PLAN

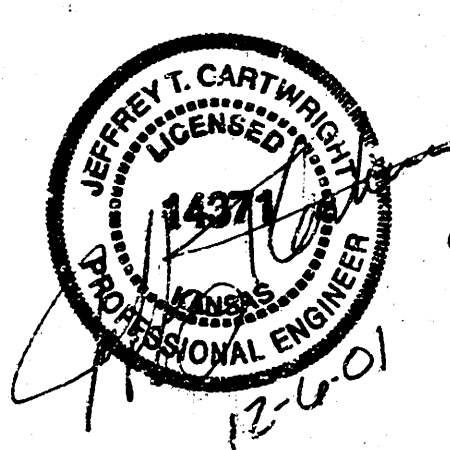

MKEC
ENGINEERING
CONSULTANTS, INC.
 411 N. WEBB ROAD
 WICHITA, KS. 67206
 316-684-9600

H:\CIVIL\00082\UNPL\GRAD\00082D.DWG Thu Dec 06 11:33:44 2001