


LANDSOWNE ADDITION
(Drainage)

SKETCH PLAT
PRELIMINARY PLAT OF
LANDSOWNE ADDITION

OWNER: R. P. Lansdowne and Sharon L. Lansdowne
2526 E. Central
Wichita, Ks.

ENGINEER: P.E.C. p.a.
1440 English
Wichita, Ks.

1" = 30'

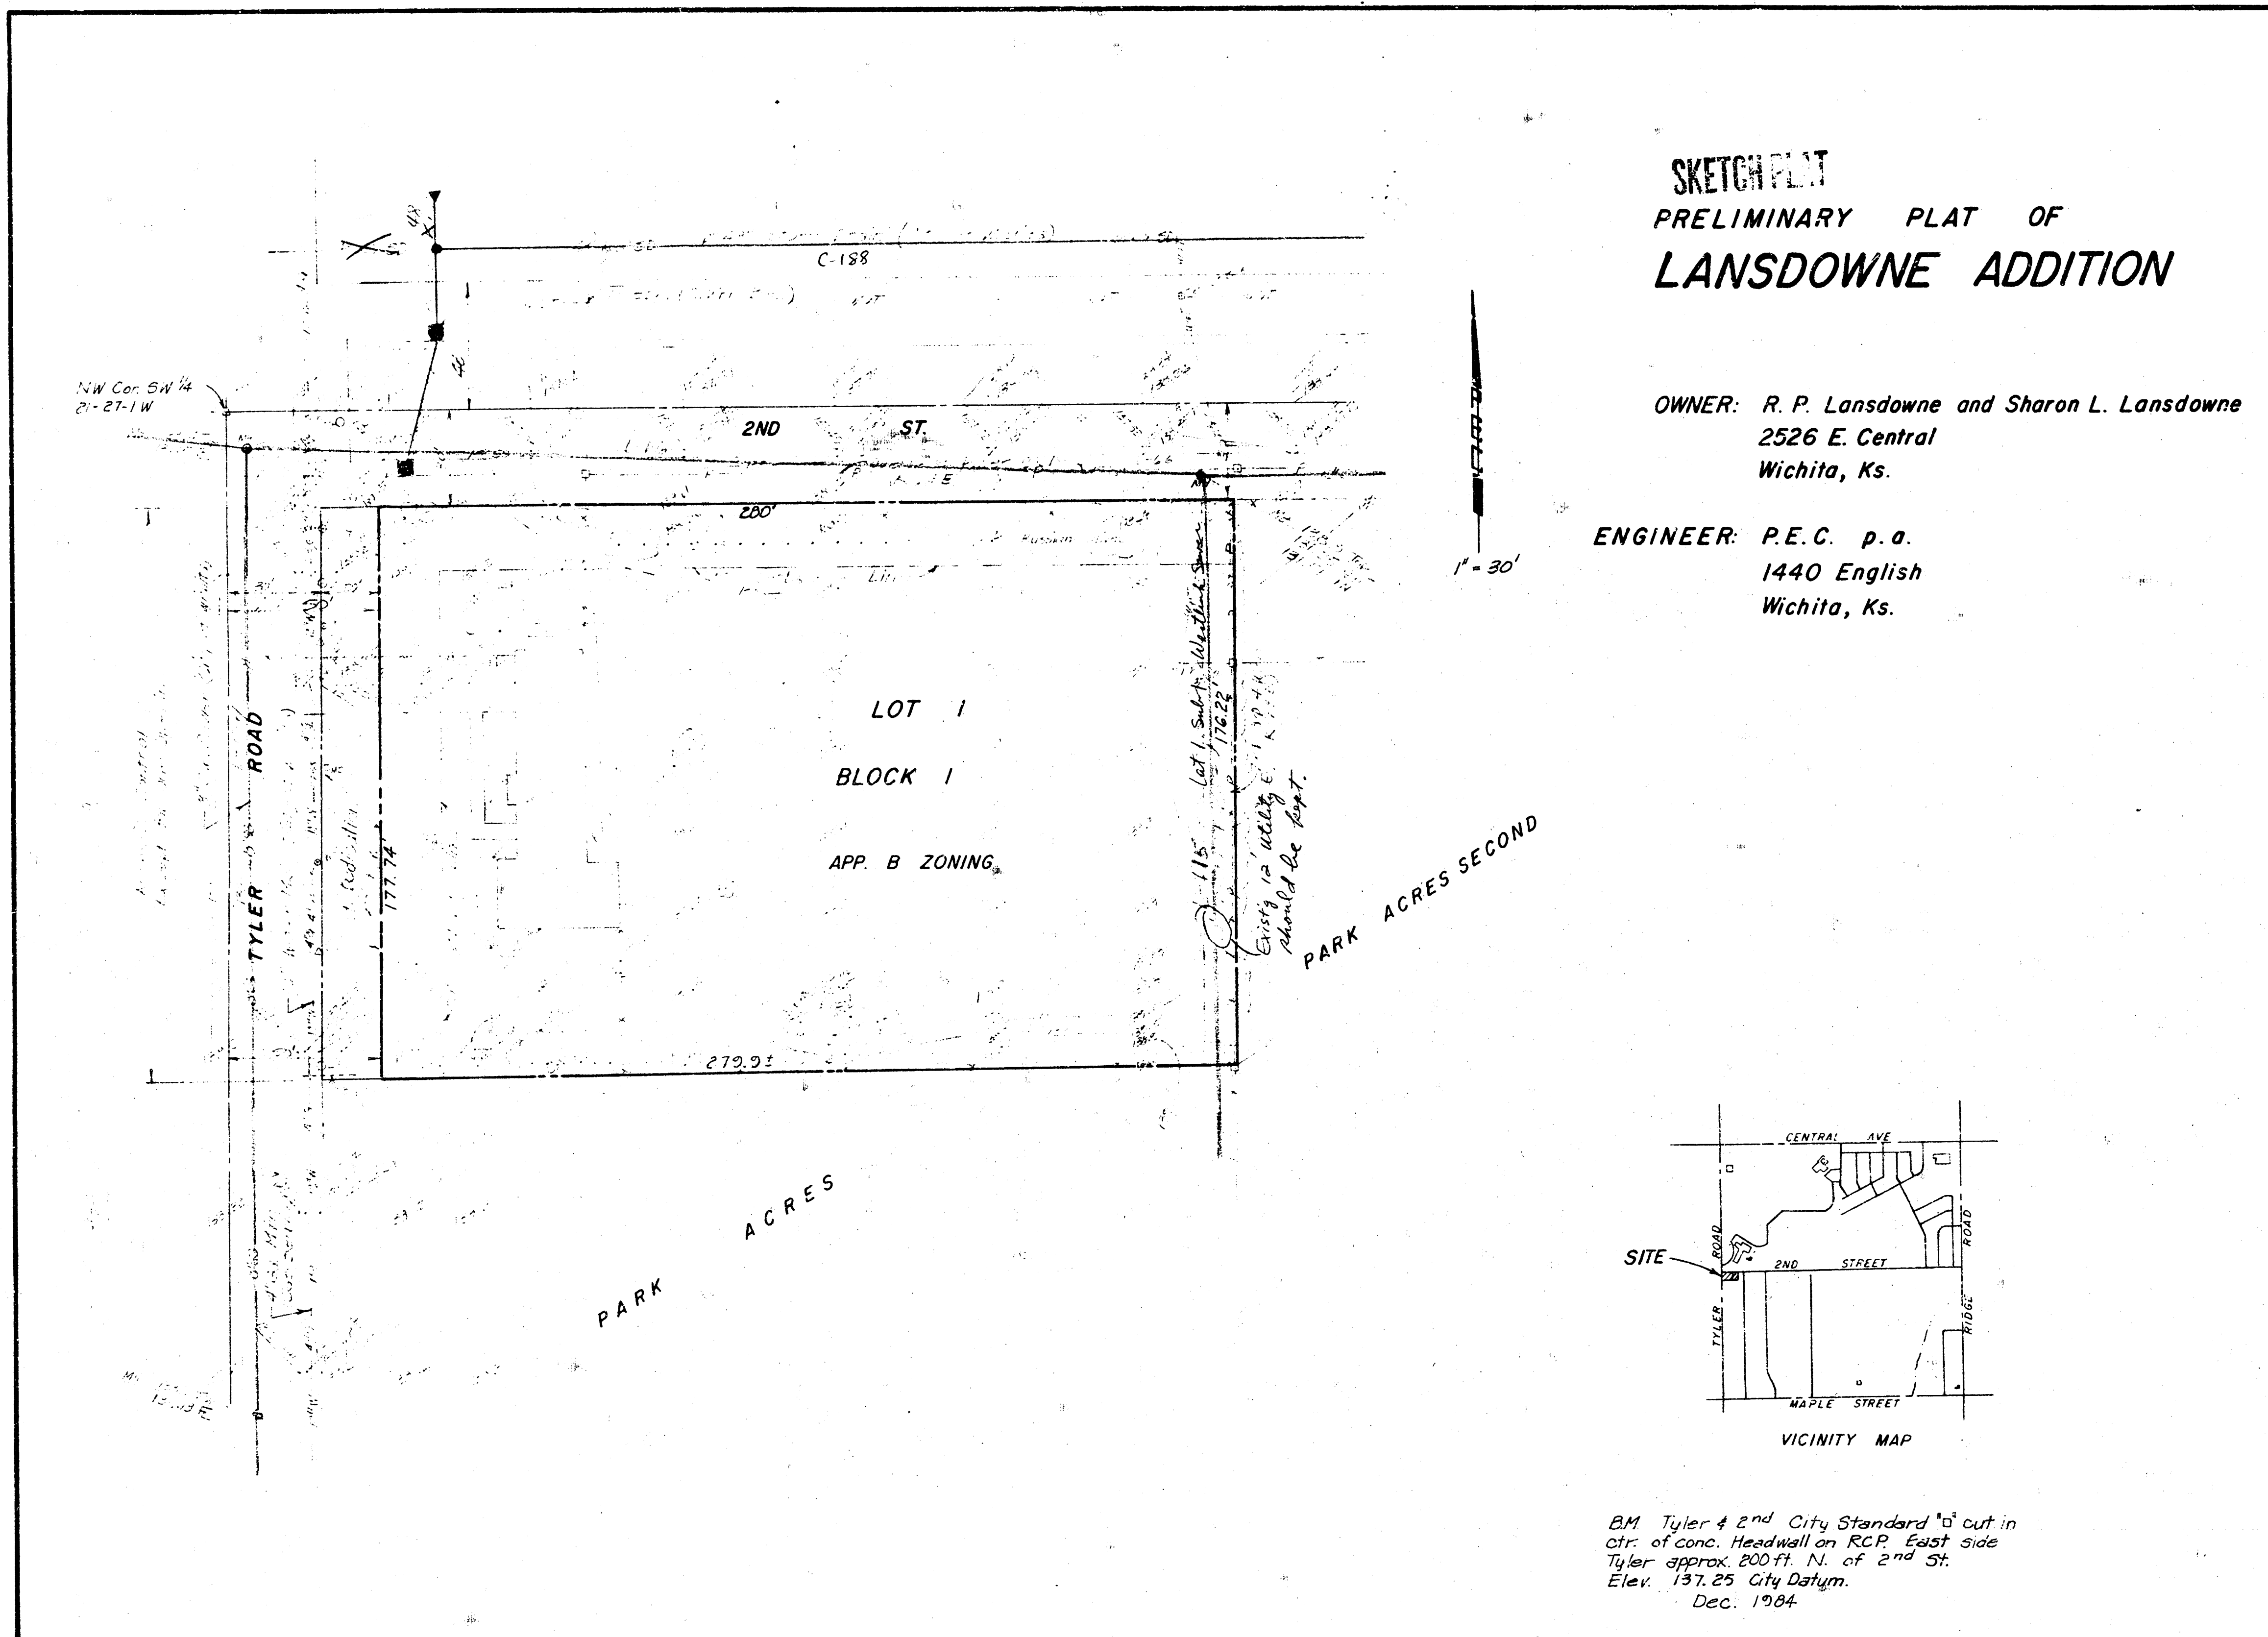

Elev. 137.25 City Datum.
Dec. 1984