

MINIMUM PAD ELEVATION FOR  
LOWEST OPENING INTO STRUCTURES  
LOTS 1-5, BLOCK 1: 1281.9 MSL  
LOTS 1-15, BLOCK 2: 1281.9 MSL

**NOTES:**

1. THIS PLAT TO DRAIN TO 44TH ST. S. AND TO RESERVES C & D, THE LEGACY ADDITION, AS SHOWN ON THE GRADING PLAN FOR PHASE 1, THE LEGACY ADDITION, REVISED 4/7/00 BY MKEC.
2. TOP OF CURB GRADES SHOWN ARE FOR FULL CURB. ROLL-TYPE CURB IS TO BE CONSTRUCTED.
3. REFER TO STORM WATER POLLUTION PREVENTION PLAN ON FILE IN THE OFFICE OF THE CITY ENGINEER.



SCALE 1" = 50'

**APPROVED  
DRAINAGE PLAN**

City of Wichita Benchmark:  
44' north and 30' east of 1/4 Sec. Cor. @ Meridian and  
43rd St. South. Elev. 1280.80 (M.S.L.)

On-Site Bench Marks:  
Square Cut, Top of south curb of 44th St. S. at the  
N.E. Cor. of Lot 1, Block 2, Legacy 2nd Addition.  
Elev. 1280.76 (M.S.L.)


Square Cut, Top of north curb 44th St. S.  
at the west line of Lot 1, Block 1, Legacy 2nd  
Addition. Elev. 1282.36 (M.S.L.)

REVISED FOR ROLL TYPE CURB 8-9-01

**LEGACY 2ND ADDITION  
DRAINAGE AND LOT GRADING PLAN  
WICHITA, KANSAS**

<b>SRB</b>	824 NORTH MAIN WICHITA, KANSAS 67203 www.srb1.com	316-264-8008 FAX 264-4821 E-mail: srb@srb1.com
	<b>SAVOY, RUGGLES &amp; BOHM, P.A. ENGINEERING &amp; SURVEYING</b>	
PROJECT NUMBER		
DESIGN TCR	DRAWN JTS	UTILITY REVIEW
DATE July 6, 2001	DATE Aug. 9, 2001	REVISED Aug. 9, 2001

SHEET 1 OF 1

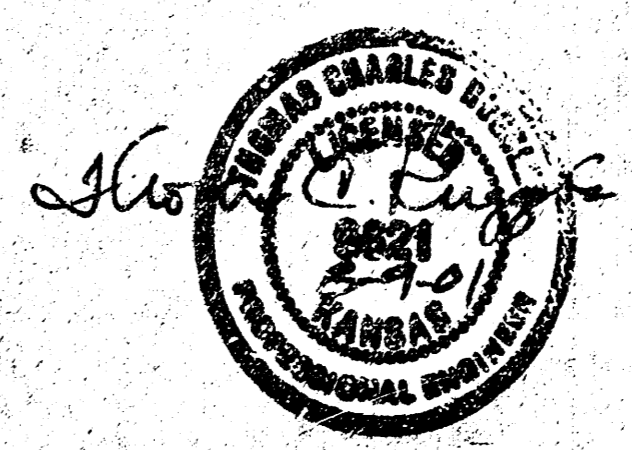

Rat Card 1996100 - 26 SUPP 2001