

BAUGHMAN COMPANY, P.A.
SURVEYING & ENGINEERING
316/262-7271 • 330 LAURA • WICHITA, KANSAS 67211


CONFIRMATION
MEMO

PROJECT: LOYD ADDITION
JOB NO.:
TO: Chris Breitenstein
FROM: R. Wooten
REFERENCE: Drainage plan.

DATE: 10-31-83
COPIES TO:

Final plat is scheduled for subdivision for Nov. 10, 1983.
The lot will drain east to West St. thru drives or flumes.
The lot will be developed for LC development. Runoff factor
will be 0.85. West St. drains south to an existing inlet
located at 3rd Street and a SMS in West St.

drainage plan

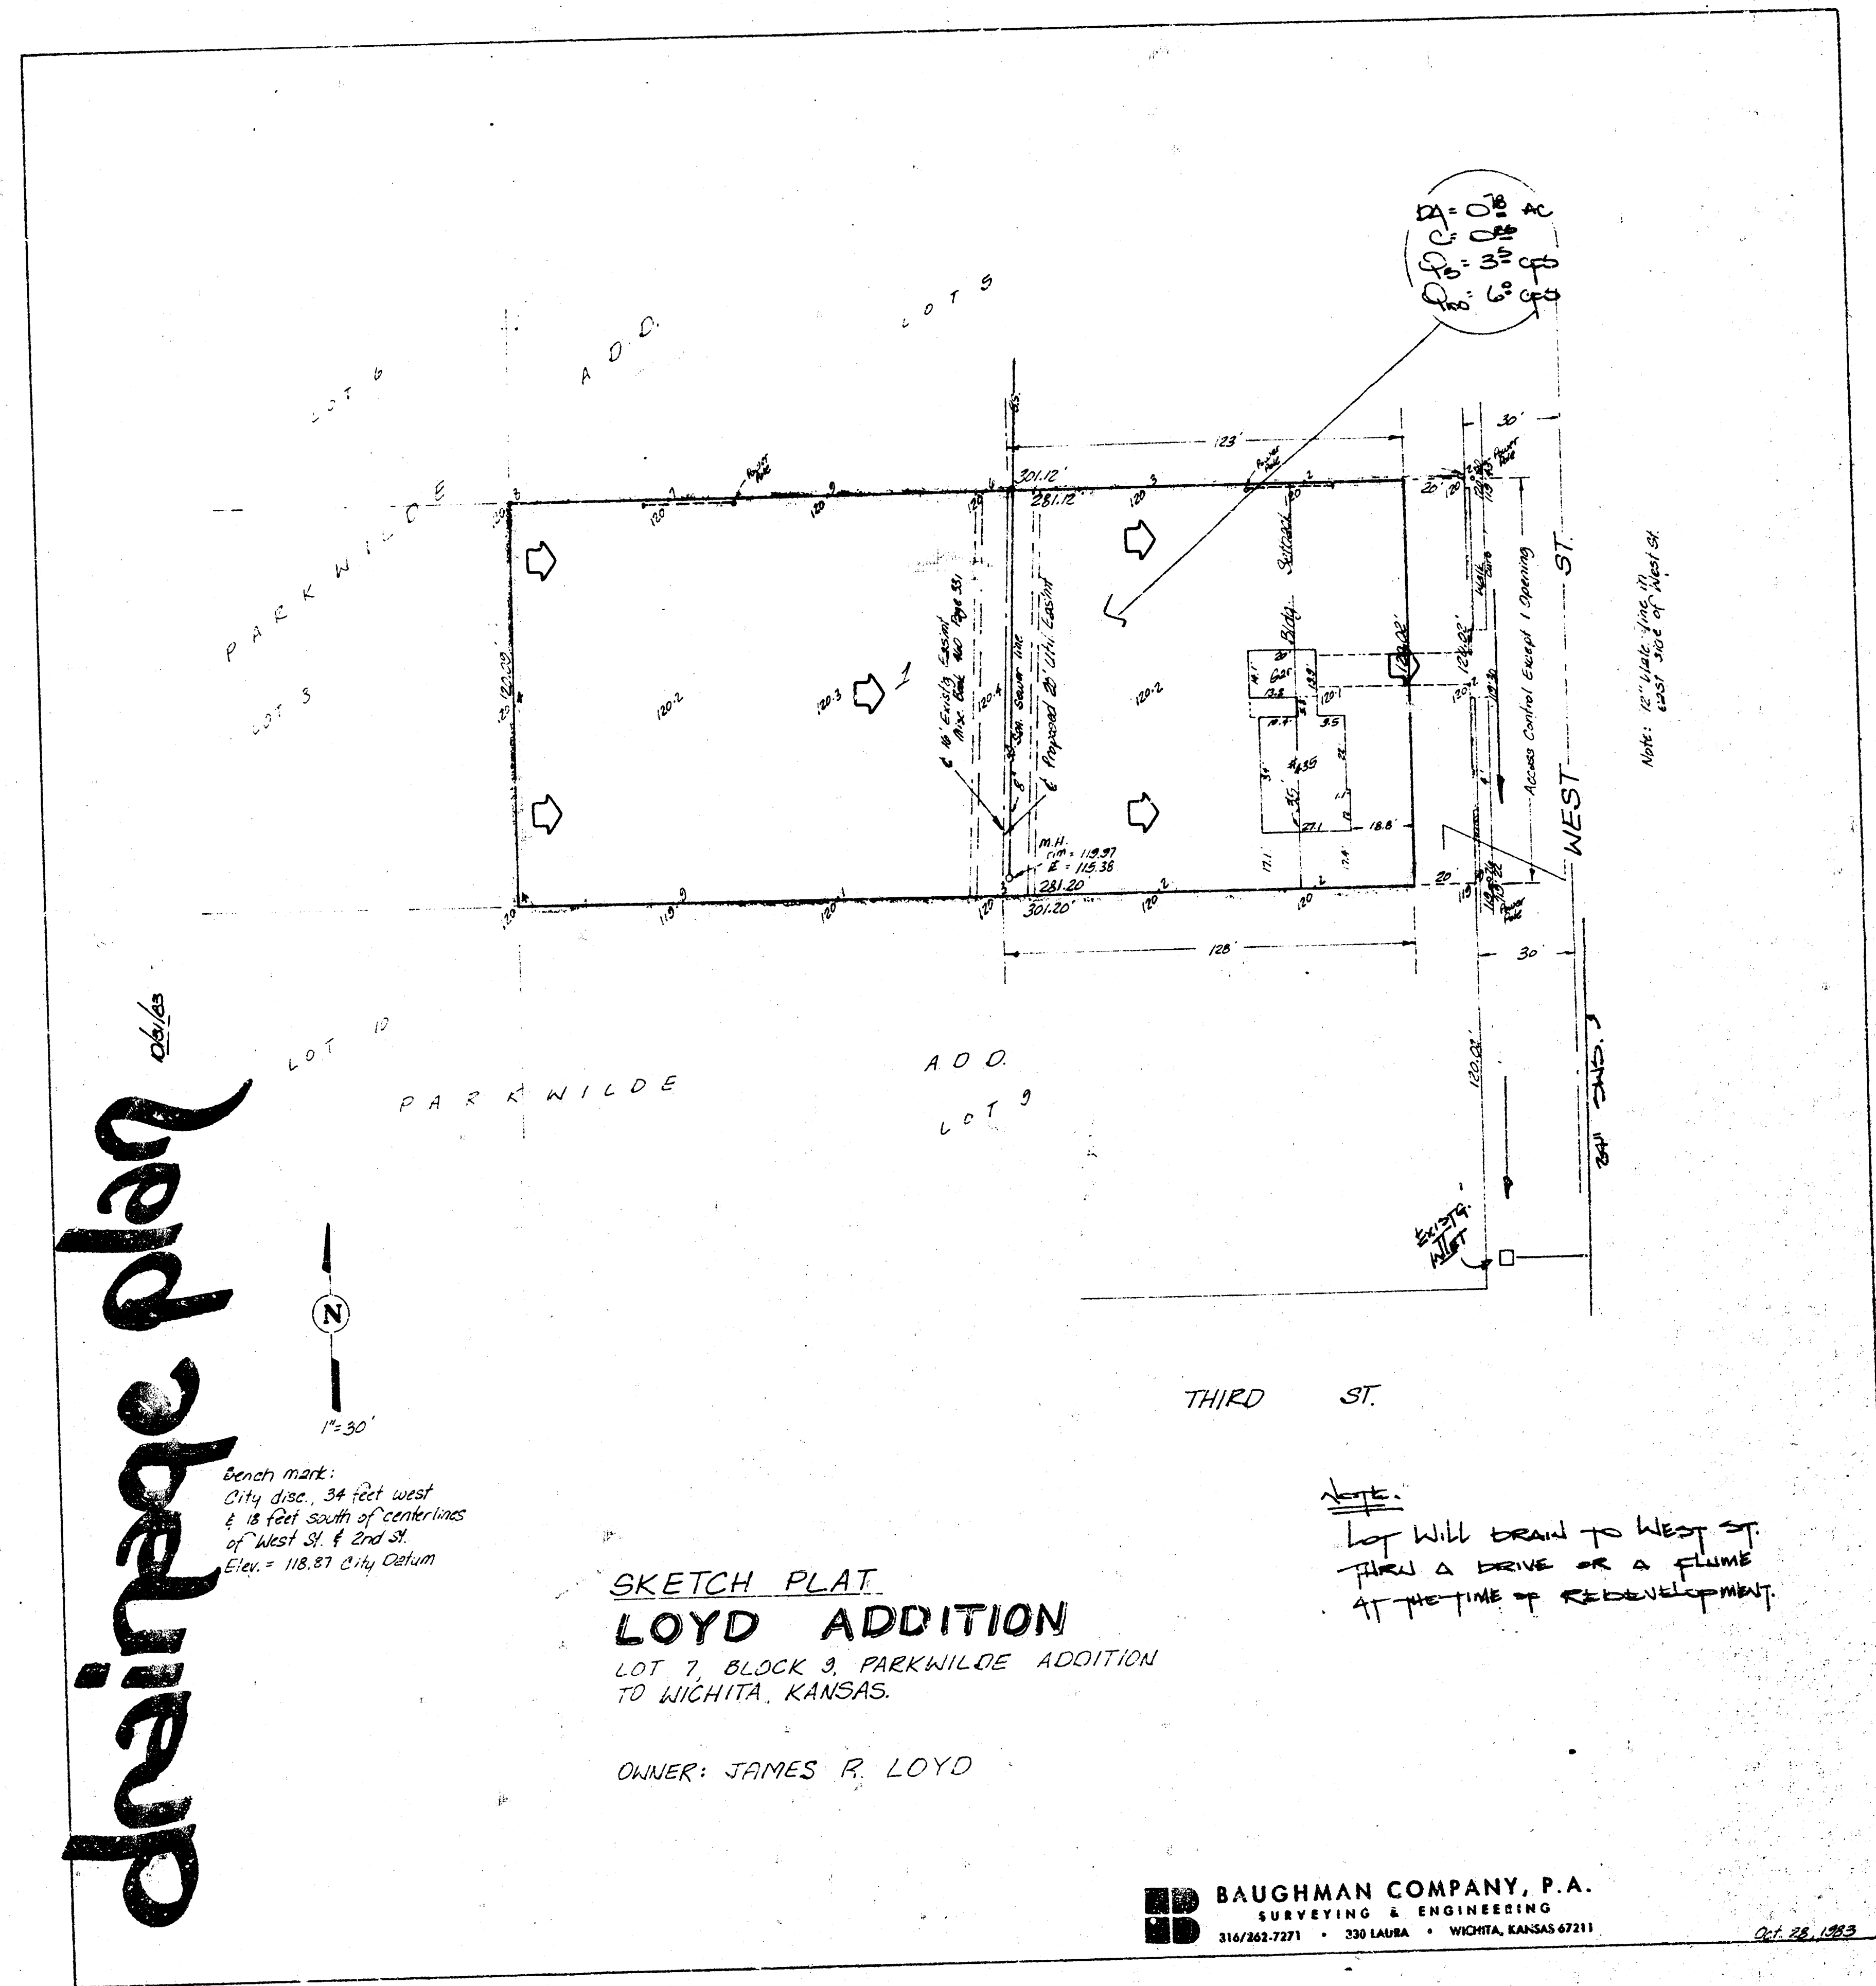

BAUGHMAN COMPANY, P.A.
SURVEYING & ENGINEERING
316/262-7271 • 330 LAURA • WICHITA, KANSAS 67211