
Maple Lane 5th

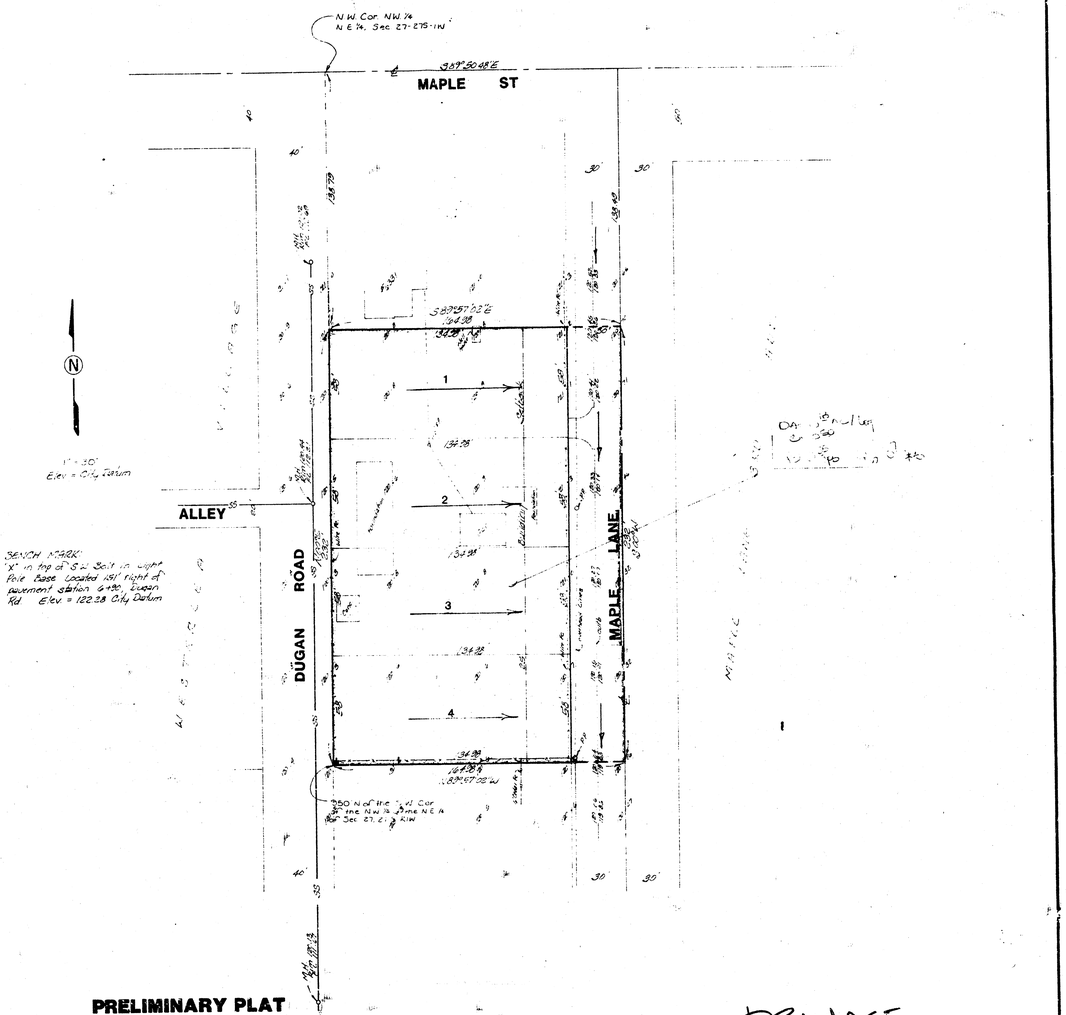

PRELIMINARY PLAT

MAPLE LANE 5TH ADDITION

THE WEST 5 ACRES OF THE N.W. 1/4 OF THE N.E. 1/4 OF SEC. 27, TWP. 27-S, R-1-E OF THE 6TH P. M., SEDGWICK COUNTY, KANSAS, EXCEPT THE SOUTH [illegible] FEET THEREOF.

OWNER: RICK THOMPSON

DRAINAGE PLAN

Waived

BAUGHMAN COMPANY, P.A.
SURVEYING & ENGINEERING
316/262-7271 • 315 ELLIS • WICHITA, KANSAS 67211

18 MAY 89