MARCUS AND LOGAN ADDITION
(Drainage)

B.M.: ELEV. 1298.7 - "a" CHISELED ON NW COR. BRIDGE AT MAPLE & BIG DITCH.

TOPO MADE DEC. 1984.

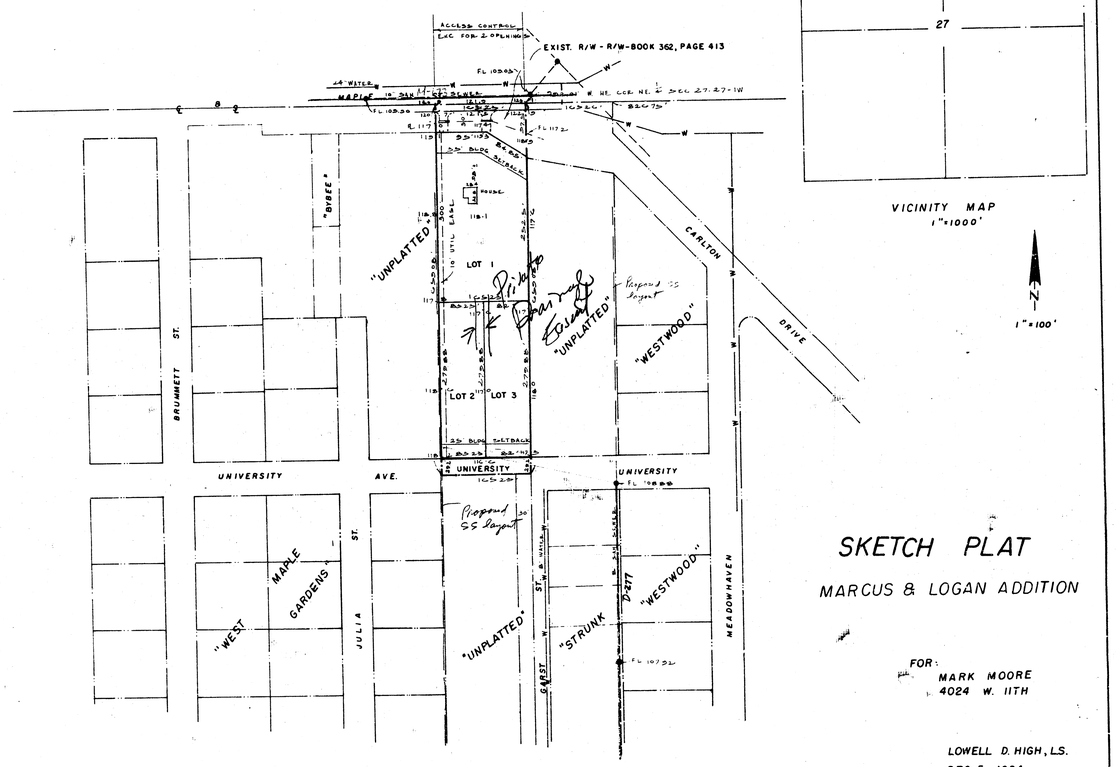

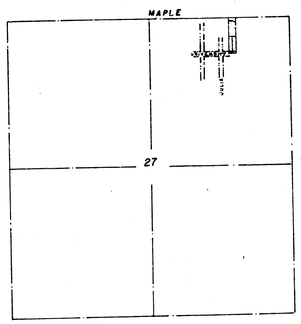

VICINITY MAP
1"=1000'

N
1"=100'

SKETCH PLAT

MARCUS & LOGAN ADDITION

FOR:
MARK MOORE
4024 W. 11TH

LOWELL D. HIGH, L.S.
DEC. 5, 1984