
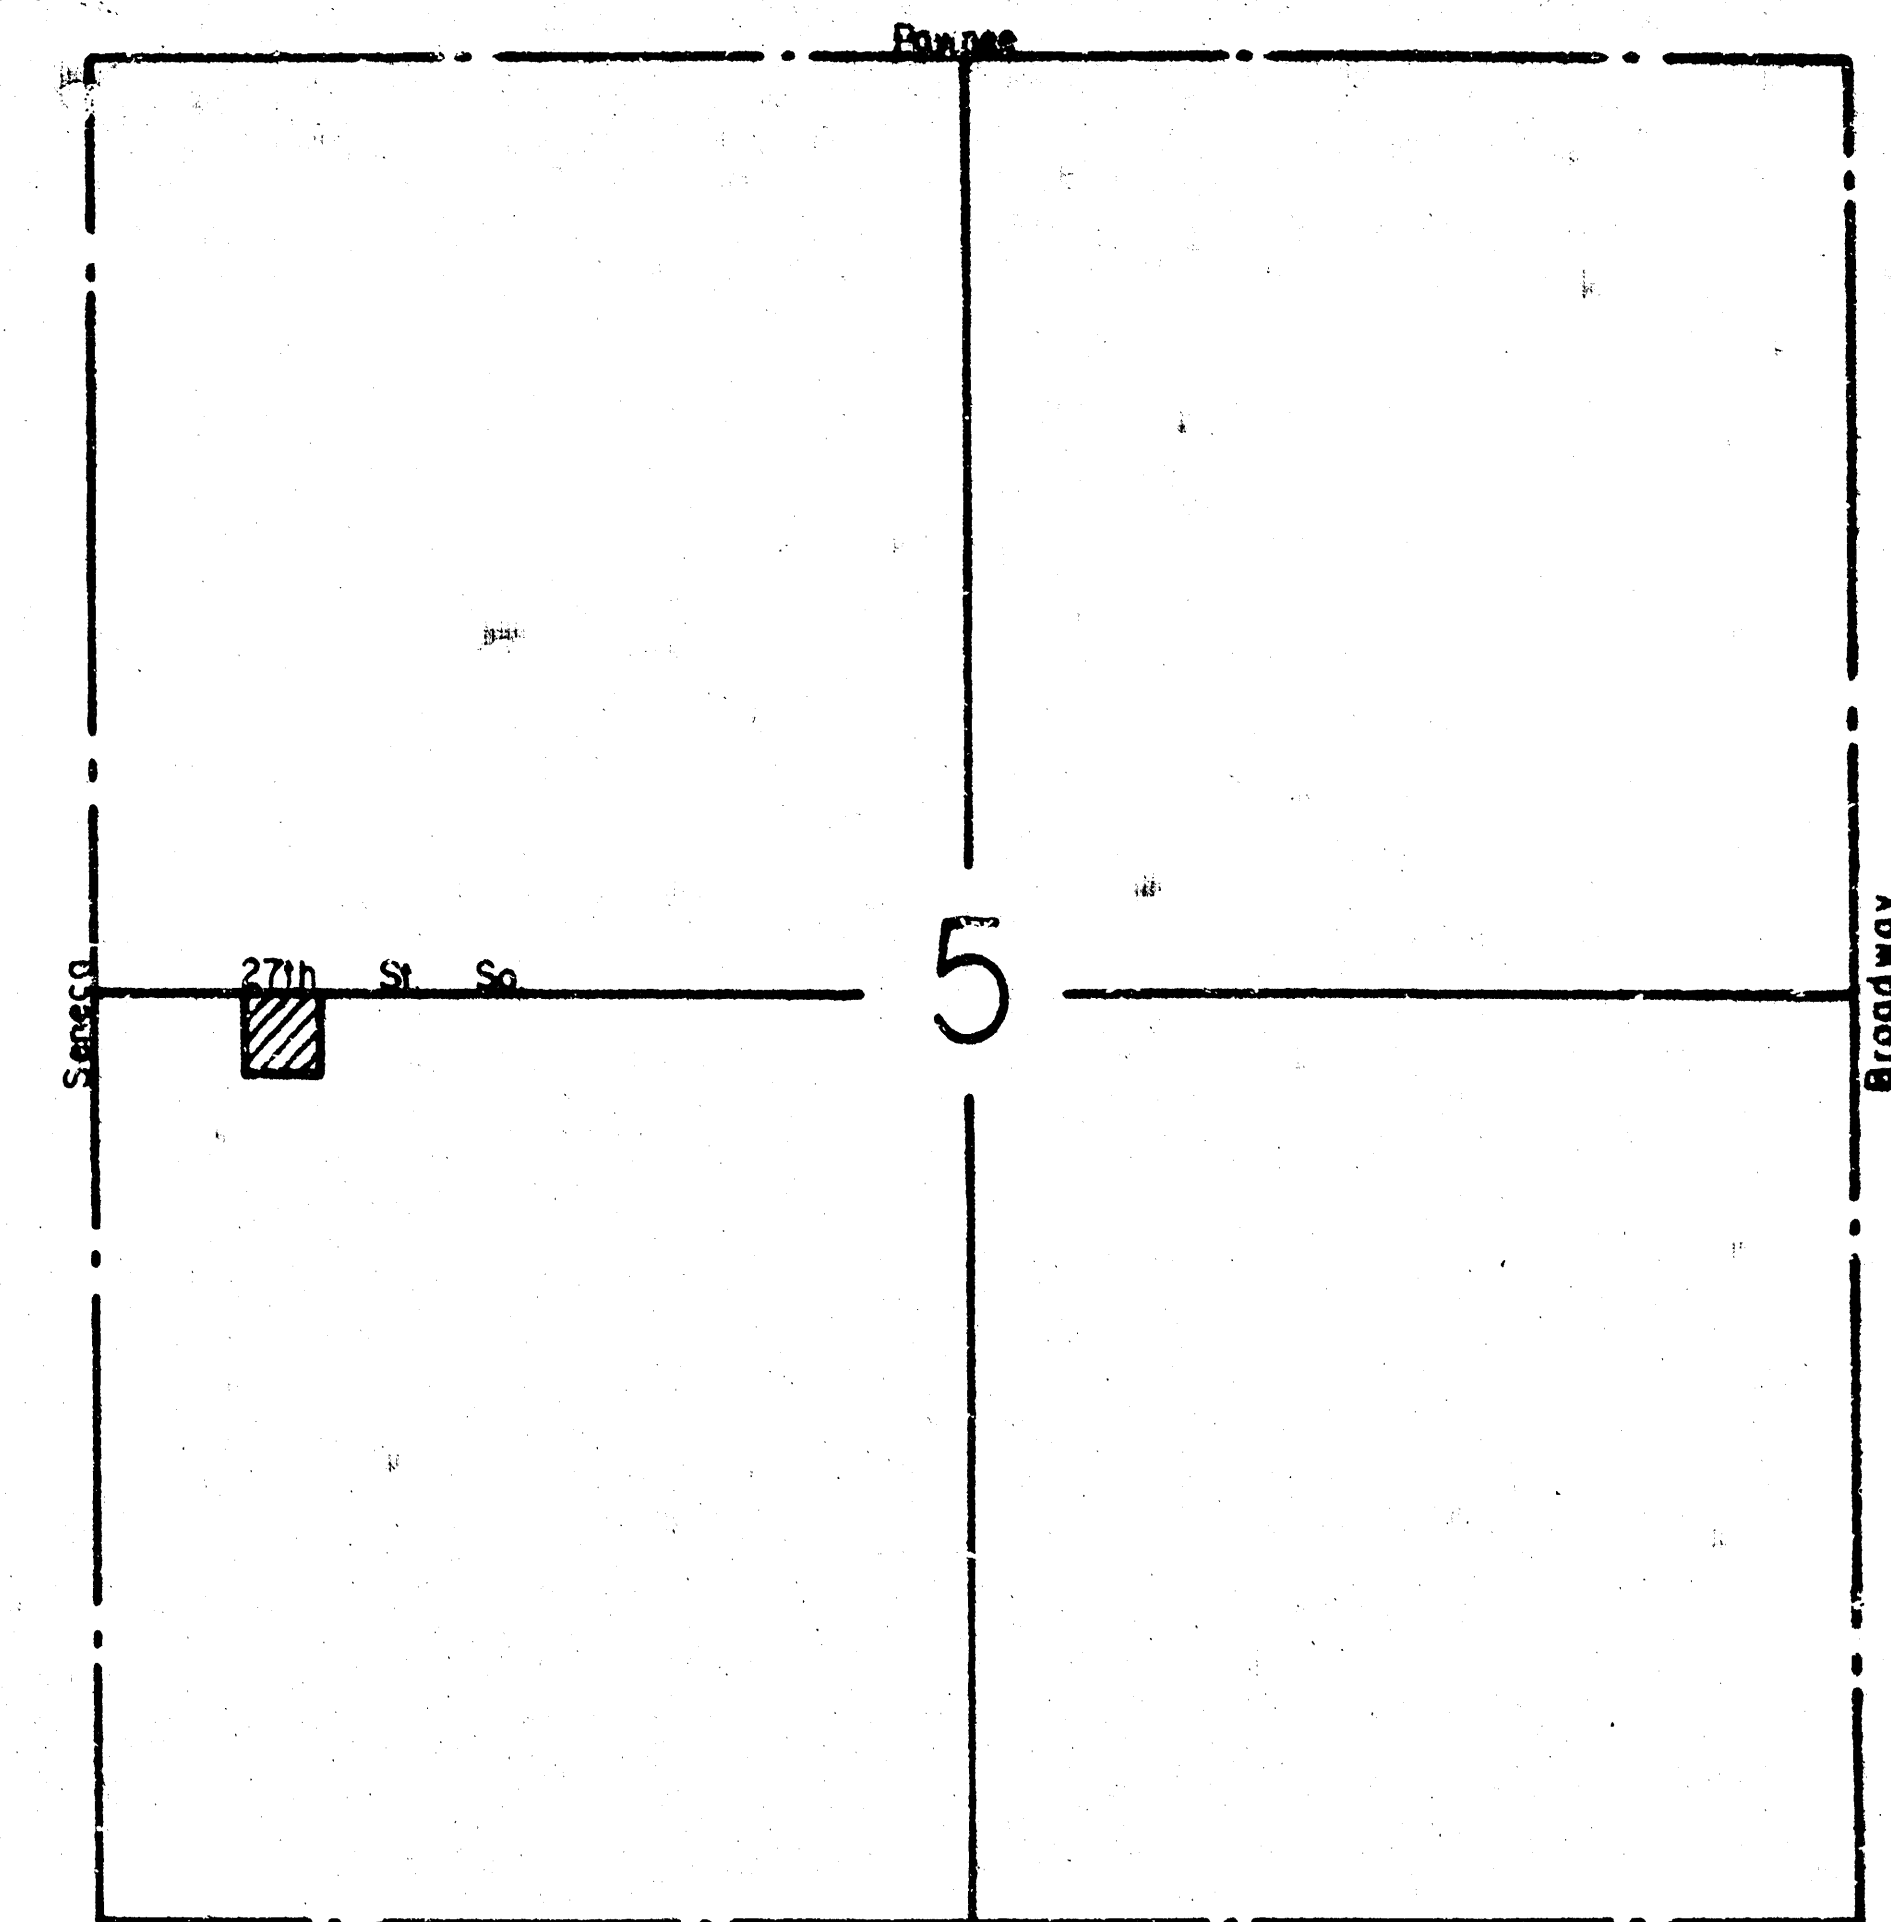



PRELIMINARY PLAT
R. H. McCOMB ADDITION
 WICHITA, SEDGWICK COUNTY, KANSAS

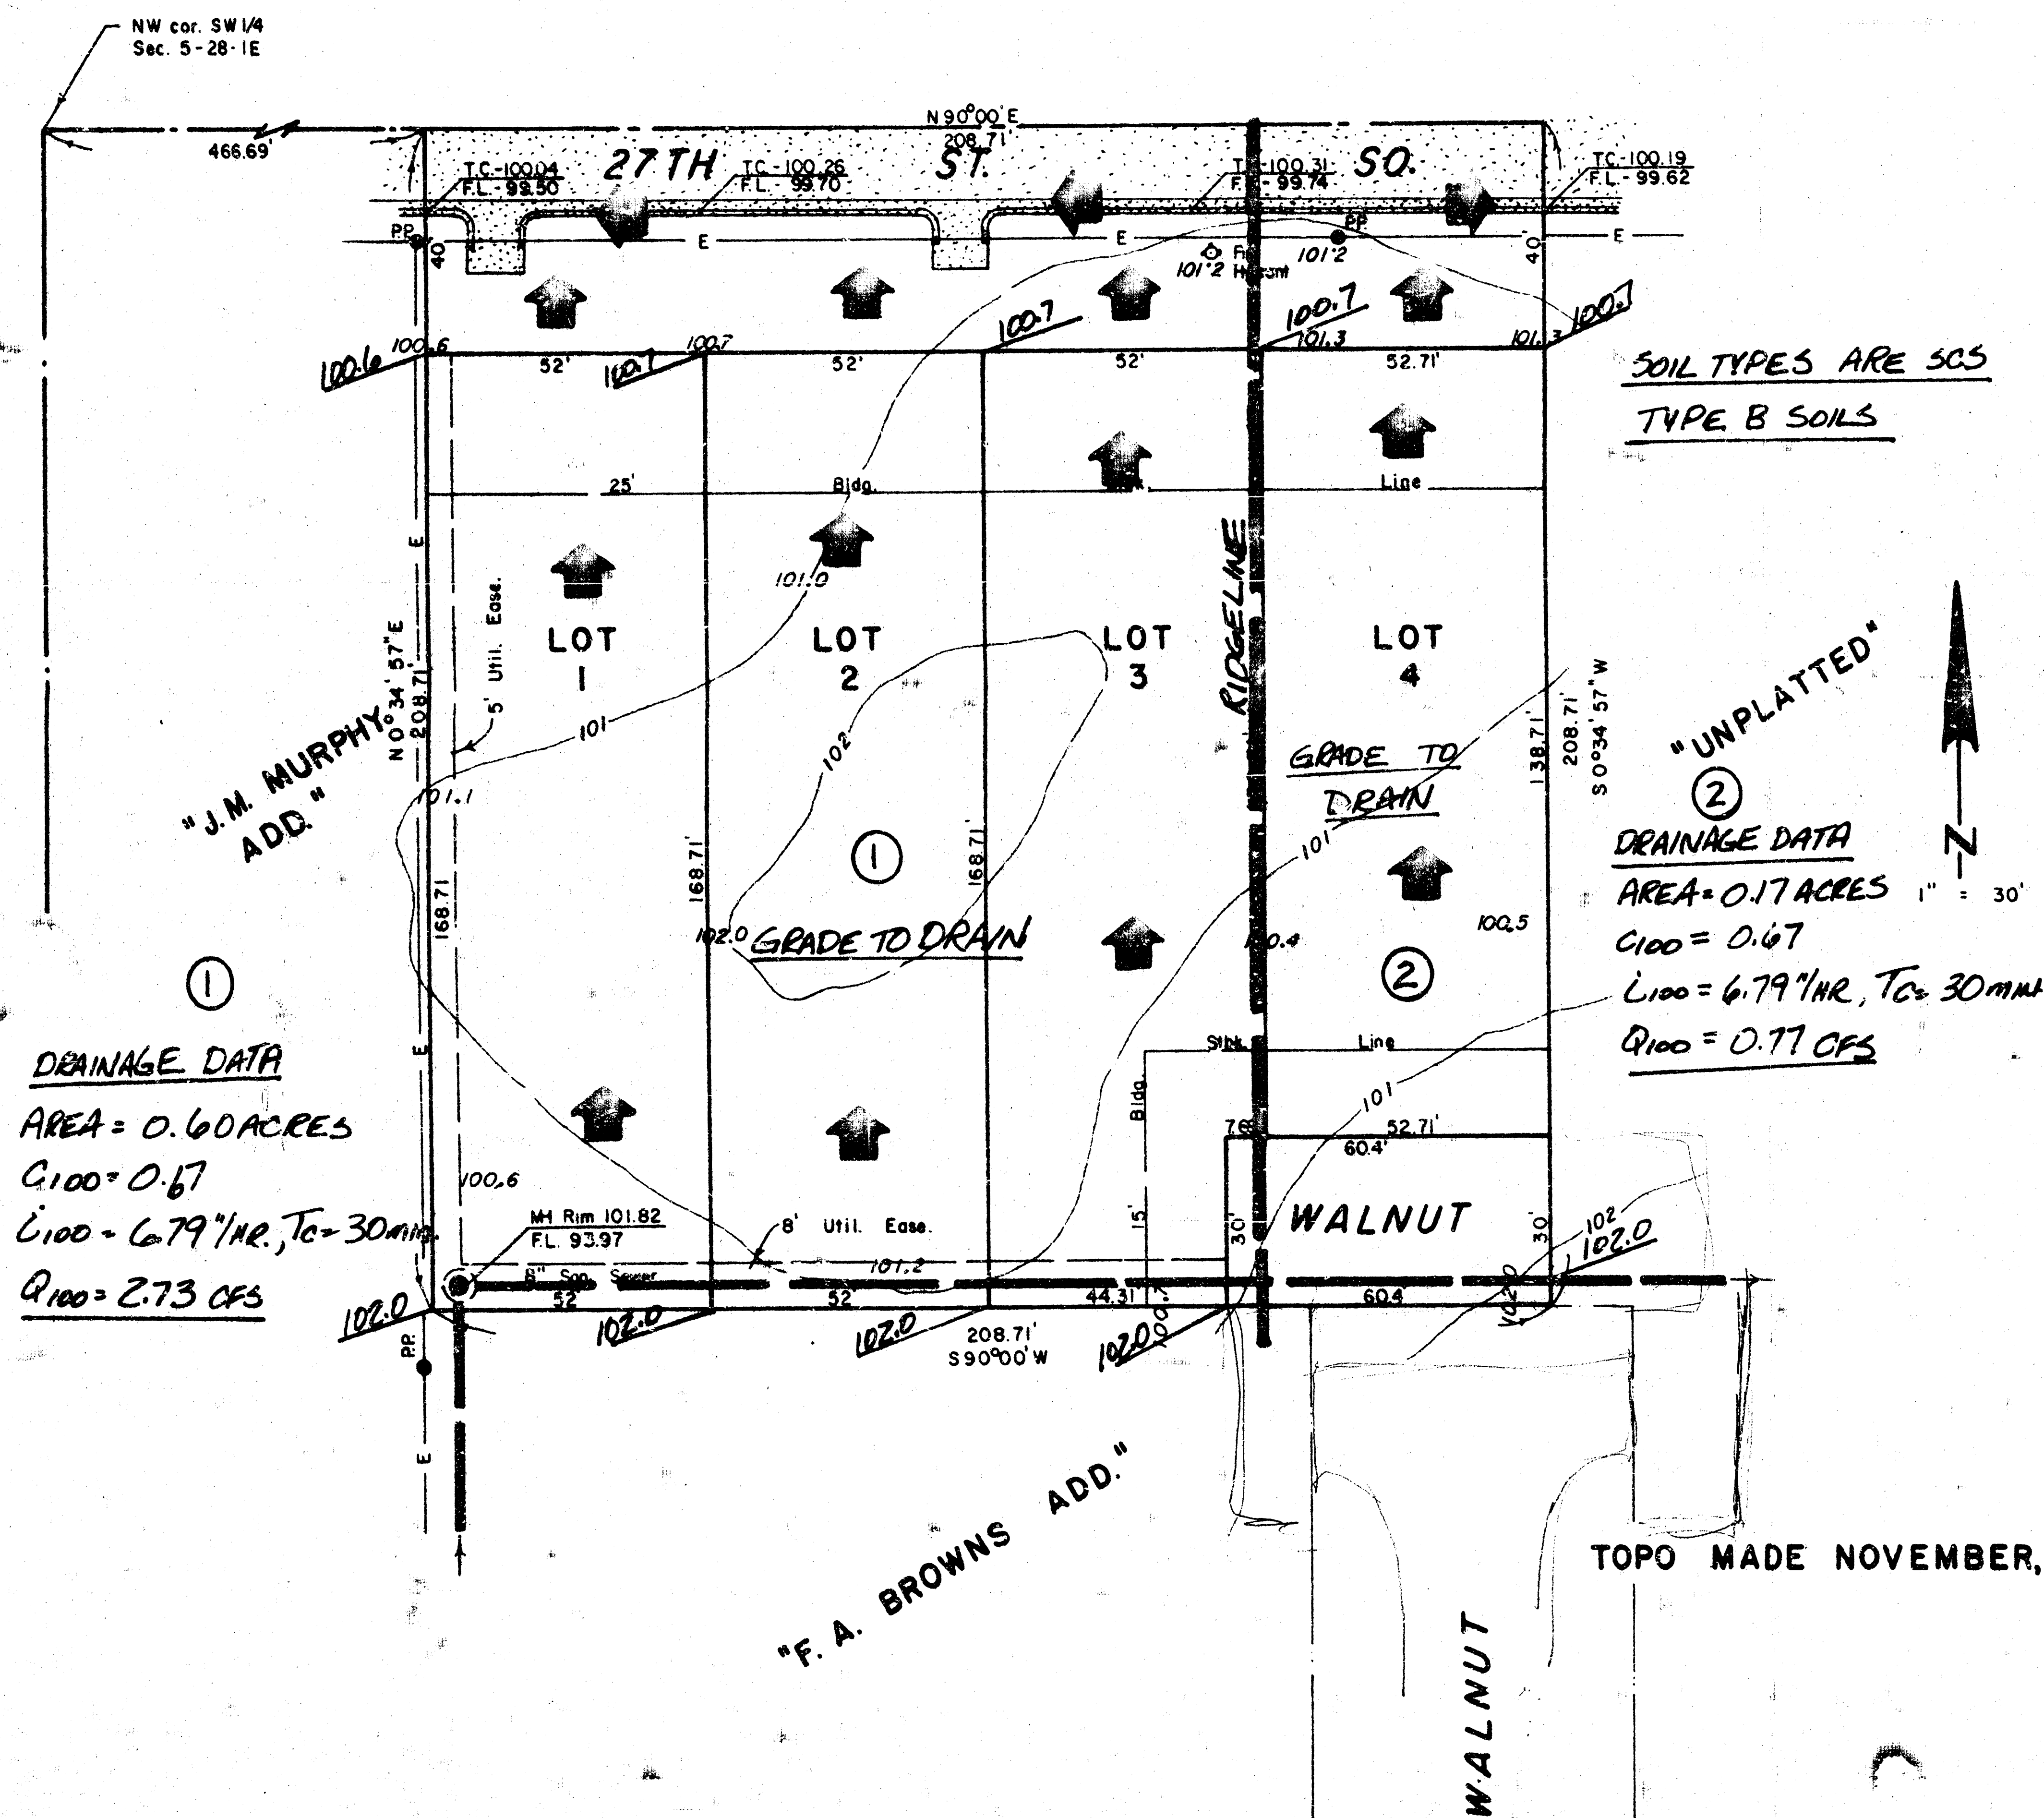

OWNER: R. H. McCOMB
 2317 SAND PLUM CT.
 WICHITA, KS 67205

B.M. - ELEV. 101.82 - E. RIM OF MH AT SW COR.
 OF PROPERTY.

DRAINAGE PLAN PREPARED BY:
CERTIFIED ENGINEERING DESIGN
 438 NORTH OHIO
 WICHITA, KS 67214
 (316) 262-8808 Ph.
 (316) 262-9600 Fax

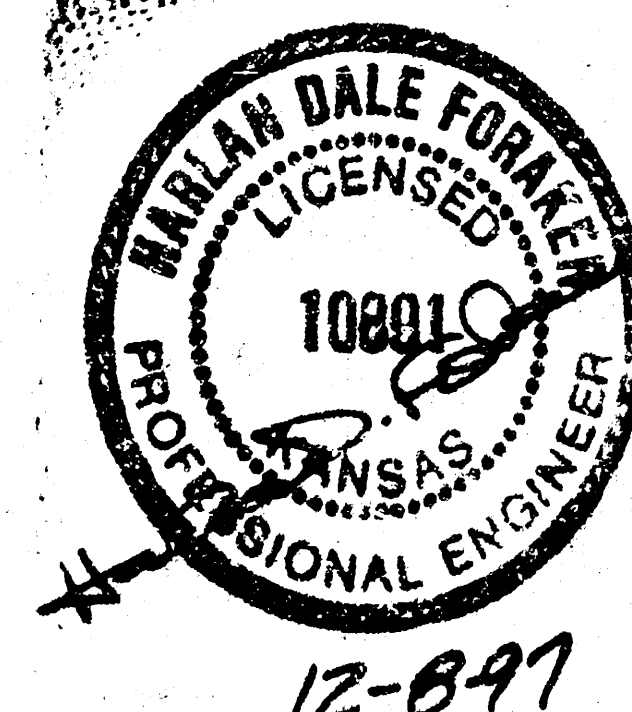

SANDALWOOD SURVEYING INC.
 P.O. BOX 75053
 WICHITA, KS 67275-5053