


drainage plan

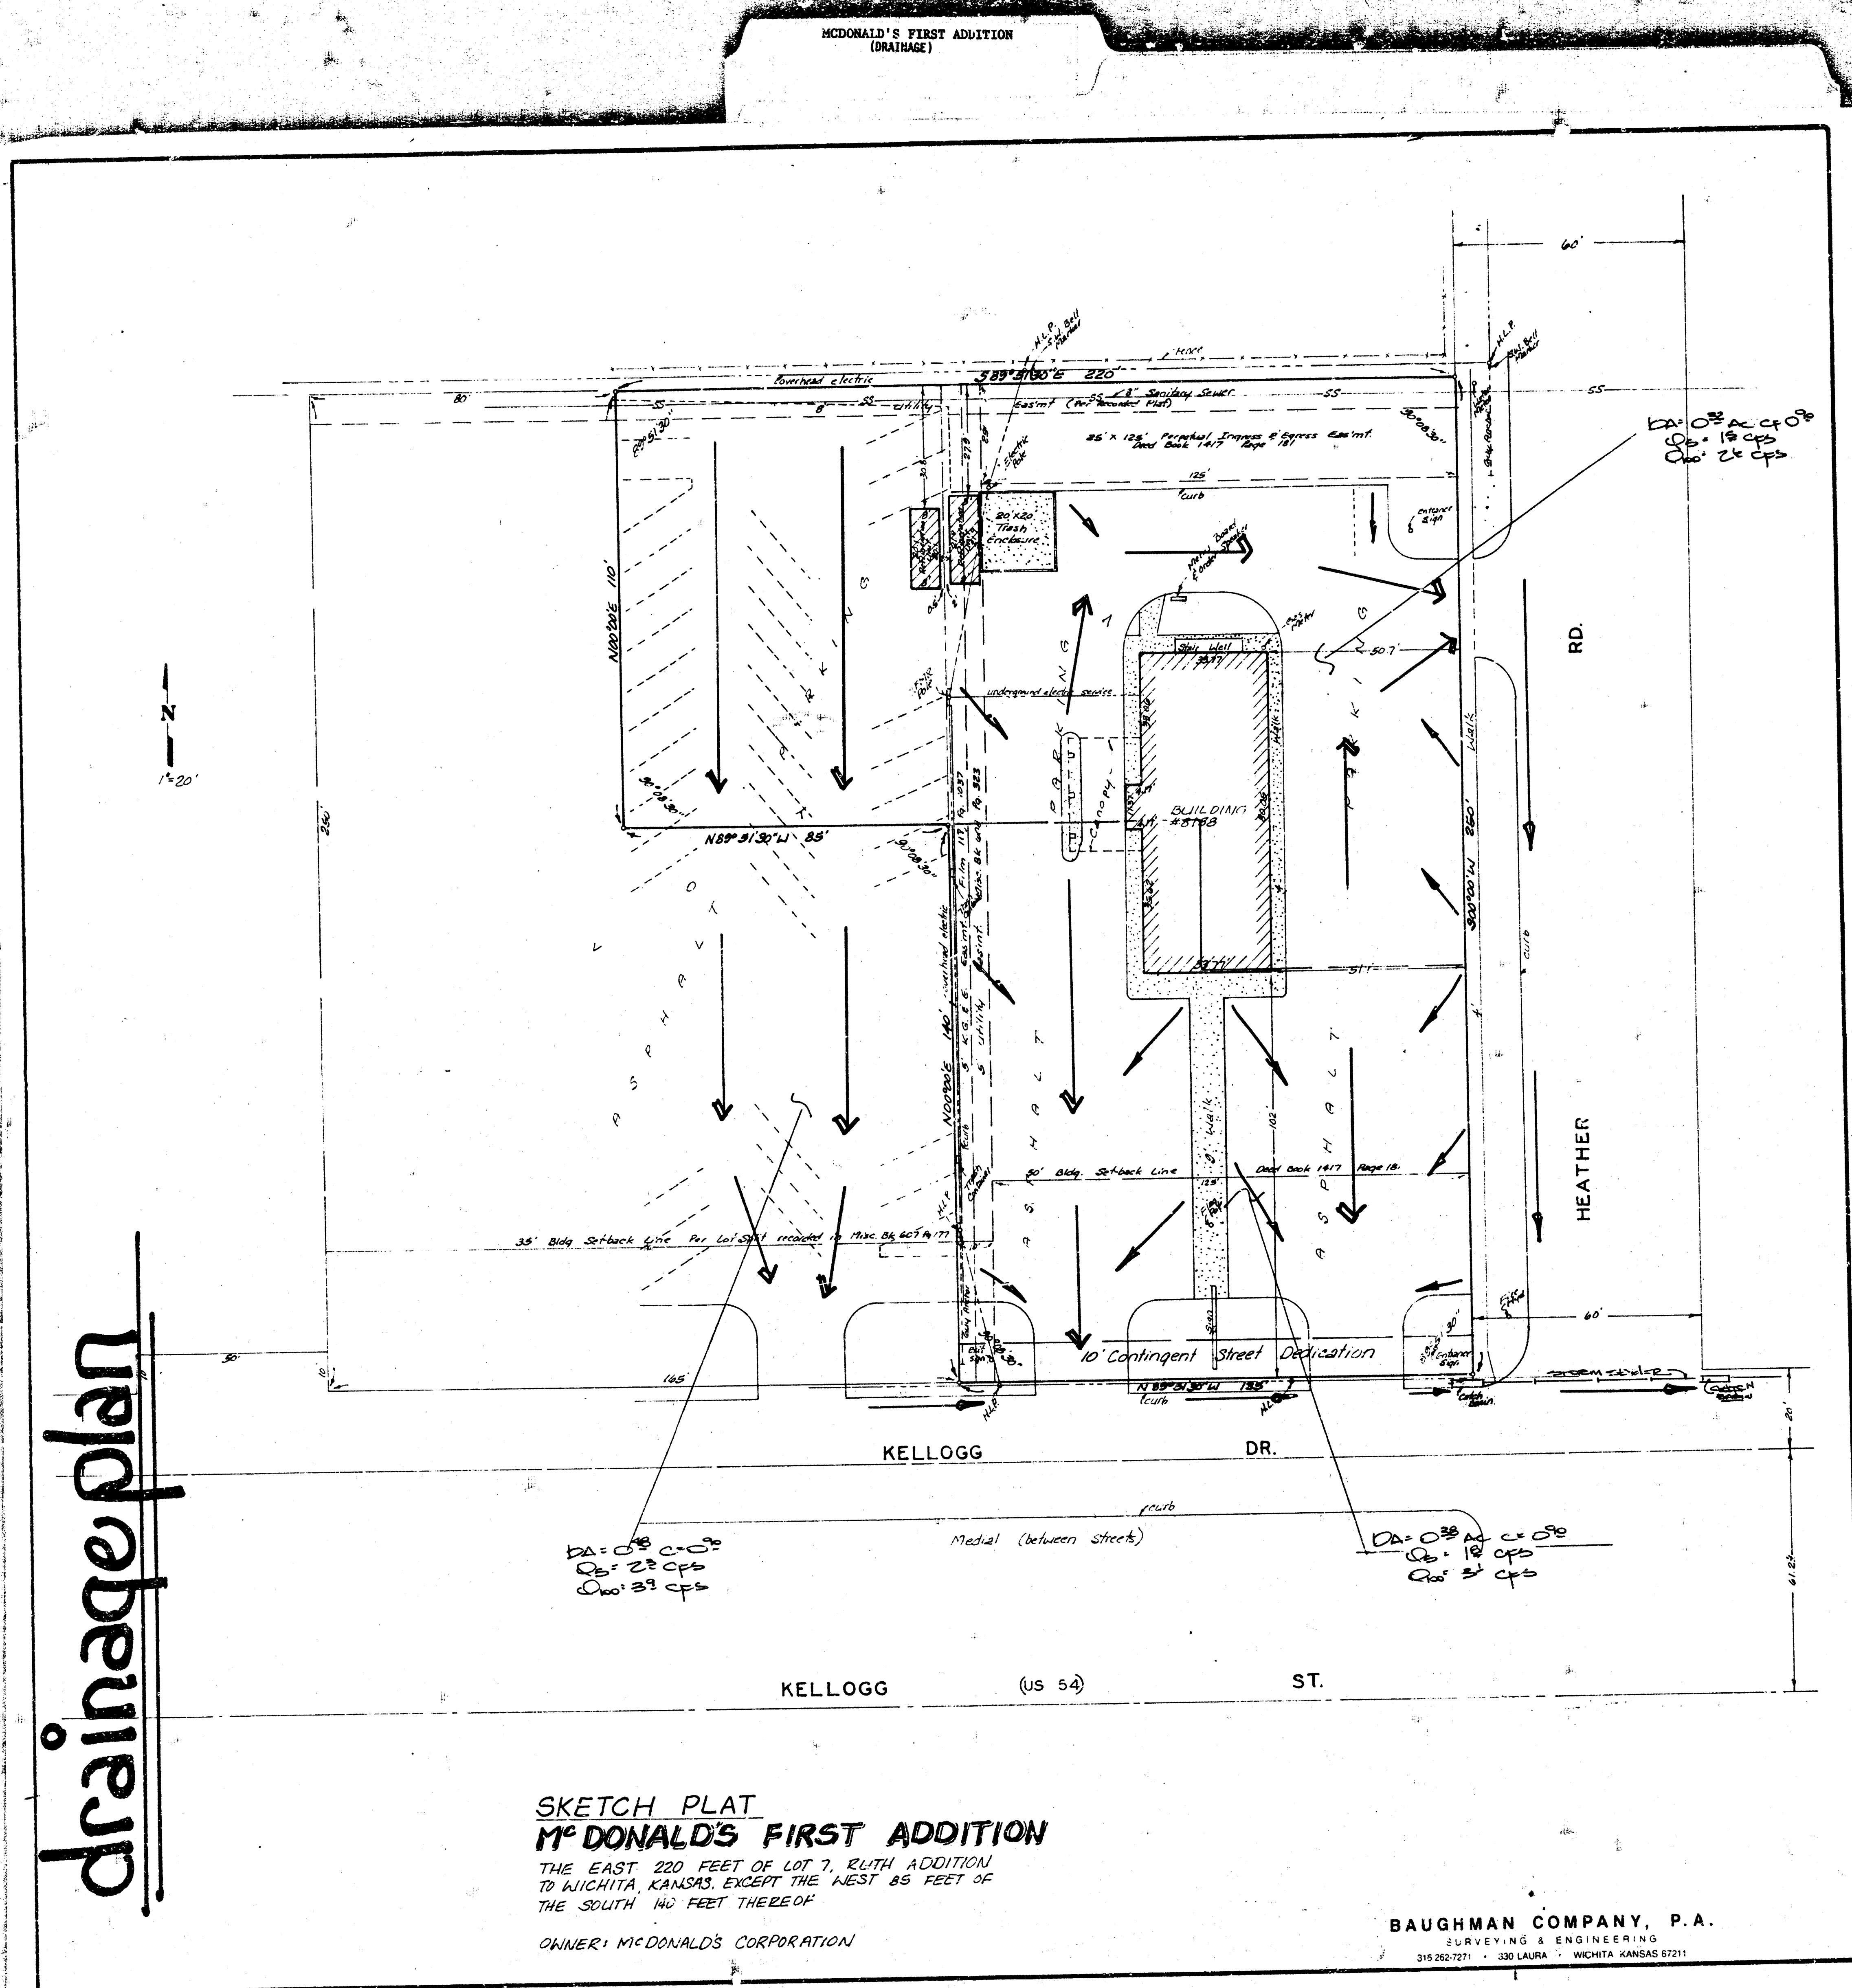

BAUGHMAN COMPANY, P.A.
SURVEYING & ENGINEERING
316/262-7271 • 330 LAURA • WICHITA, KANSAS 67211

MEMO

PROJECT: MCDONALD'S 1st ADDN. DATE: 6-1-83
JOB NO.:
TO: CHRIS BEINFELDSTEIN
FROM: B. KLOOTEN
REFERENCE: DRAINAGE PLAN

FINAL PLAT IS SCHEDULED FOR
SUBDIVISION FOR JUNE 23, 1983.

THE LOT IS FULLY PAVED AND DEVELOPED.
RUNOFF DISCHARGES TO KELLOGG DR. THEN
3 DRIVES AND TO HEATHER THEN ONE DRIVE.
EXISTING STORM SEWERS DISCHARGE THE
FLO ON KELLOGG DR INTO THE WILLYS
AS INDICATED. FLO CALCULATIONS PER
AREA ARE SHOWN.