


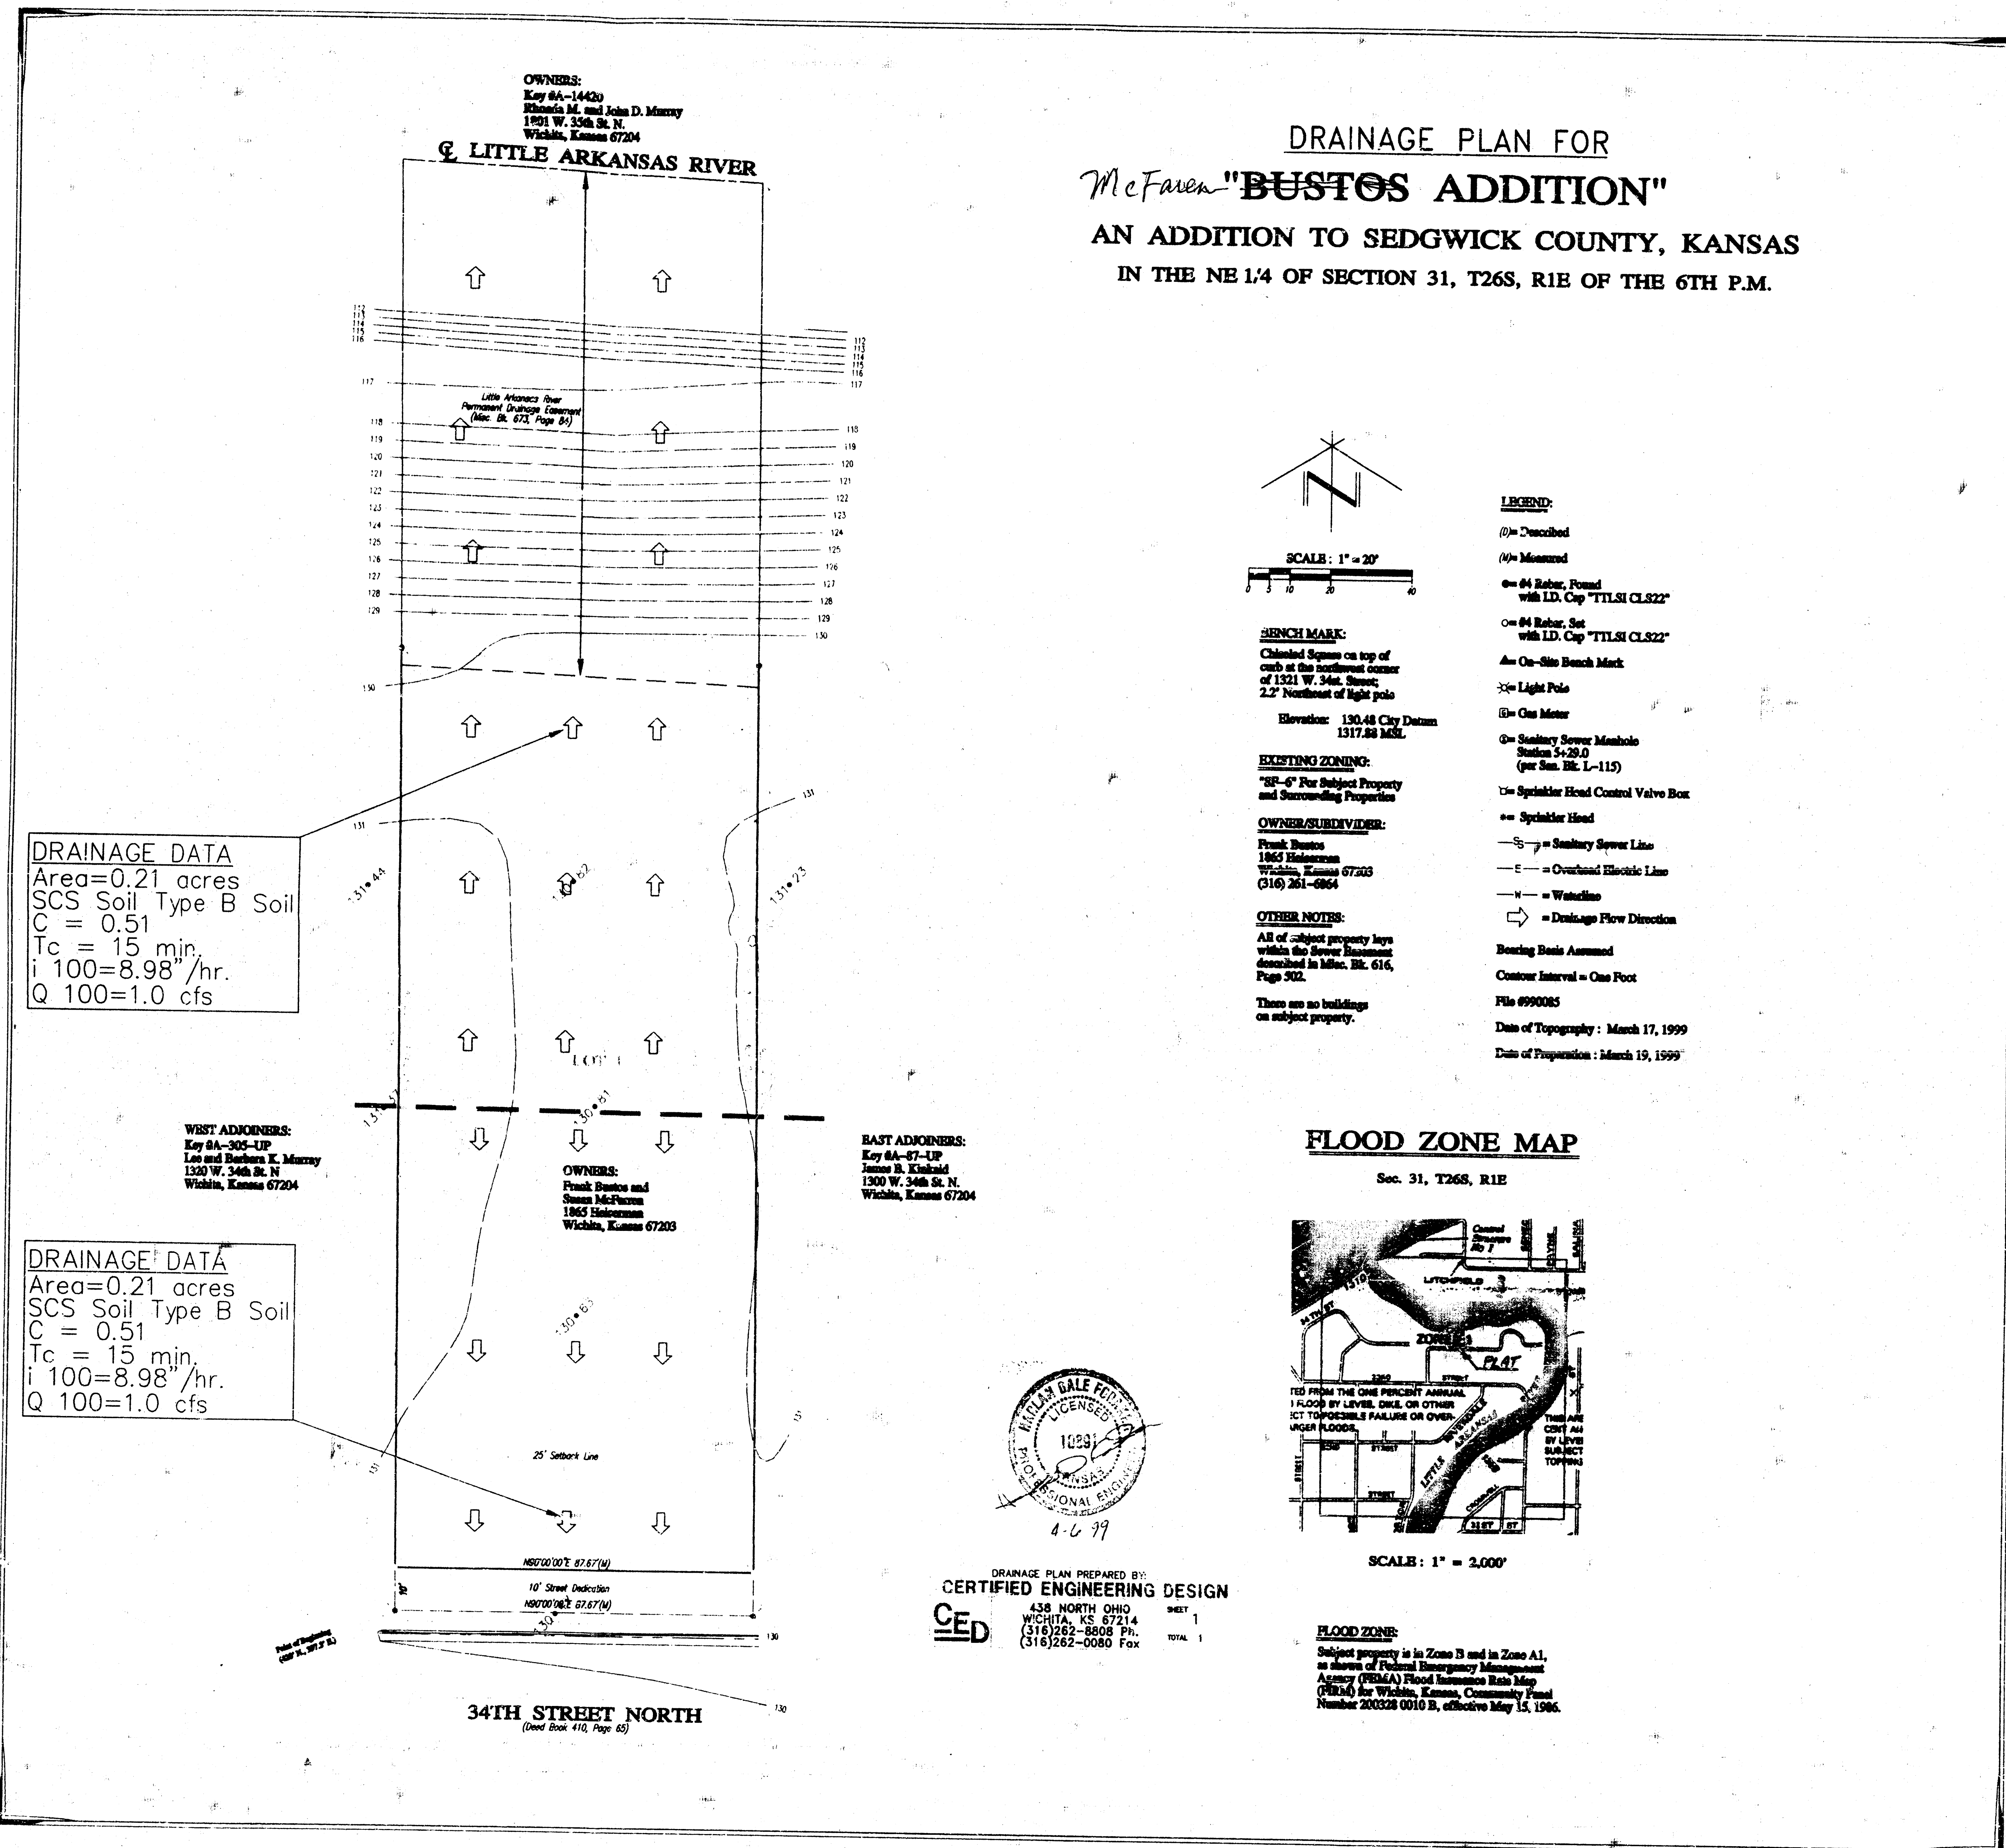

LEGAL DESCRIPTION FOR "BUSTOS ADDITION"

