


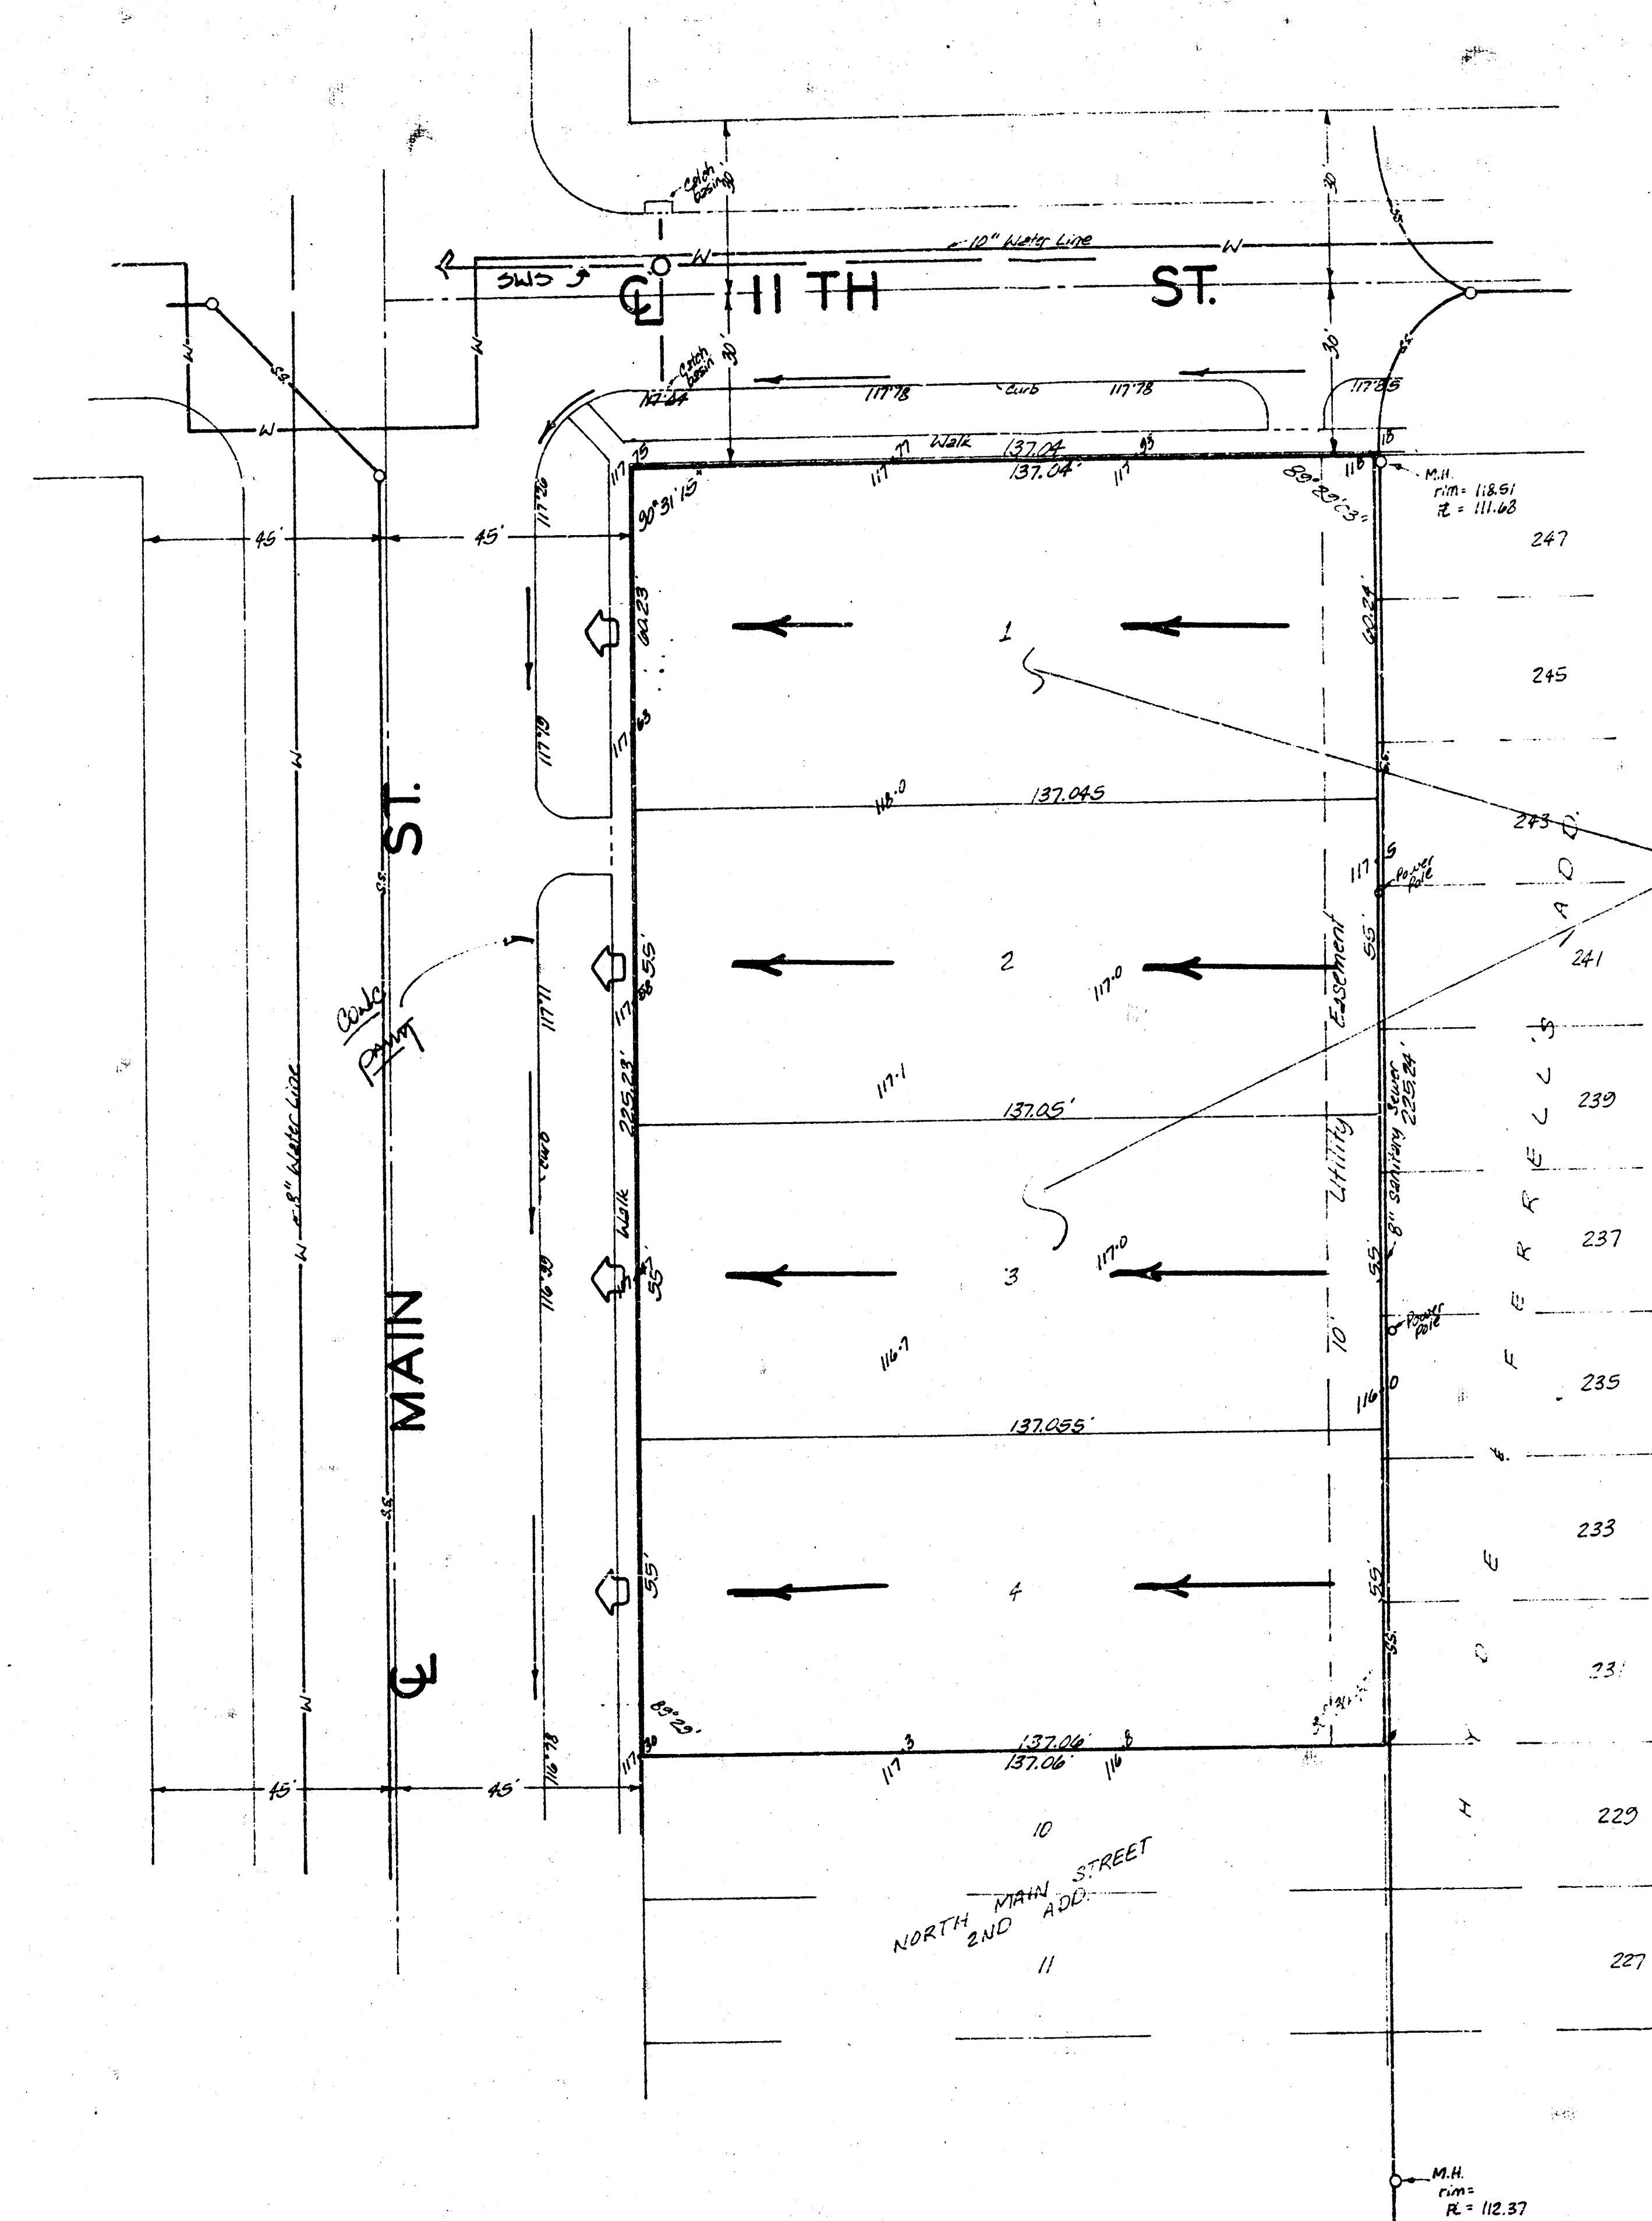


1"=20'
Elev. City Datum

NOTE

1. Lots will drain west to main street with discharge to the street thru driveways.
2. Main street drains south to lots at 10th St.
3. Existing storm sewer and lots at 11th St are worked.

SKETCH PLAT MIDTOWN 2ND ADDITION

LOT 1, BLOCK 1, NORTH MAIN STREET 3RD
ADDITION TO WICHITA, SEDGWICK COUNTY, KANSAS
AND LOTS 8 AND 9 ON MAIN ST, NORTH MAIN
STREET 2ND ADDITION TO WICHITA, KANSAS
OWNER: CITY OF WICHITA

FINAL DRAINAGE PLAN

BAUGHMAN COMPANY, P.A.
SURVEYING & ENGINEERING
3162ND 12TH - 530 LAUREL - WICHITA, KANSAS 67211

4/13-24