


**DRAINAGE PLAN**  
**LOREN R. MORGAN ADDITION**  
**WICHITA, SEDGWICK COUNTY, KANSAS**

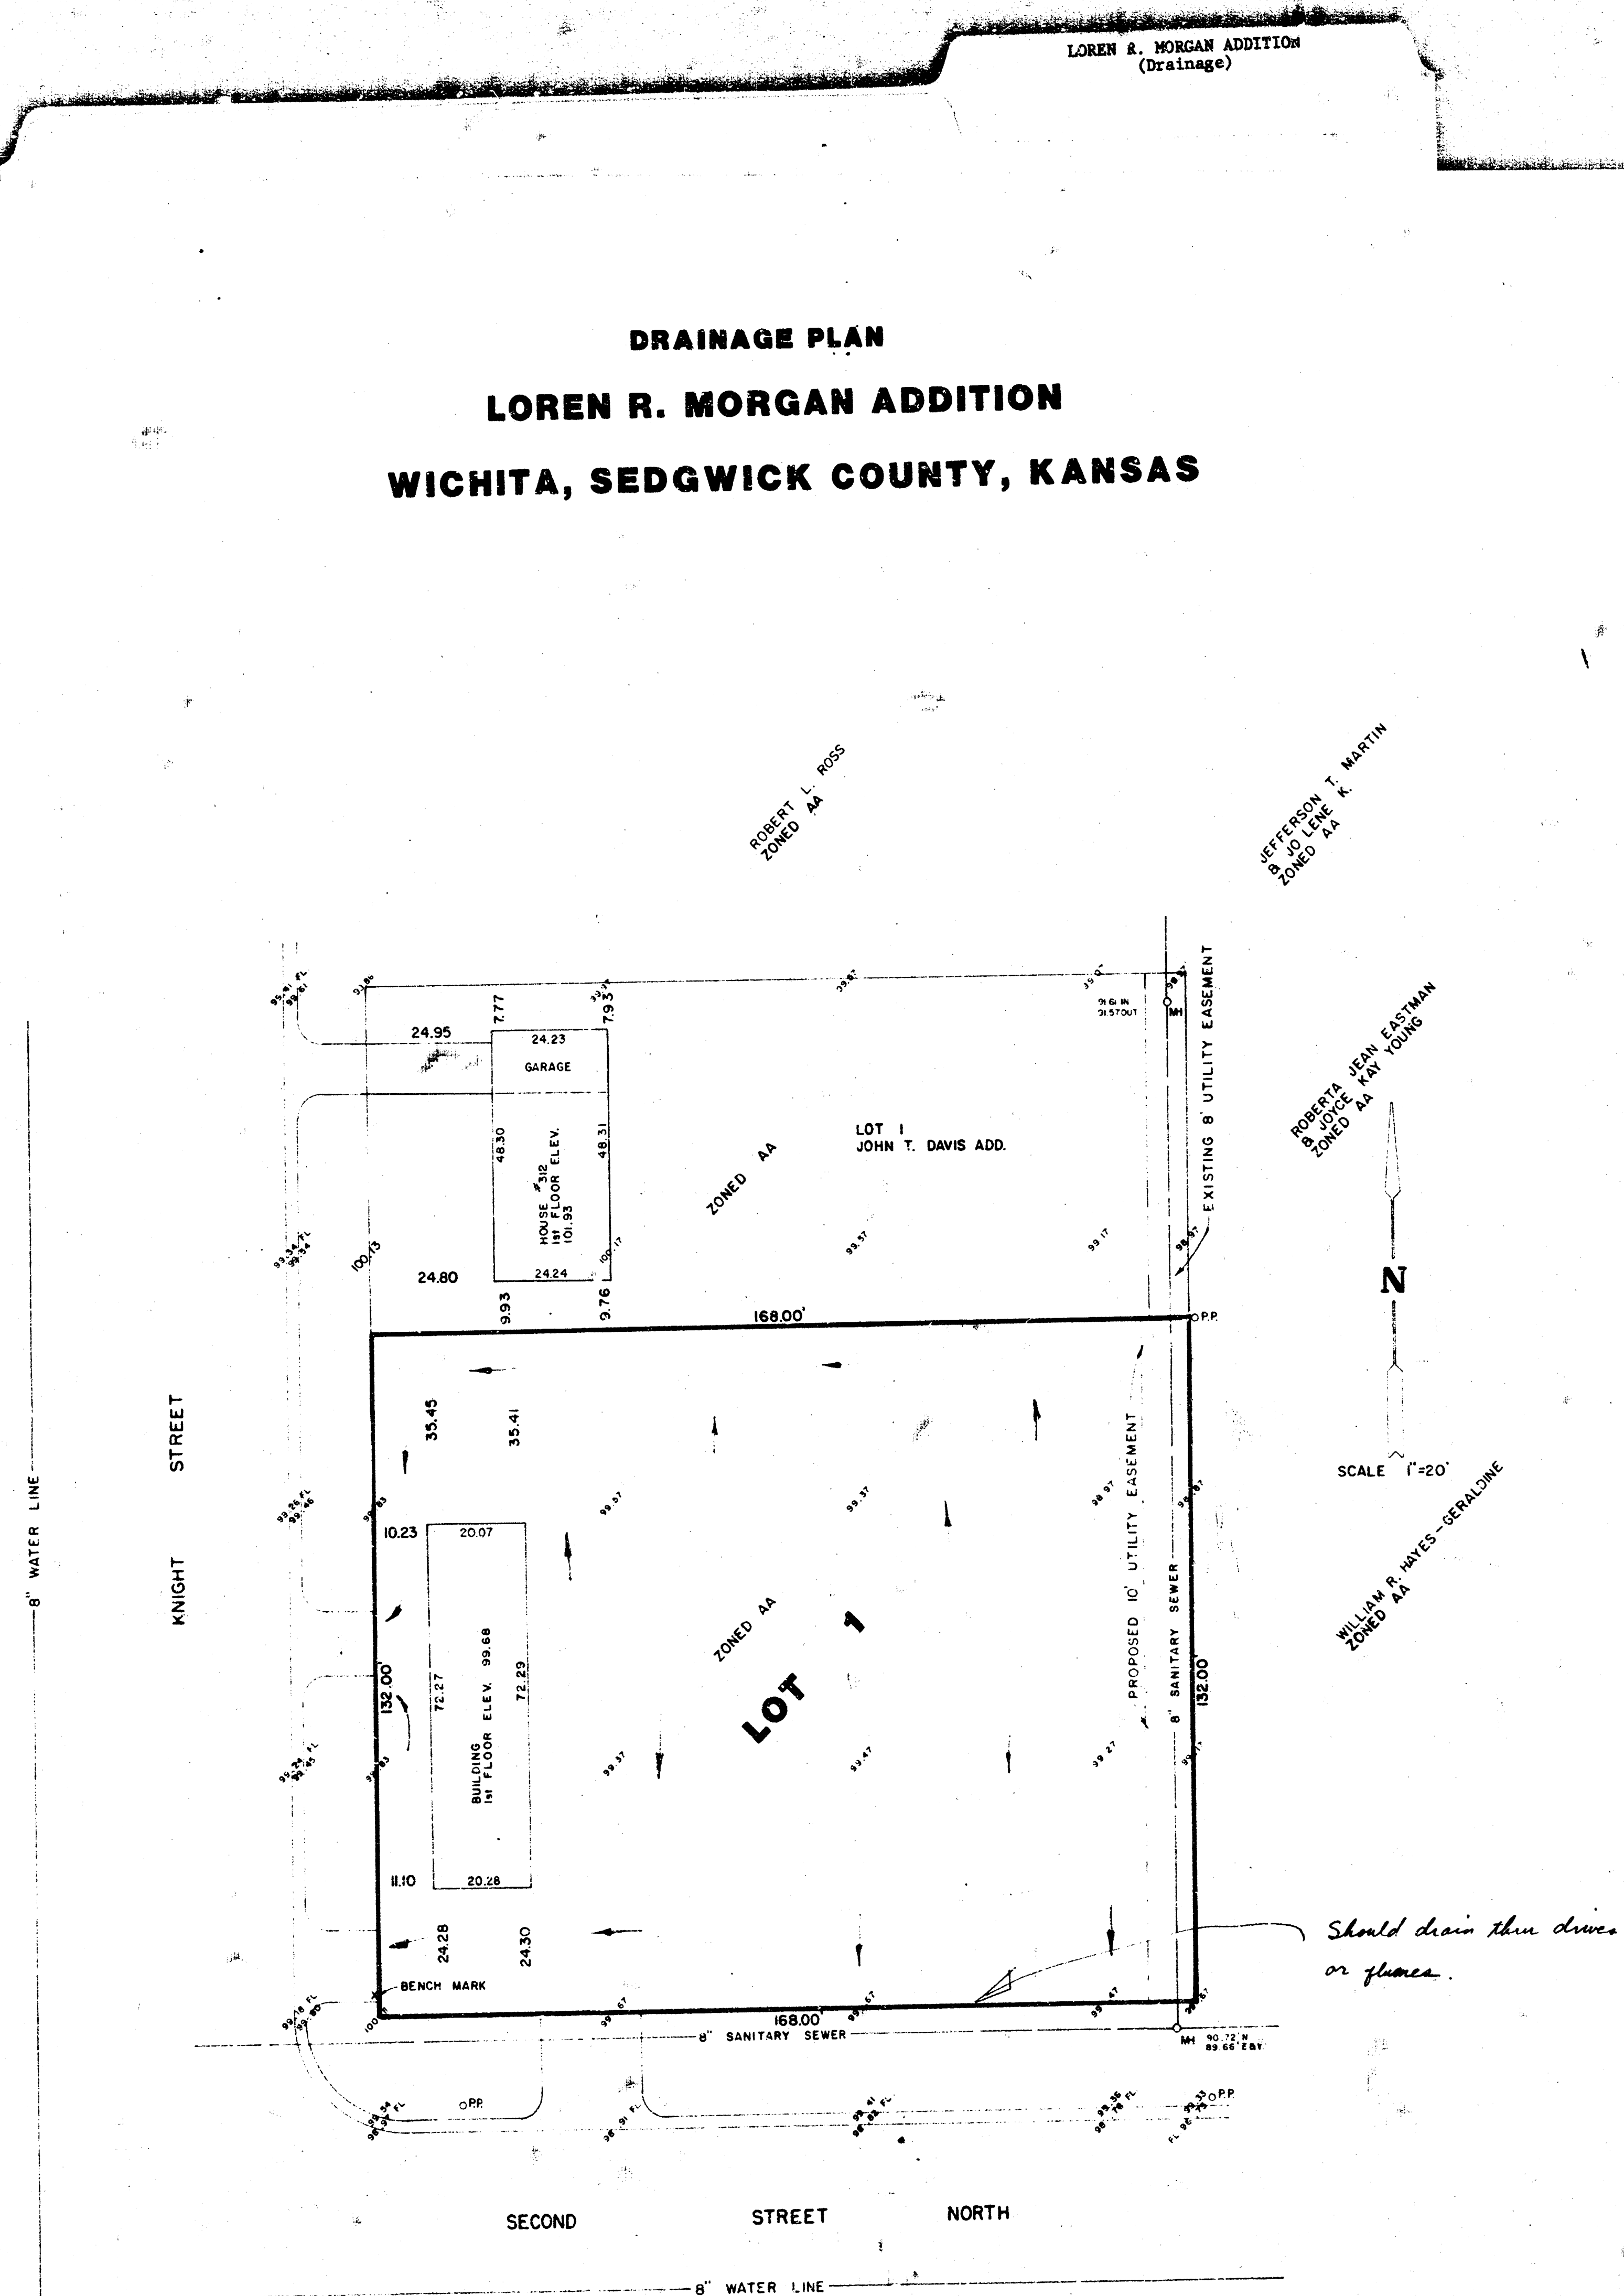

TOPOGRAPHIC SURVEY - 5-11-84  
 BENCH MARK: BACK OF SIDEWALK  
 AT SOUTH EDGE OF DRIVEWAY,  
 FIRST DRIVE NORTH OF 2nd ST.  
 ON EAST SIDE OF KNIGHT ST.  
 ELEV. 100.00'

ELEV. 100.00' = 117.90' CITY DATUM

MAY 24, 1984  
 OWNER:  
 LOREN R. MORGAN  
 3008 BENJAMIN  
 WICHITA, KS 67203

Air Capitol Land Surveyors  
 2100 W 21st STREET  
 WICHITA, KANSAS 67203