
Drainage Concept for
MOUNIVONG ADDITION
Wichita, Sedgwick County, Kansas

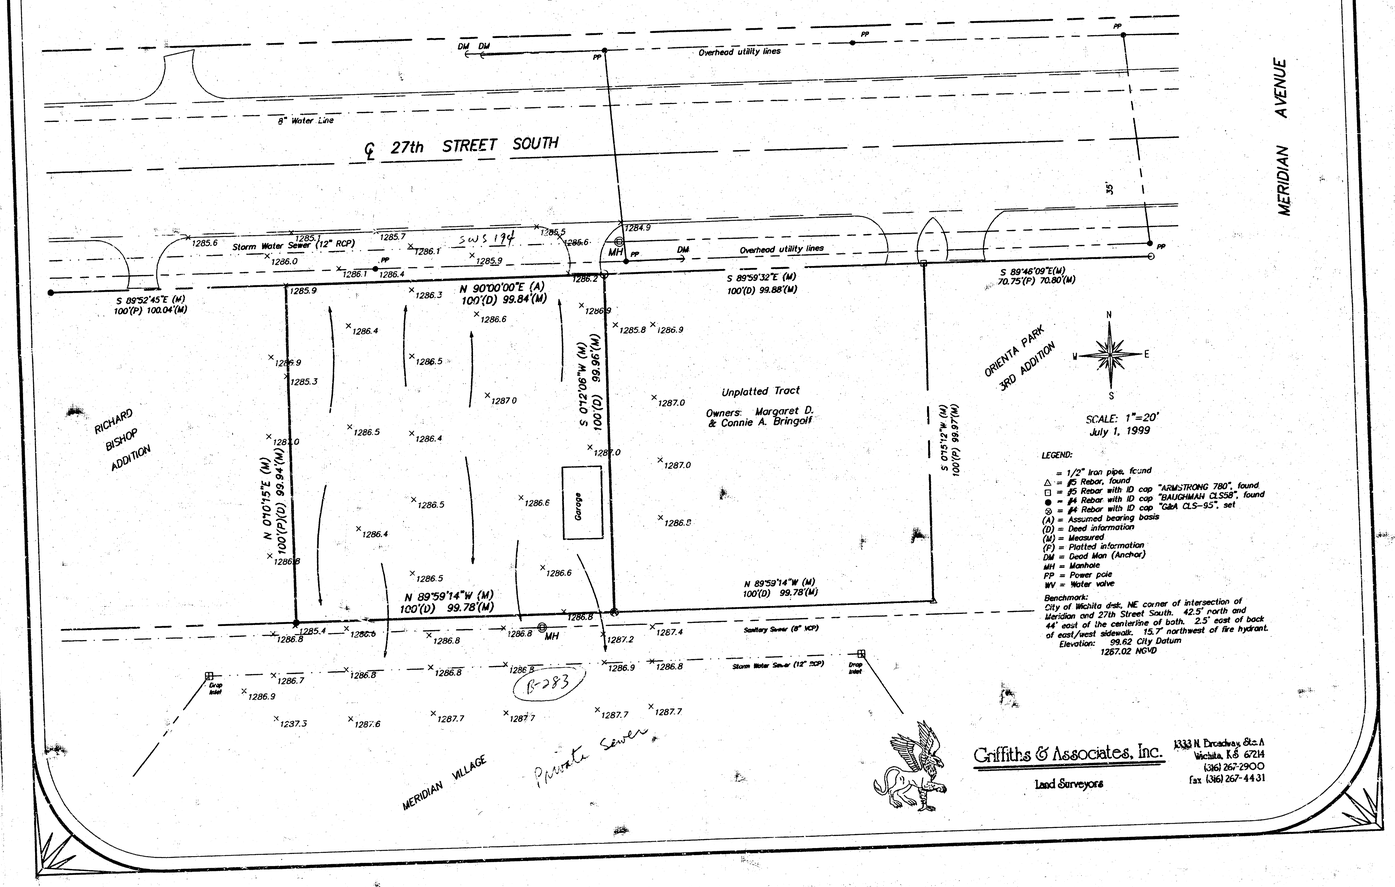

SCALE: 1"=20'
July 1, 1999

LEGEND:

= 1/2" iron pipe, found
△ = #5 Rebar, found
□ = #5 Rebar with ID cap "ARMSTRONG 780", found
● = #4 Rebar with ID cap "BAUGHMAN CLS58", found
◎ = #4 Rebar with ID cap "G&A CLS-95", set
(A) = Assumed bearing basis
(D) = Deed information
(M) = Measured
(P) = Platted information
DM = Dead Man (Anchor)
MH = Manhole
PP = Power pole
WV = Water valve

Benchmark:
City of Wichita disk, NE corner of intersection of Meridian and 27th Street South. 42.5' north and 44' east of the centerline of bath. 2.5' east of back of east/west sidewalk. 15.7' northwest of fire hydrant.
Elevation: 99.62 City Datum
1287.02 NGVD

Griffiths & Associates, Inc.
Land Surveyors
1333 N. Broadview, Ste. A
Wichita, KS 67214
(316) 267-2900
Fax (316) 267-4431