


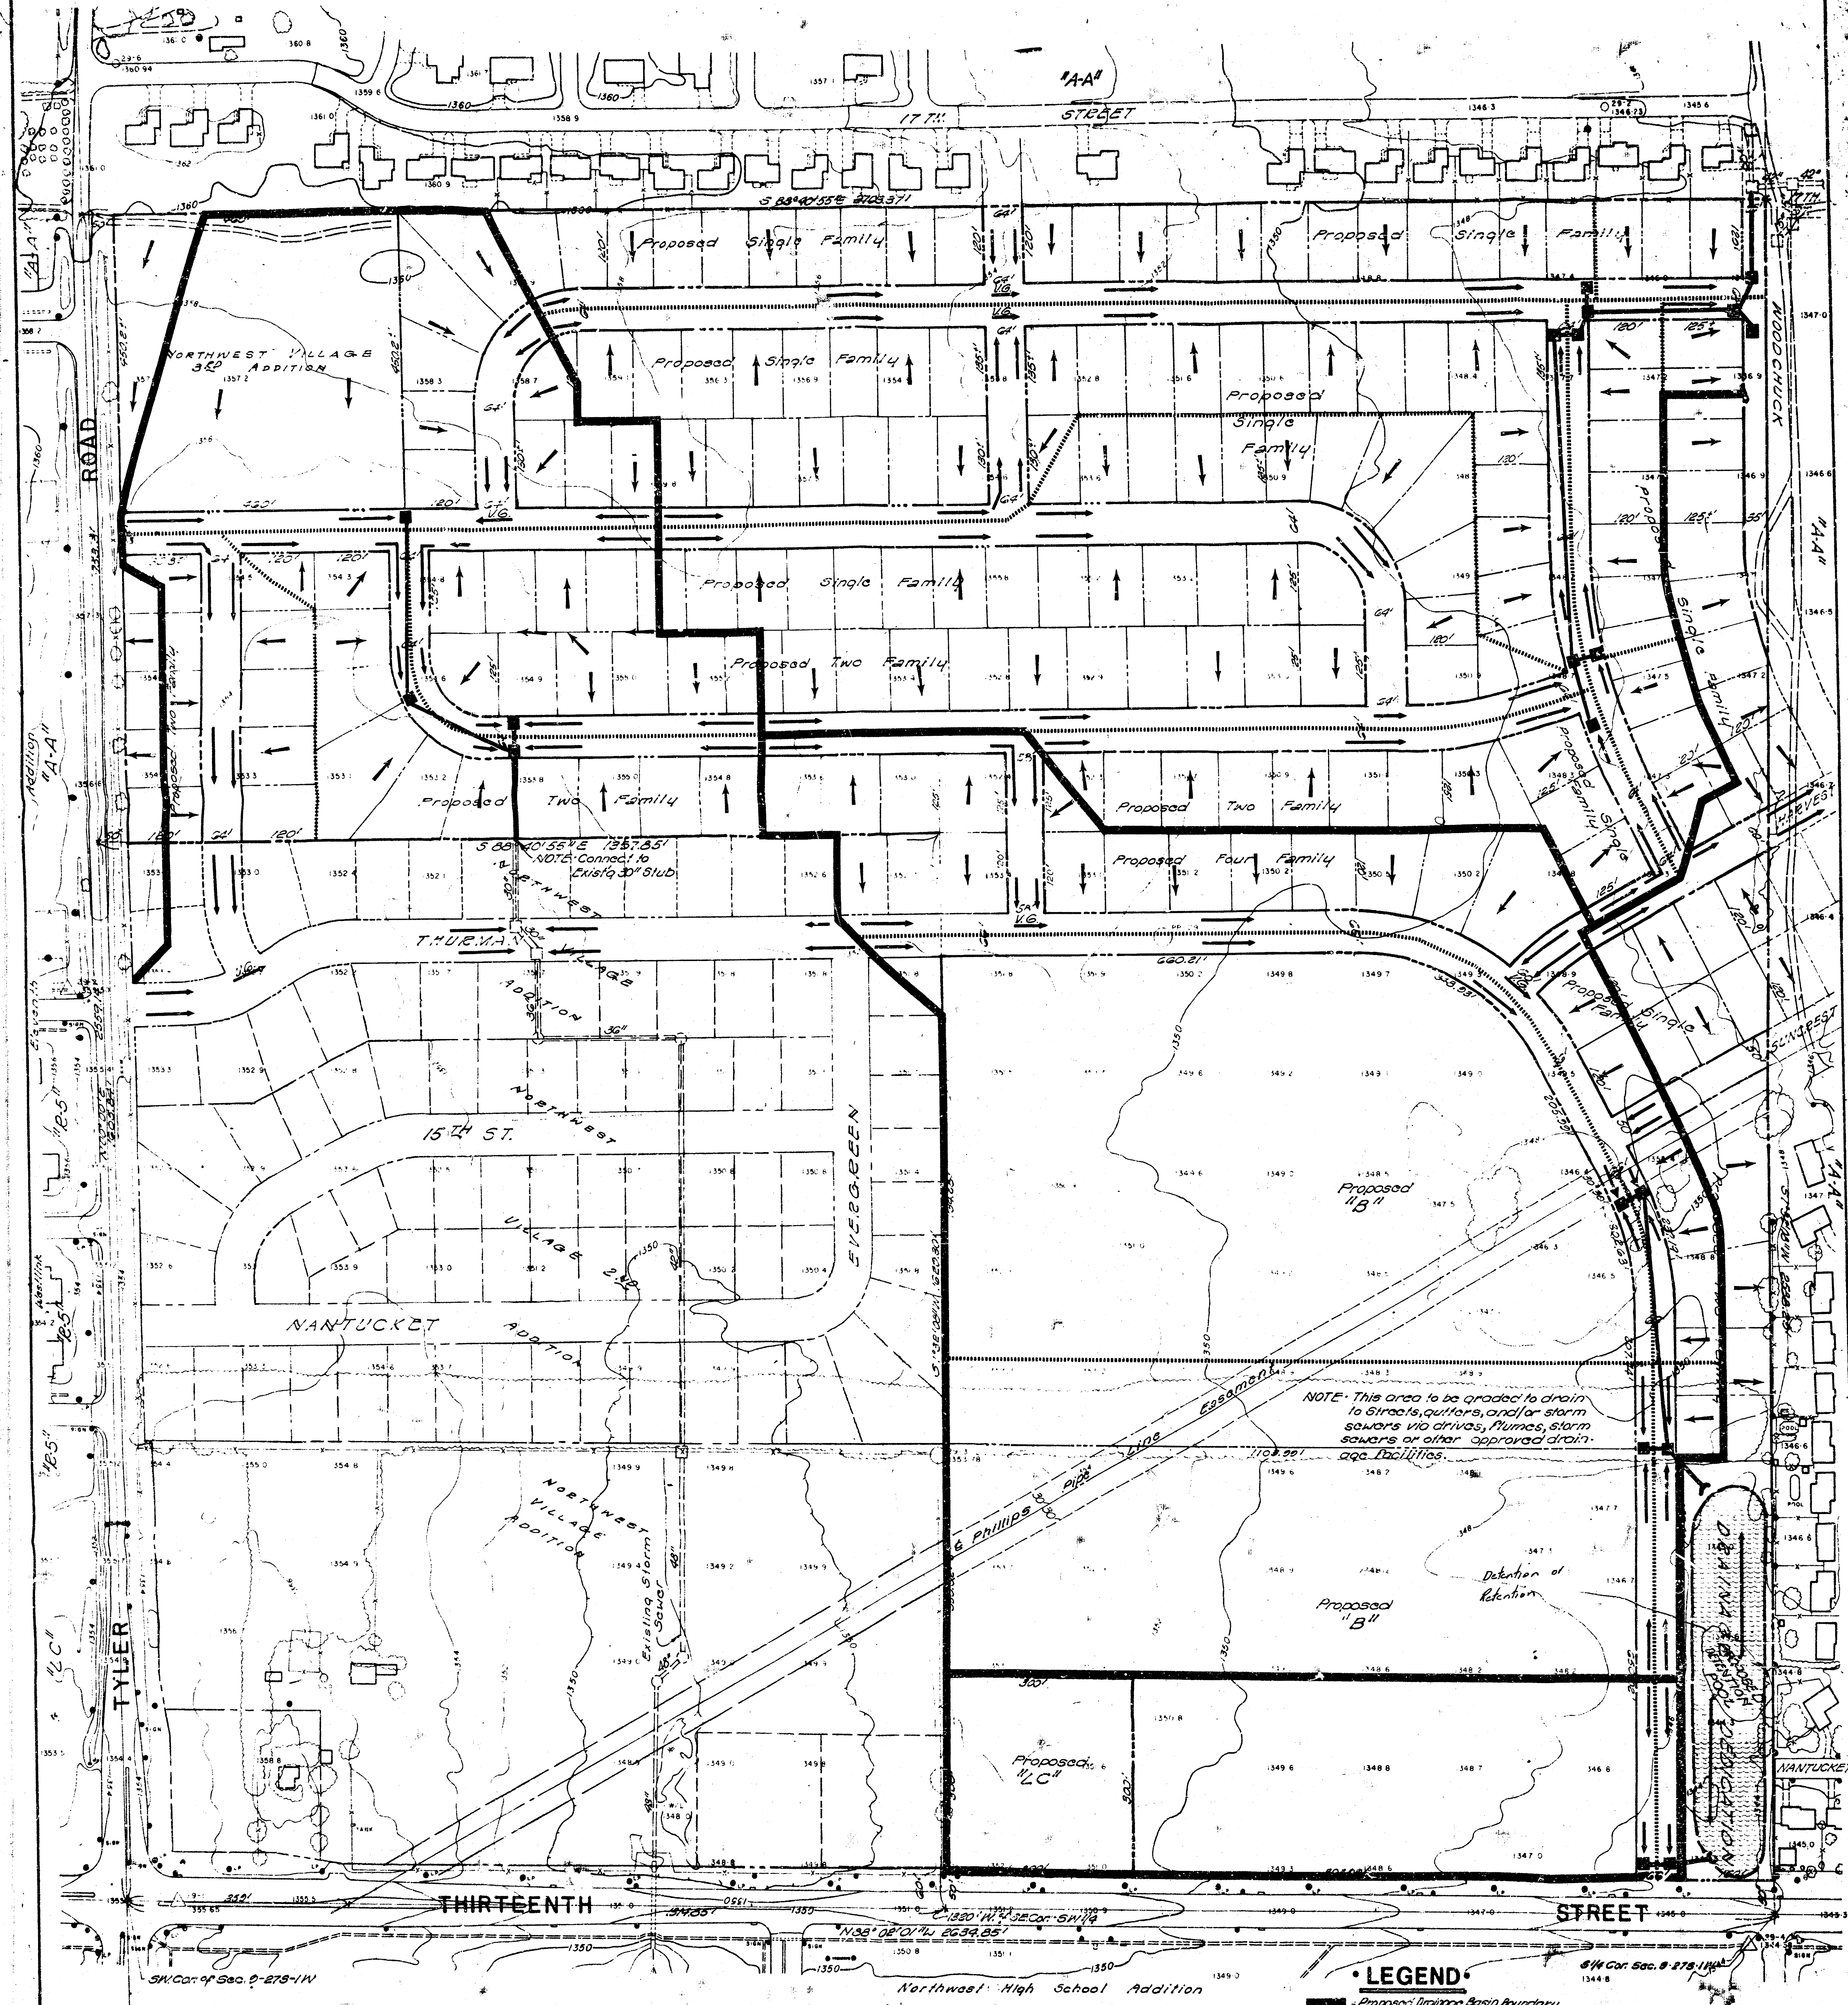

MEMO


TO: Chris Breitenstein, P.E.
City Hall - 7th Floor
455 N. Main
ATN:
PROJECT NO. 36-1105-1182
PROJECT: Northwest Village
4th Addition
DATE: September 28, 1981

COPIES TO:
Louise Oliver
Mike Jandek

FROM: Charles S. Brown, P.E.
REFERENCE: Drainage Concept

PLEASE ADVISE IMMEDIATELY OF ANY MISCONCEPTIONS OR OMISSIONS YOU BELIEVE TO BE CONTAINED HEREIN.

Transmitted herewith is one copy of the Drainage Concept for Northwest Village 4th Addition.
The Preliminary Plat will be submitted on Friday, October 2, 1981 for hearing on October 15, 1981.
If you have any questions, please call Dick Linn or Gary Wiley at our Land Development Office, 262-1107.
Detention or Retention Pond?
No outside structure.
City Approved?

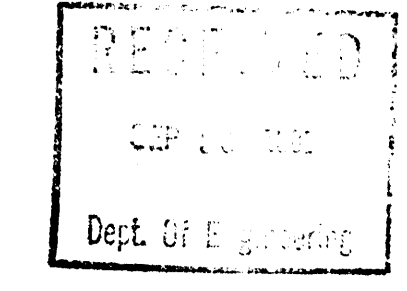

LEGEND

- Proposed Drainage Basin Boundary
- Existing Storm Drain Inlet
- Proposed Storm Drain Inlet
- Drain Directional Flow Arrow
- Street
- BM 172.43
- City Eng. P.E. & Tyler & (17th St)
- 36 S. 13th St. & Tyler Rd. (17th St)
- 1855.60 (NSD)

NORTHWEST VILLAGE 4TH ADDITION