


7-8-83
Drainage Plat

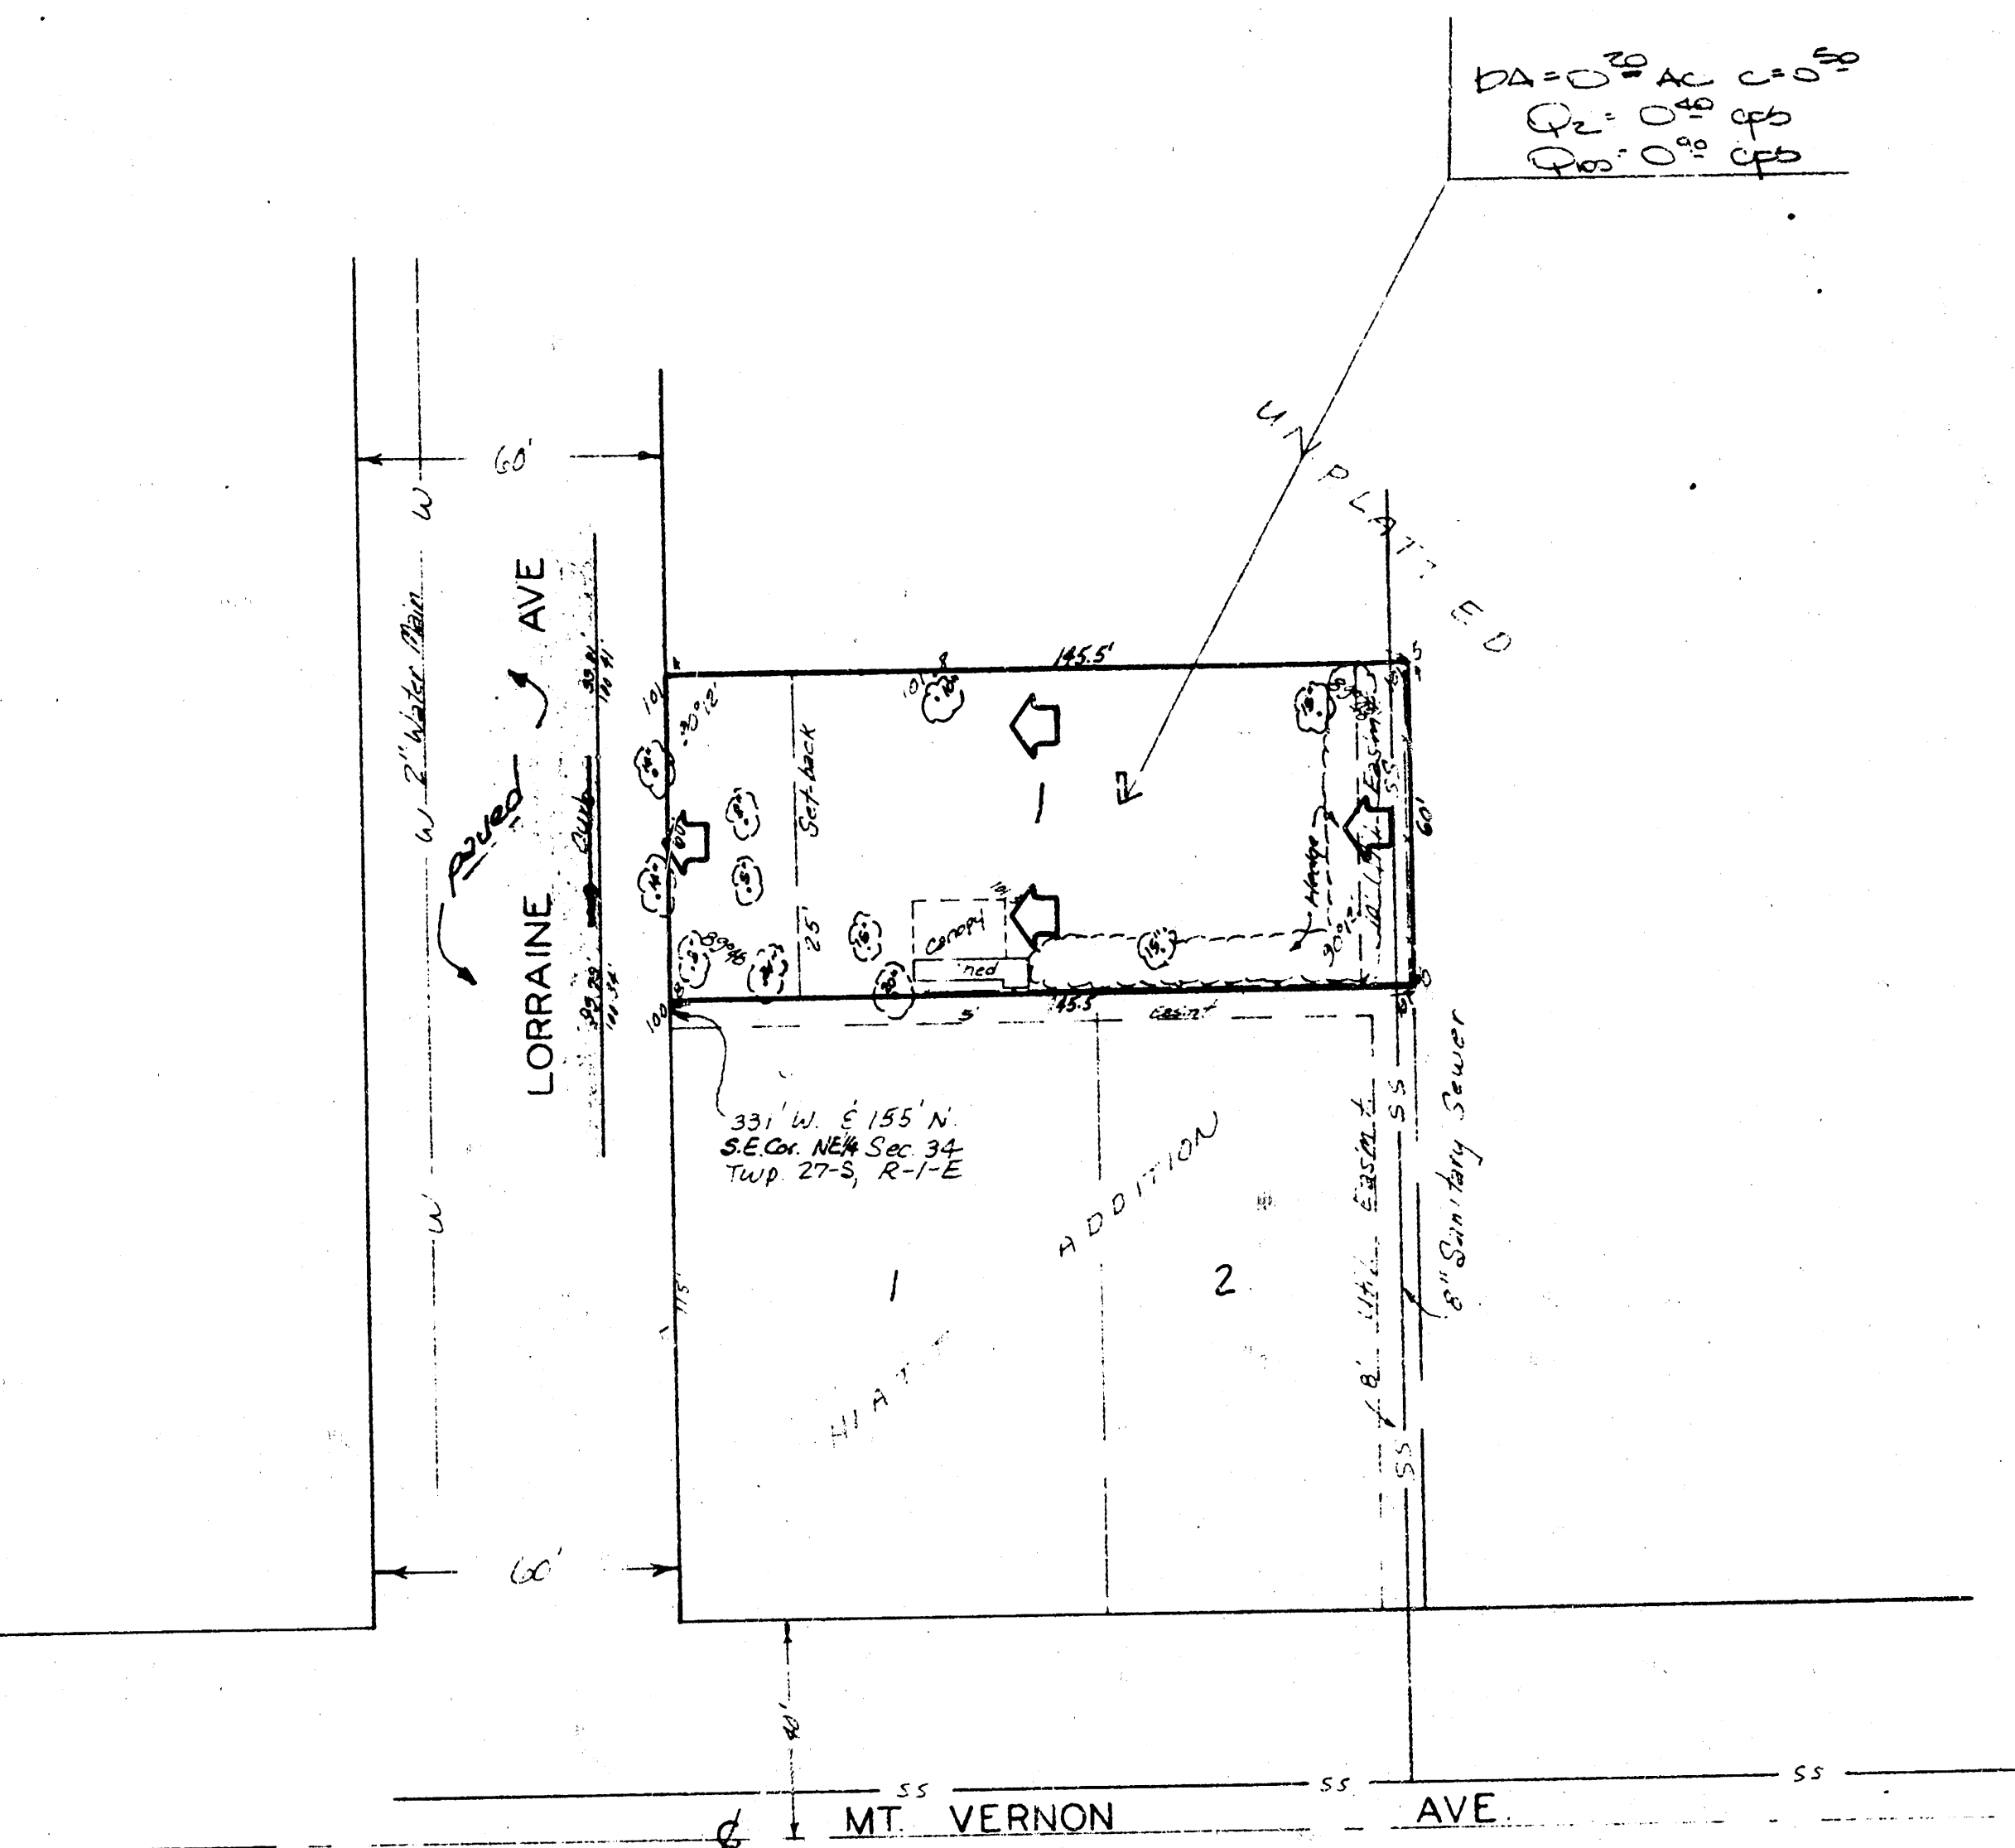

SKETCH PLAT
NORTON ADDITION

TRACT IN THE NE 1/4 OF SEC. 34, TWP. 27-S, R-1-E
OF THE 6TH P.M., SEDAWICK COUNTY, KANSAS.

JOHANN E. AND DELLA E. REMPEL

BAUGHMAN COMPANY, P.A.
SURVEYING & ENGINEERING
316/262-7271 • 330 LAURA • WICHITA, KANSAS 67211

7/7/83

NORTON ADDITION
(DRAINAGE)

BAUGHMAN COMPANY, P.A.
SURVEYING & ENGINEERING
316/262-7271 • 330 LAURA • WICHITA, KANSAS 67211

ENGINEERING
MEMO

PROJECT Norton Addition

DATE July 8, 1983

JOB NO.

COPIES TO:

TO Chris Breitenstein

FROM N. Brent Wooten

REFERENCE Drainage Plan

Final Plat is scheduled for July 21, 1983.

Lot 1 (0.20 AC.) will drain west to Lorraine and south on Lorraine
to Mt. Vernon. Drainage will be discharged to the street thru a
driveway.

PAGE 1 OF 1