


PPC's 2ND ADDITION
(Drainage)

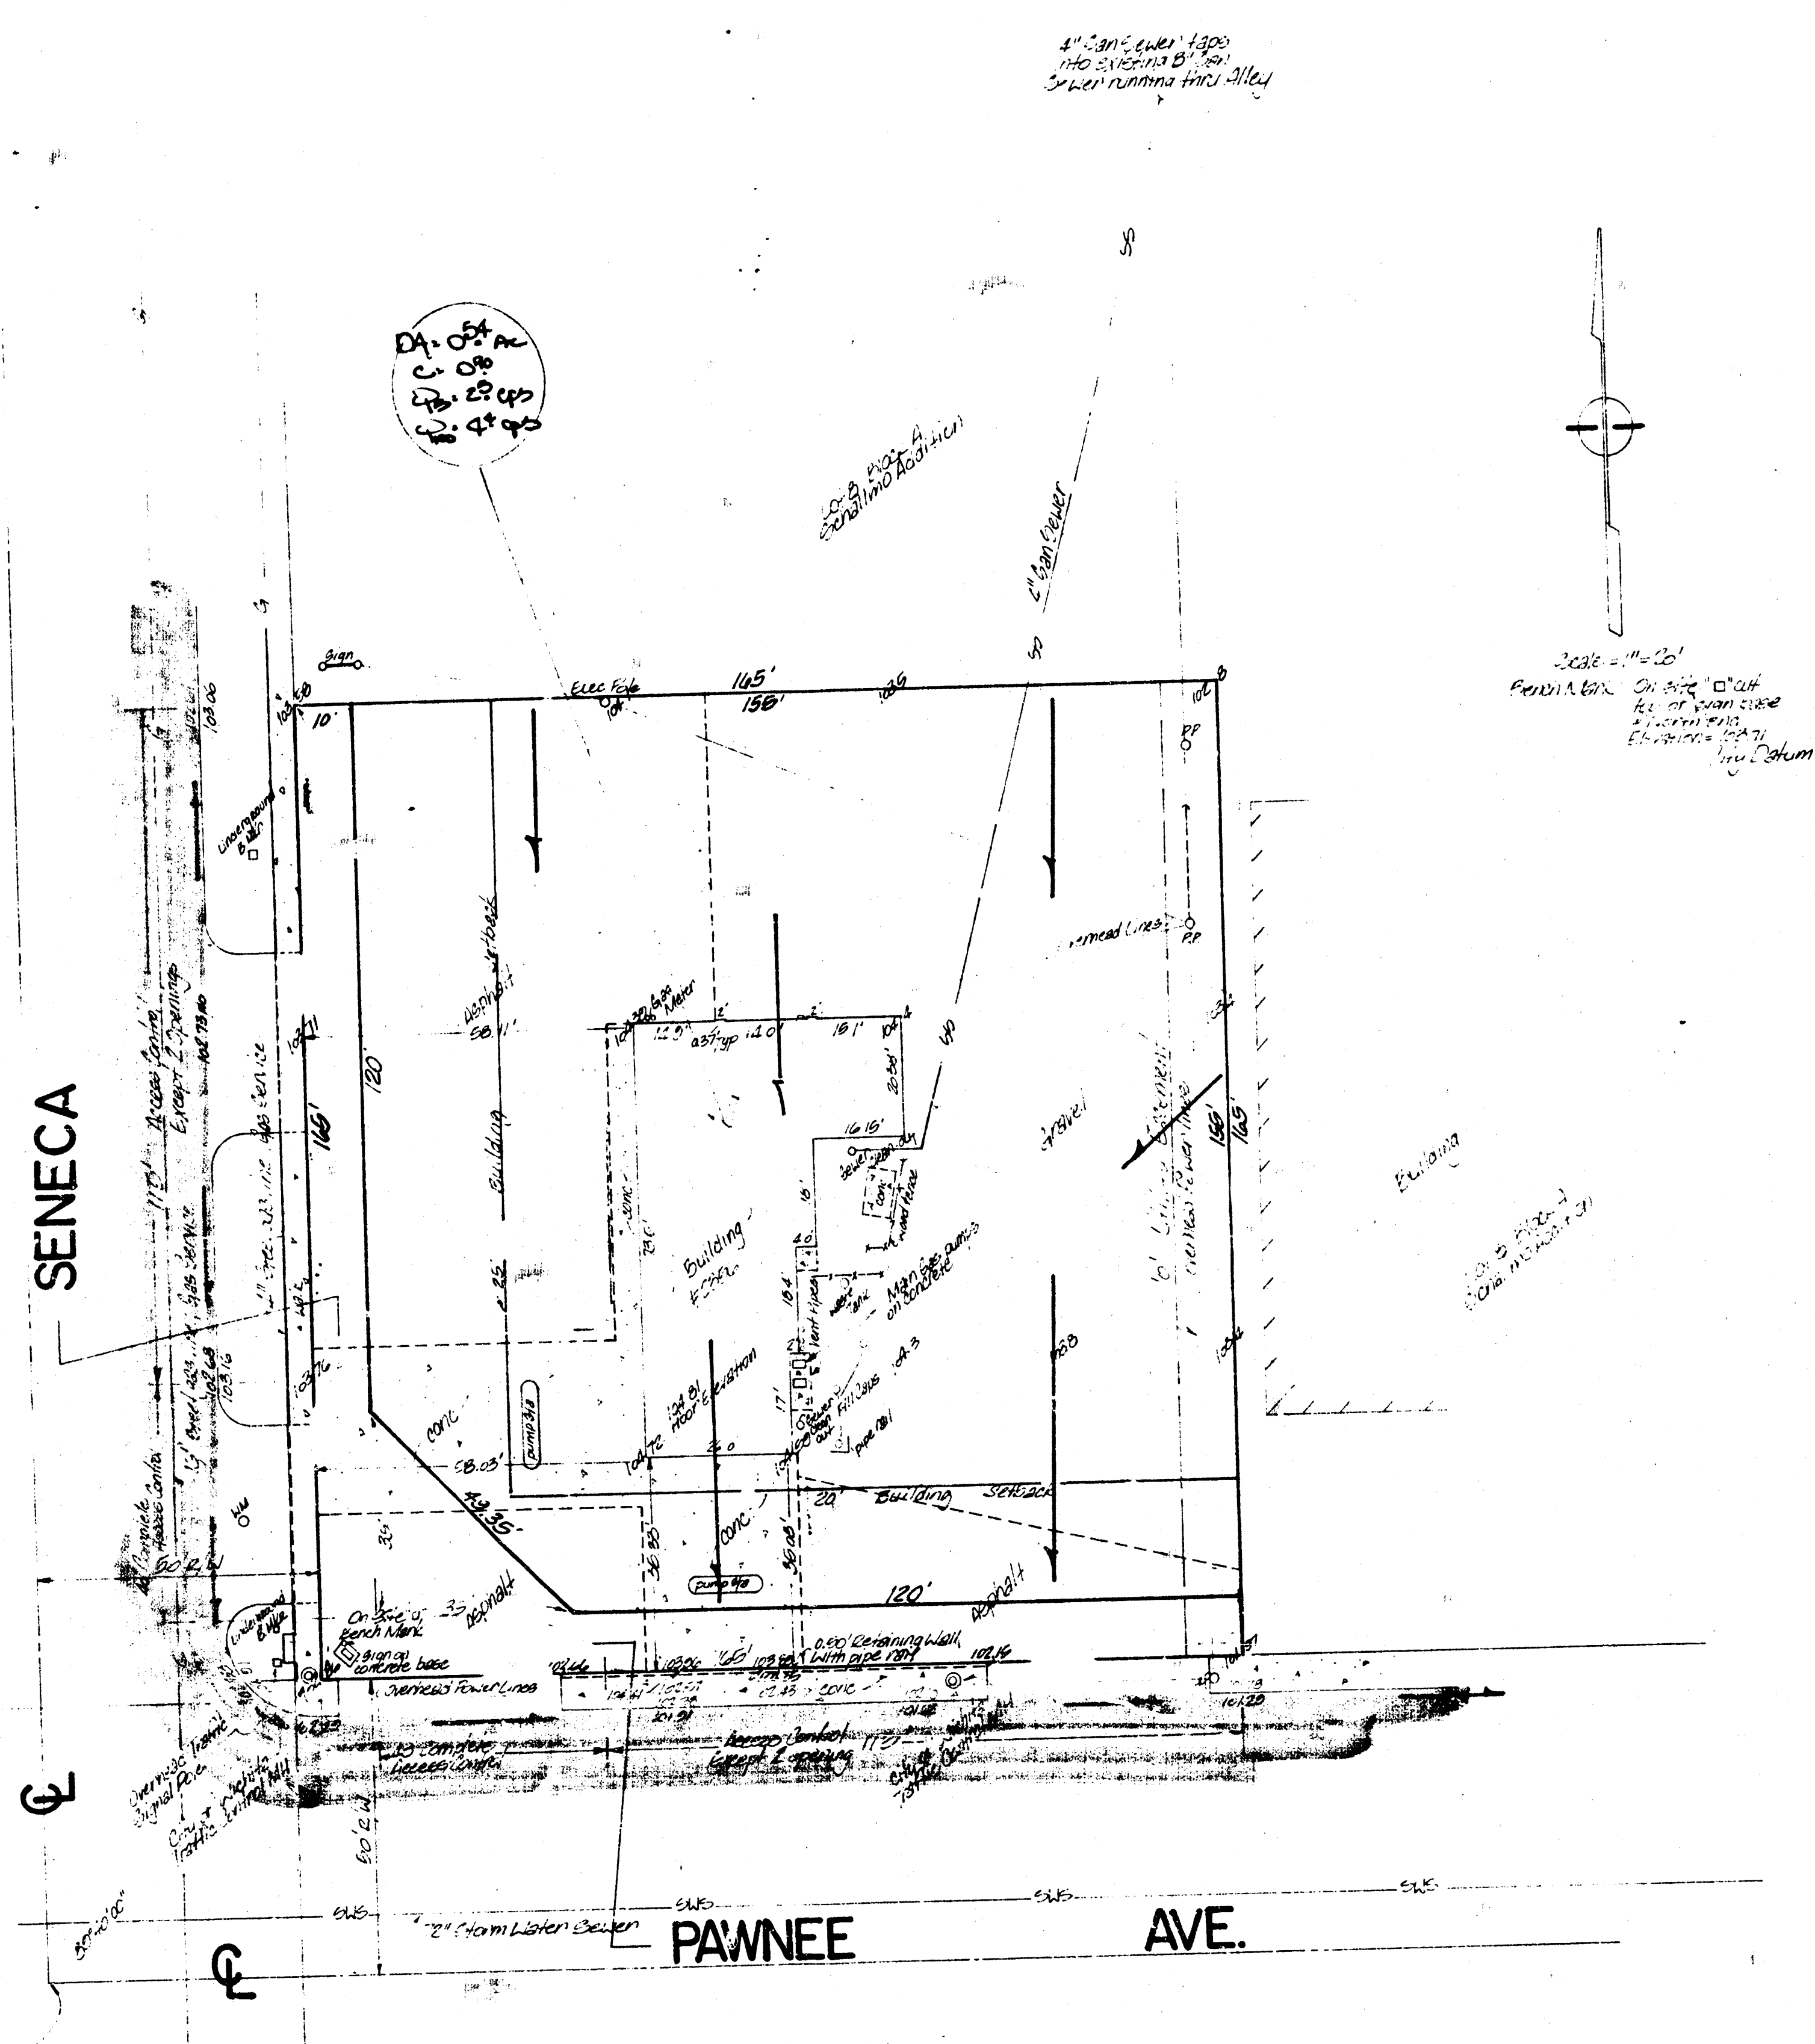

NOTE: 1/4\"/>

Scale - 1\"/>

SKETCH PLAT

PPC's. ADDITION #2

THE WEST 165 FEET OF THE SOUTH 165 FEET
OF LOT 8, BLOCK A, SCHALMO ADDITION

CONTRACT PURCHASER:
PHILLIPS PETROLEUM COMPANY

DRAINAGE PLAN

GENERAL NOTES

The lot will be developed for a service station site. Runoff factor for the lot will be 0.50. The lot will be graded to drain to the streets thru driveways. Pawnee drains to the east to storm sewer inlets.

BAUGHMAN COMPANY, P.A.
SURVEYING & ENGINEERING
3167th St. • 320 LAURA • WICHITA, KANSAS 67211