The Park 4th Add'n

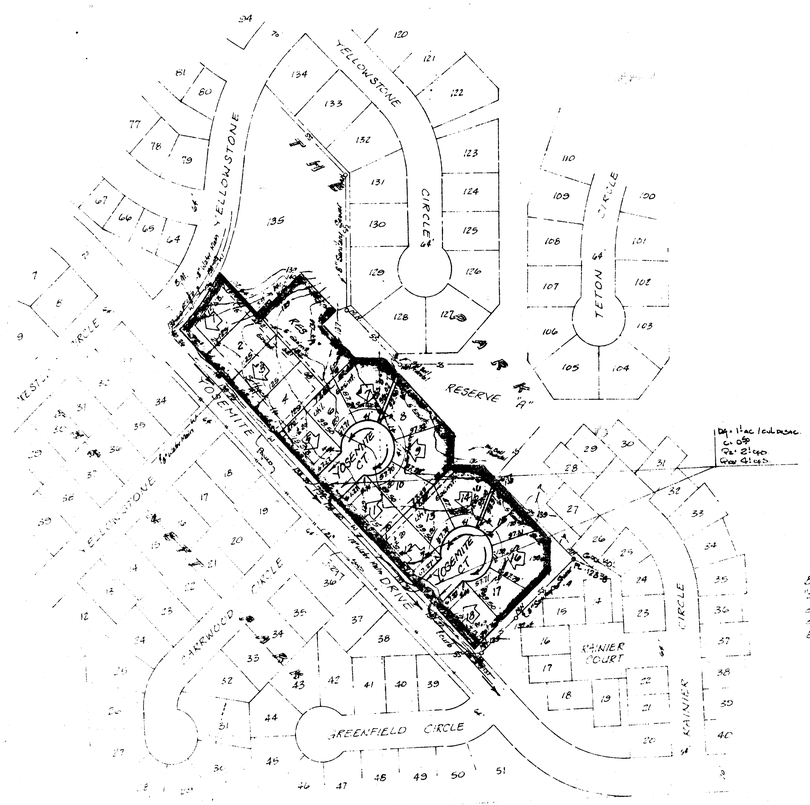

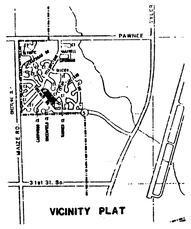

PRELIMINARY PLAT

THE PARK 4TH ADDITION

LOTS 1 THRU 13 AND PART OF LOT 135 AND PART OF RESERVE A, BLOCK 5, THE PARK AN ADDITION TO WICHITA, SEDGWICK COUNTY,

A. J. SOERRIES

DRAINAGE CONCEPT

BAUGHMAN COMPANY, P.A.
SURVEYING & ENGINEERING
316/262-7271 · 315 ELLIS · WICHITA, KANSAS 67211

15 DEC 89
1 DEC 89