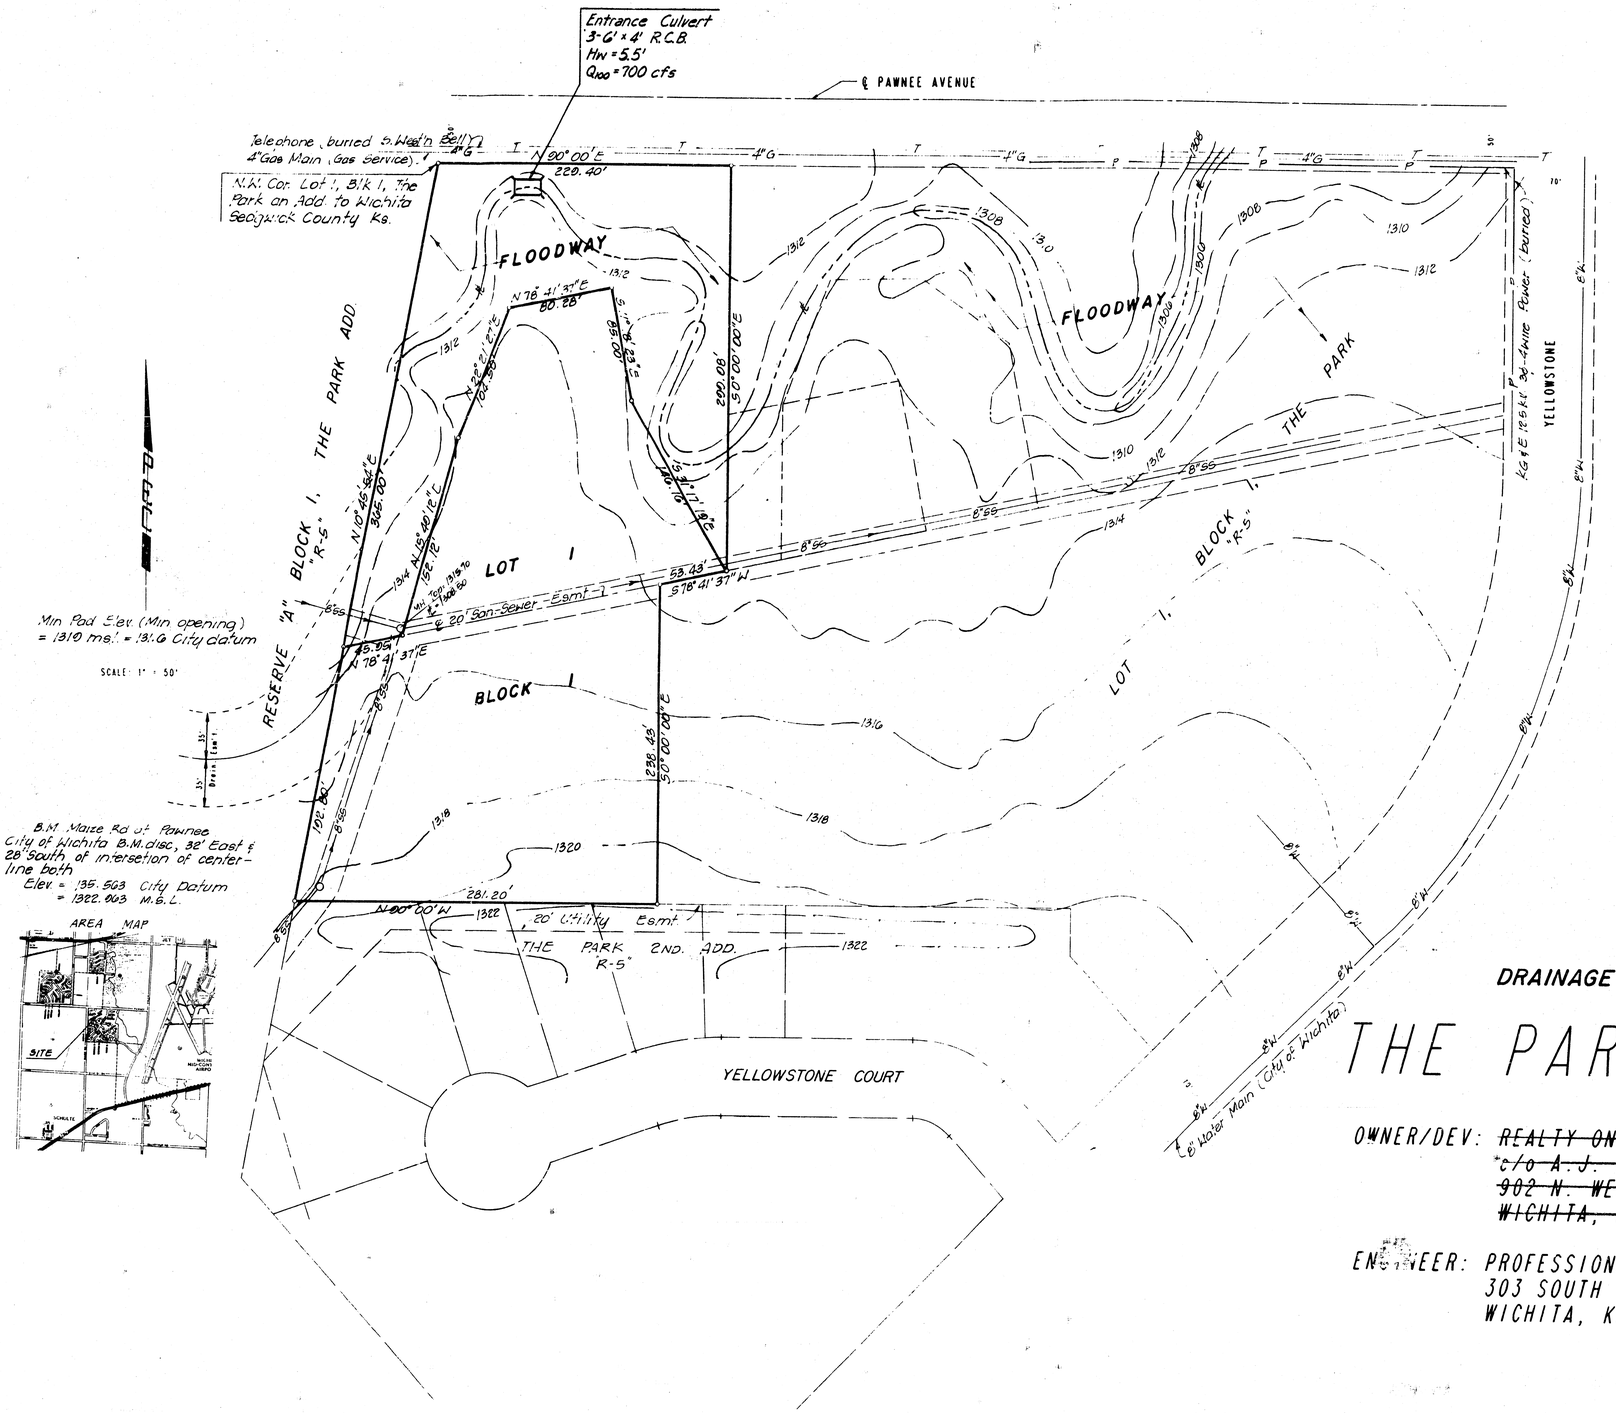


All of Lot 1, Block 1 shall be graded to drain to the floodway via flumes drives, private streets, private storm water sewers and/or other approved drainage facilities.

DRAINAGE PLAN

THE PARK CHATEAU

OWNER/DEV: ~~REALTY ONE CORP.~~ MARK A. WHITESIDE
~~c/o A.J. SOERRIES~~ 500 S. ROLLAND
~~902 N. WEST STREET~~ STE. 210
~~WICHITA, KS 67203~~ WICHITA, KS. 67209

ENGINEER: PROFESSIONAL ENGINEERING CONSULTANTS, P.A.
303 SOUTH TOPEKA
WICHITA, KS. 67202

CHARLES S. BROWN
LICENSED
7581
KANSAS
PROFESSIONAL ENGINEER