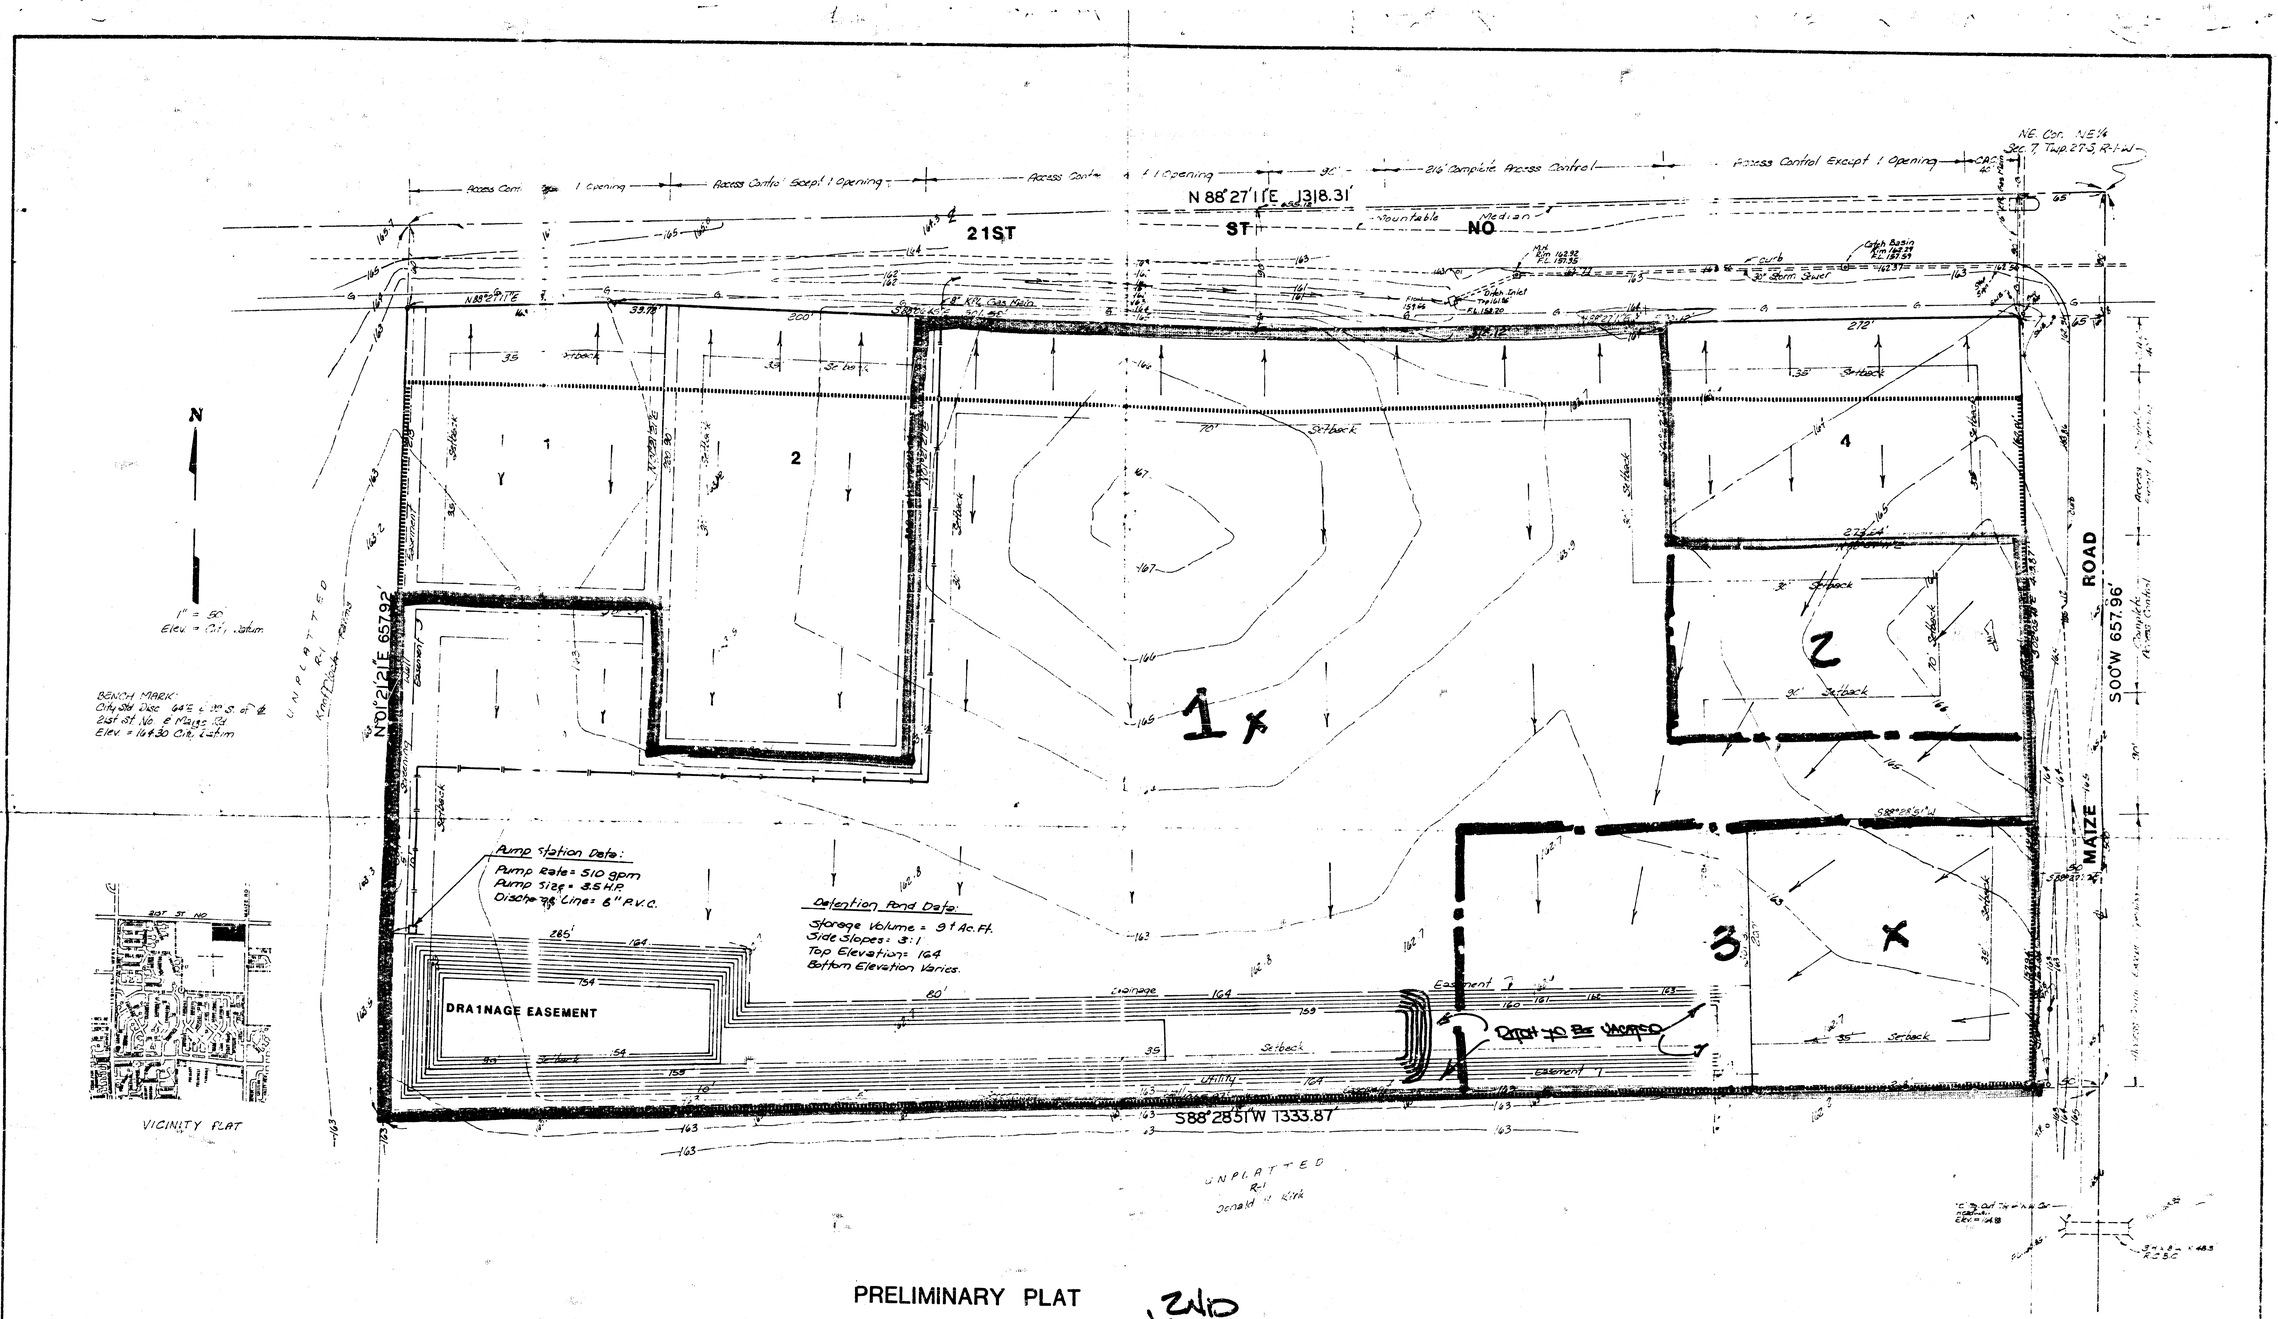


VICINITY PLAT

PRELIMINARY PLAT

PEARSON FARMS 2ND ADDITION

N1/2, NE1/4, NE1/4, SEC 7, TWP 27-S, R-1-W

BRUCE A. PEARSON
ESTHER L. PEARSON

APPROVED
DRAINAGE PLAN

BAUGHMAN COMPANY, P.A.
SURVEYING & ENGINEERING
316/262-7271 • 315 ELLIS • WICHITA, KANSAS 67211

Rev.
JW691