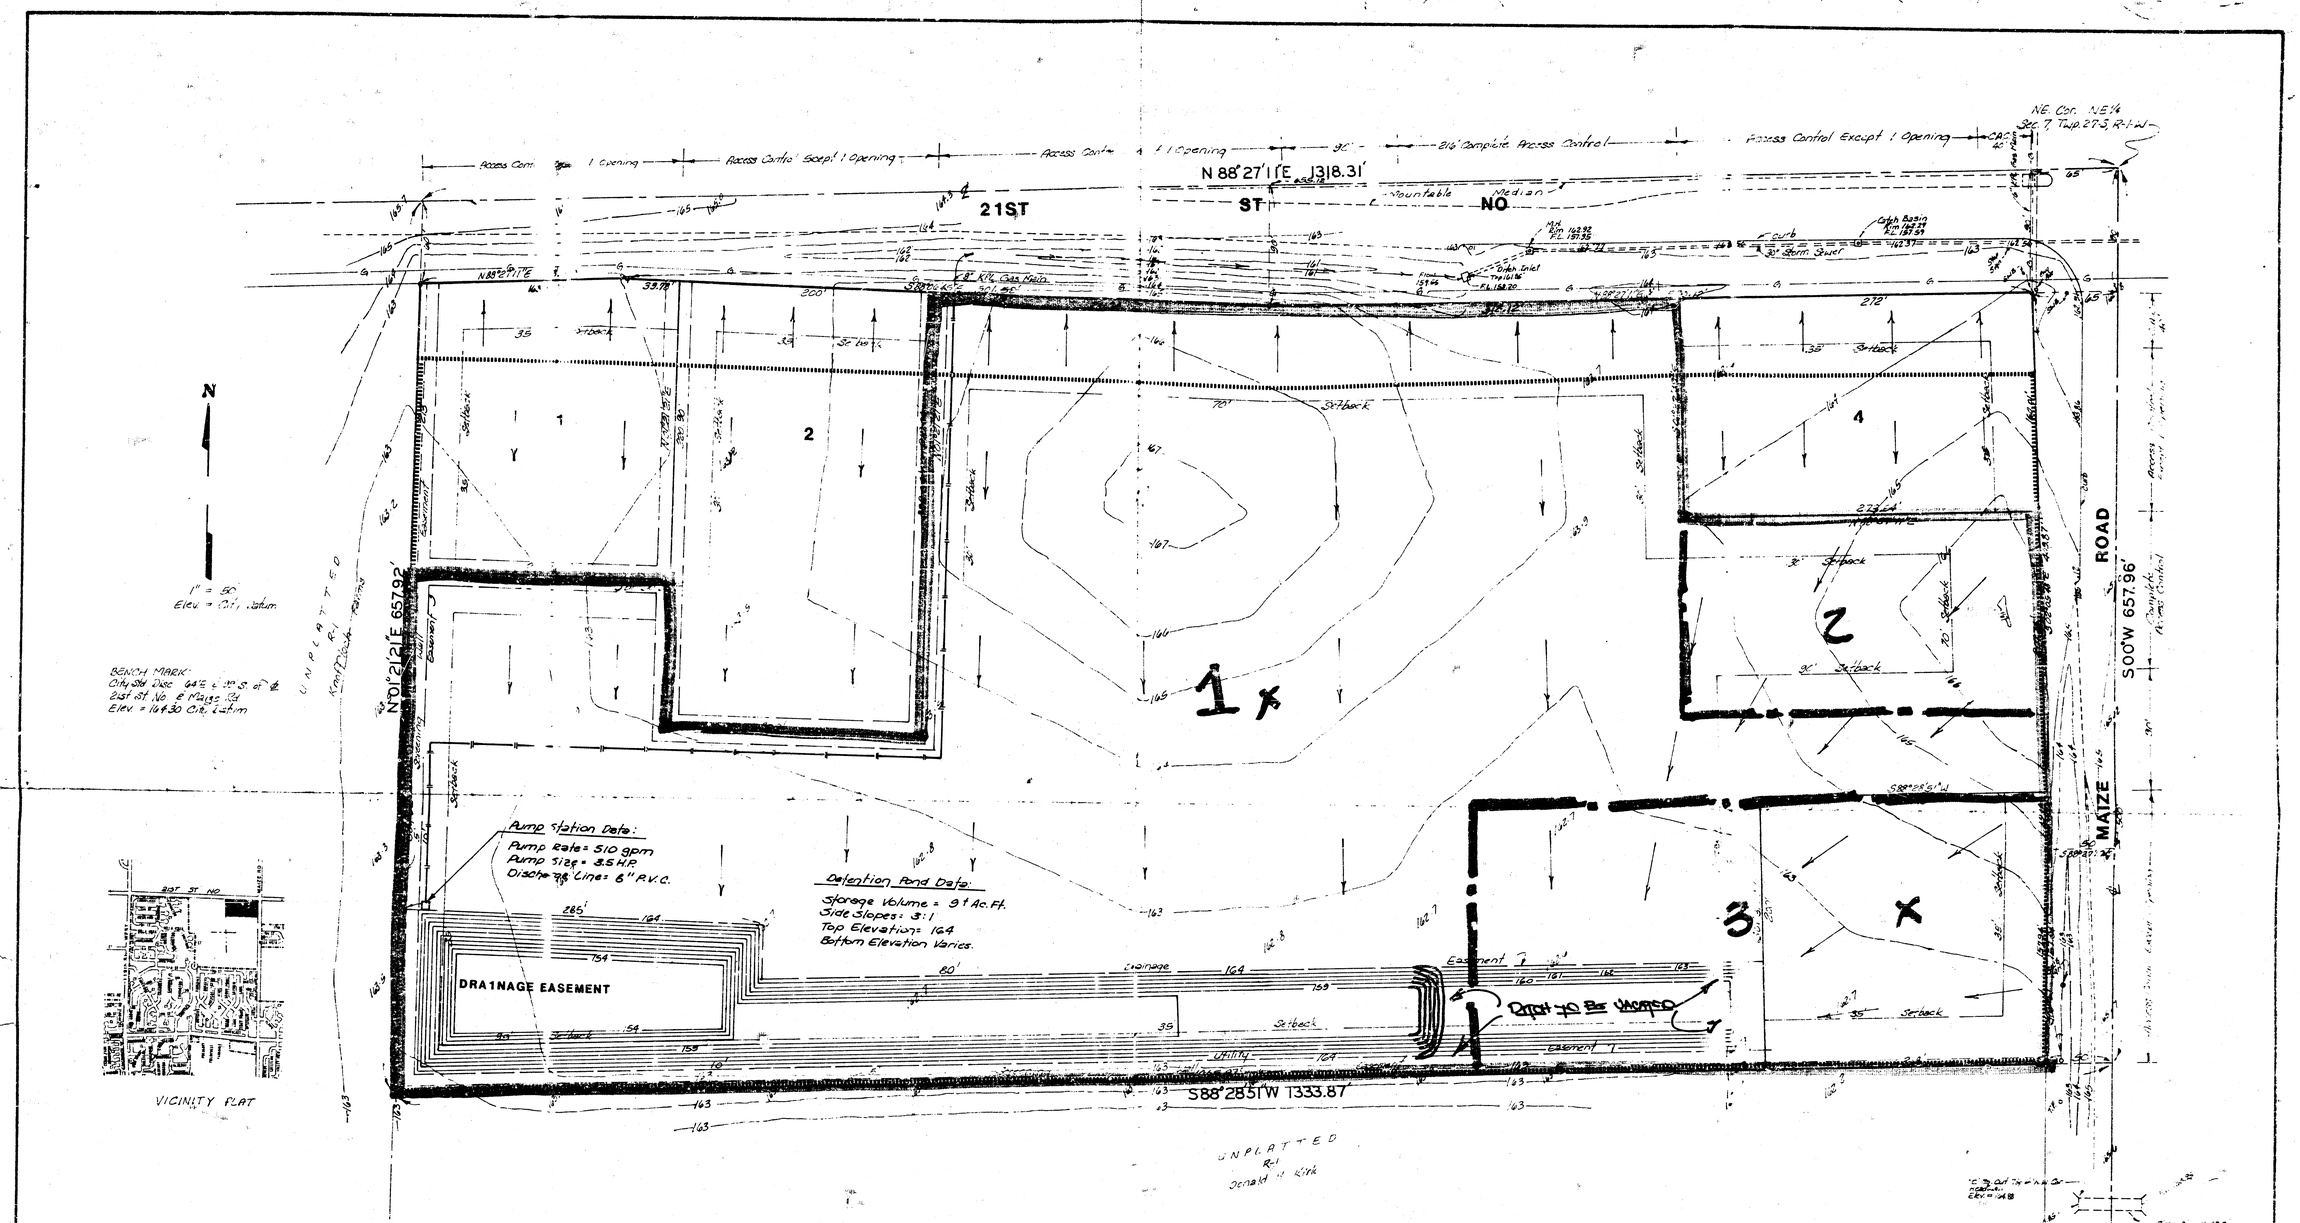
21ST ST NO
N 88°27'11"E 1318.31'
Mountable Median
Access Control Except 1 Opening
216' Complete Access Control
NE. Cor. NE¼ Sec. 7, Twp. 27 S, R-1-W
N 88°27'11"E
N01°21'21"E 657.92'
S00°W 657.96'
MAIZE ROAD
S88°28'51"W 1333.87
1
2
3
4
Setback
Drainage Easement
Utility Easement
Pump Station Data:
Pump Rate = 510 gpm
Pump Size = 3.5 H.P.
Discharge Line = 6" P.V.C.
Detention Pond Data:
Storage Volume = 3.1 Ac. Ft.
Side Slopes = 3:1
Top Elevation = 164
Bottom Elevation Varies.
DRAINAGE EASEMENT
Drainage Easement
Utility Easement
Drainage Easement
Drainage Easement
Drainage