

BAUGHMAN COMPANY, P.A.
SURVEYING & ENGINEERING
315/262-7271 • 330 LAURA • WICHITA, KANSAS 67211

CONFIRMATION
MEMO

PROJECT Pilgrim Congregational Church
DATE 9-19-83
TO CHAS BREHENSTEIN
FROM BO WOOTEN
REFERENCE DRAINAGE PLAN

COPIES TO:

Plan is scheduled for subdivision for
29, 1983.


Lot 1 will remain as it presently exists
for development purposes. The NW corner
of Lot 1 which is parking lot and bldg. drains
north and east to FABRIQUE. A CONVEYANCE
PATCH DISCHARGES THE PARKING LOT AREA AND
THE TYPICAL SECTION AND CAPACITY ARE INDICATED
R100 = 10" cfs C: 0.5"

THE REMAINDER OF Lot 1 (2.0 AC) DRAINS
EAST TO FABRIQUE.

Lot 2 (OFFICE DEVELOPMENT) WILL DRAIN EAST
TO FABRIQUE THRU DRAIN OR FLUMES.

15" AND 18" STORM SEWER PIPE DISCHARGE
FABRIQUE INTO THE CREEK.

PAGE 1 OF 1

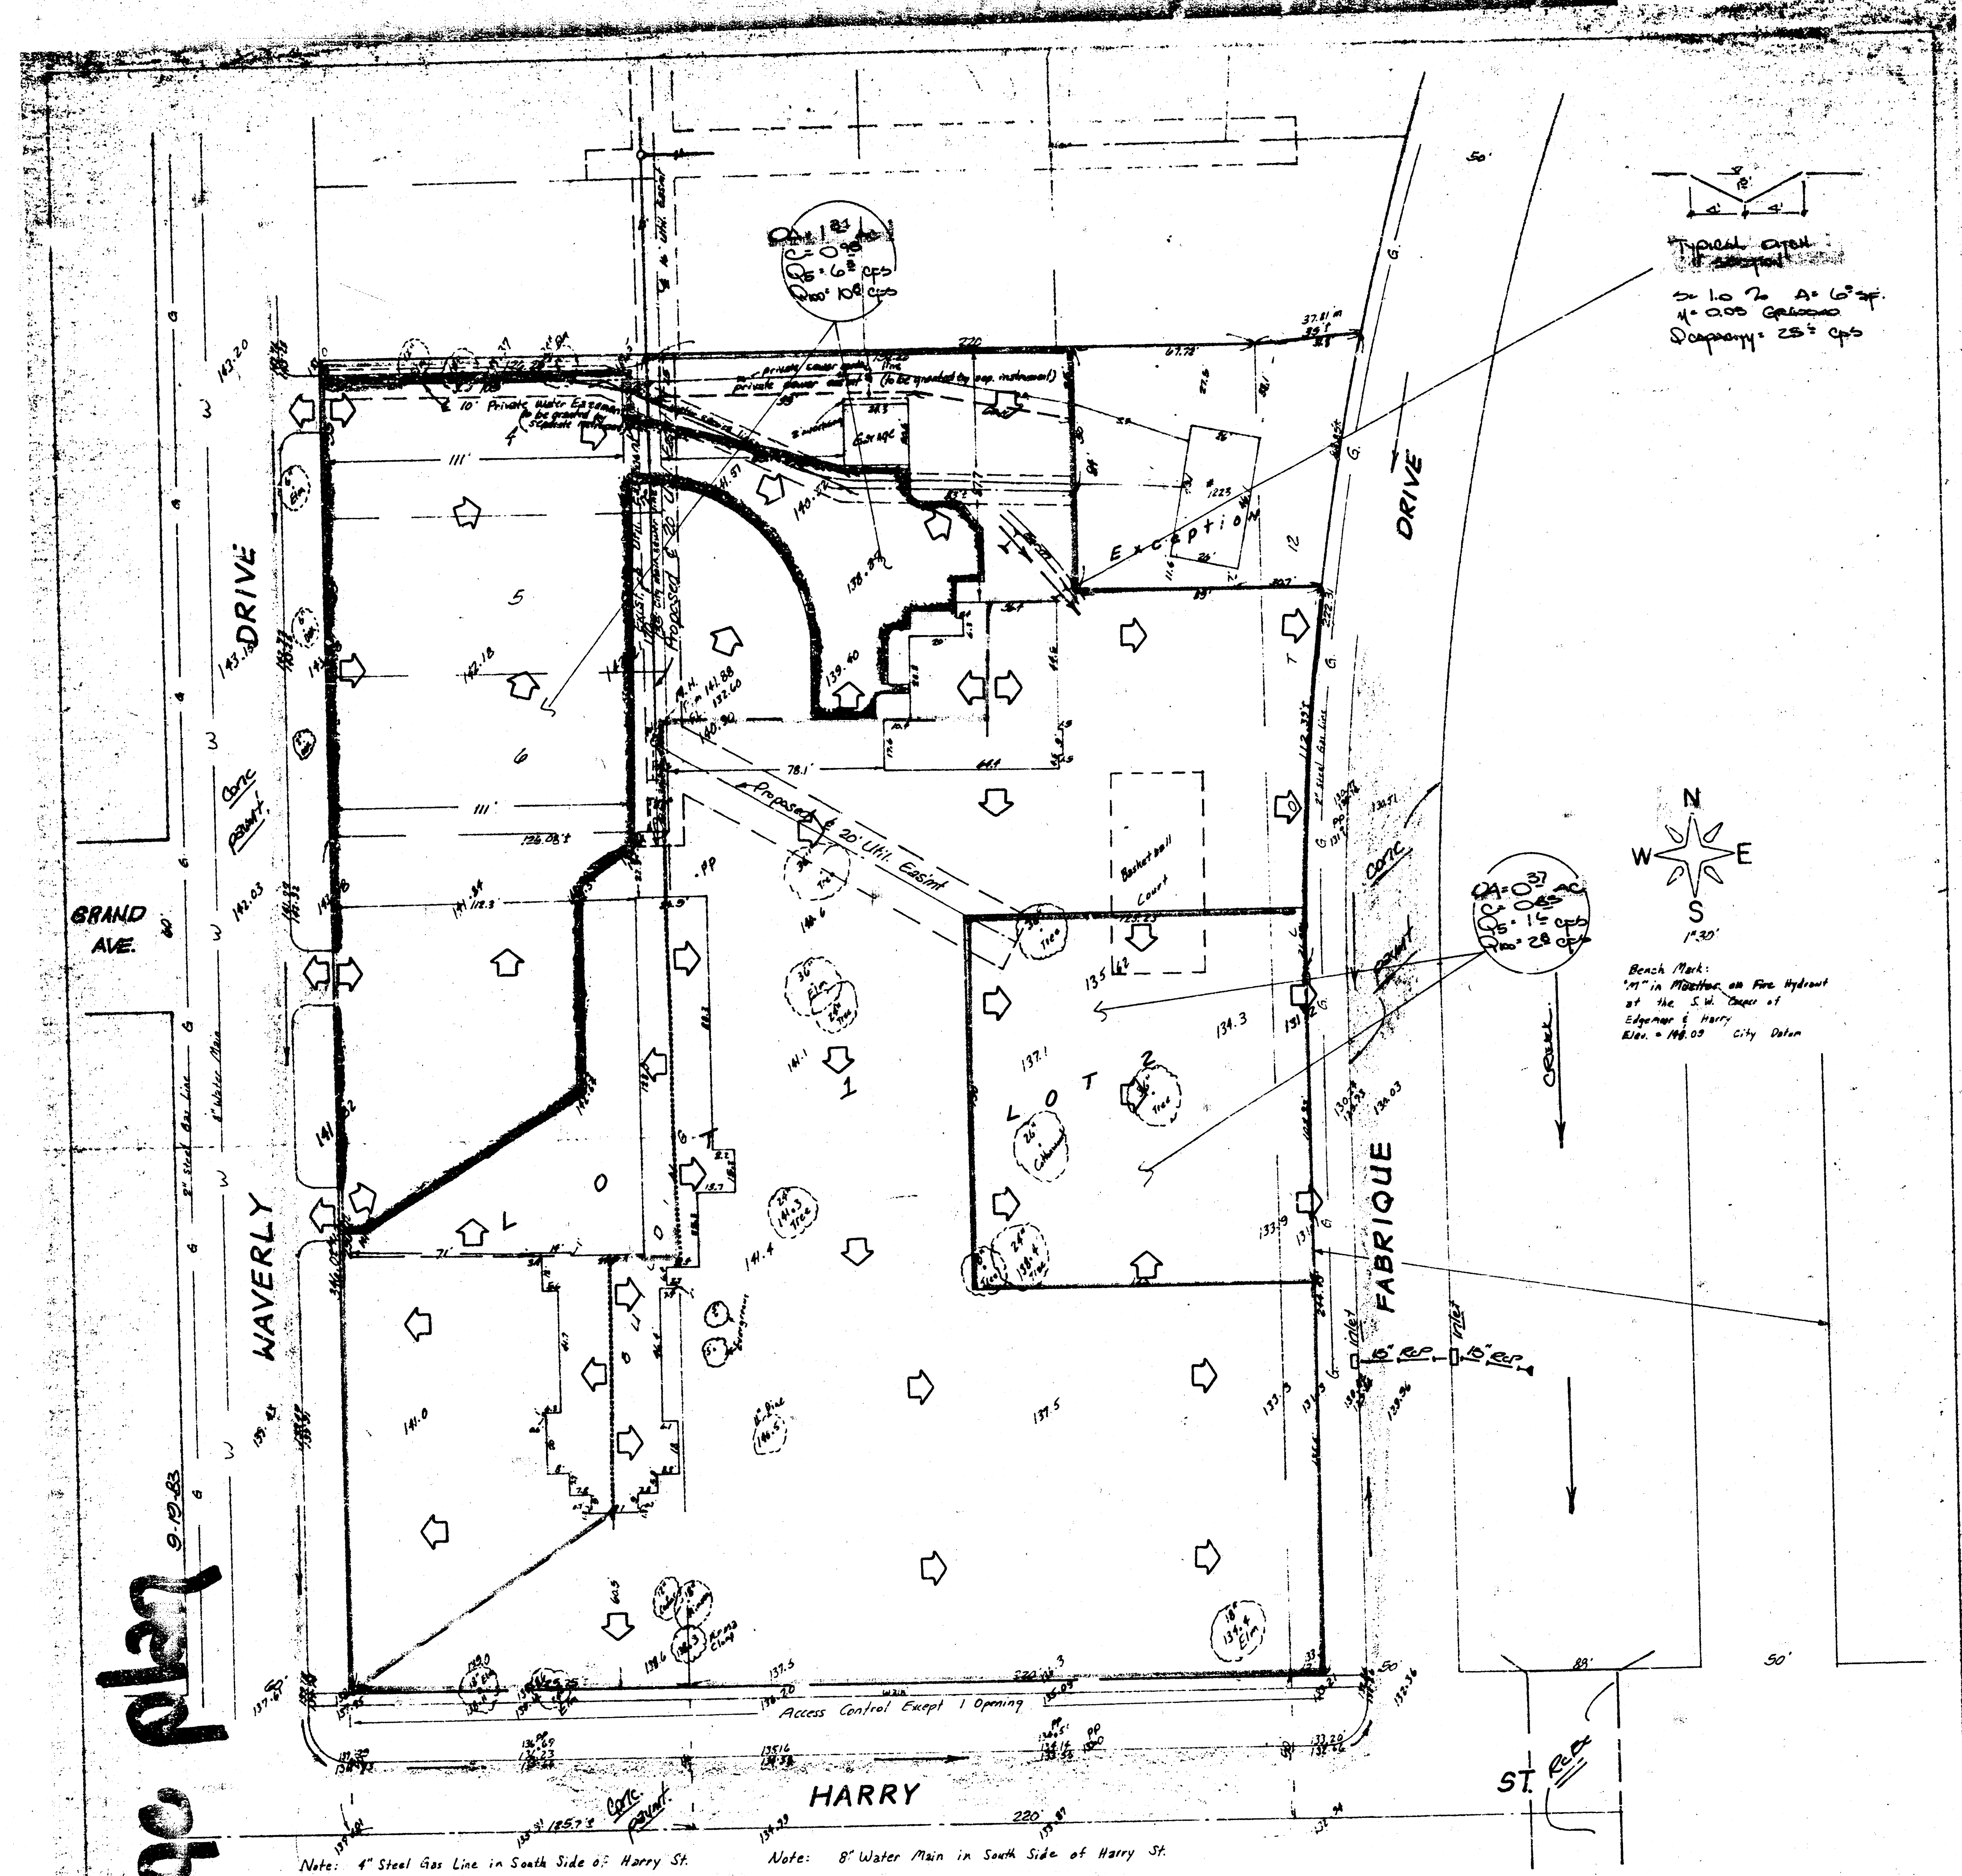

drainage plan 9-19-83

SKETCH PLAT

PILGRIM CONGREGATIONAL CHURCH ADDITION

Part of Lot 12, Block 7, Lincoln Hill Addition to Wichita, Kansas and a tract
in the S.E. 1/4 of Sec 25, TWP. 27-S, R-1-E of the 6th RM, Sedgewick County Kansas.

PILGRIM CONGREGATIONAL CHURCH

BAUGHMAN COMPANY, P.A.
SURVEYING & ENGINEERING
315/262-7271 • 330 LAURA • WICHITA, KANSAS 67211