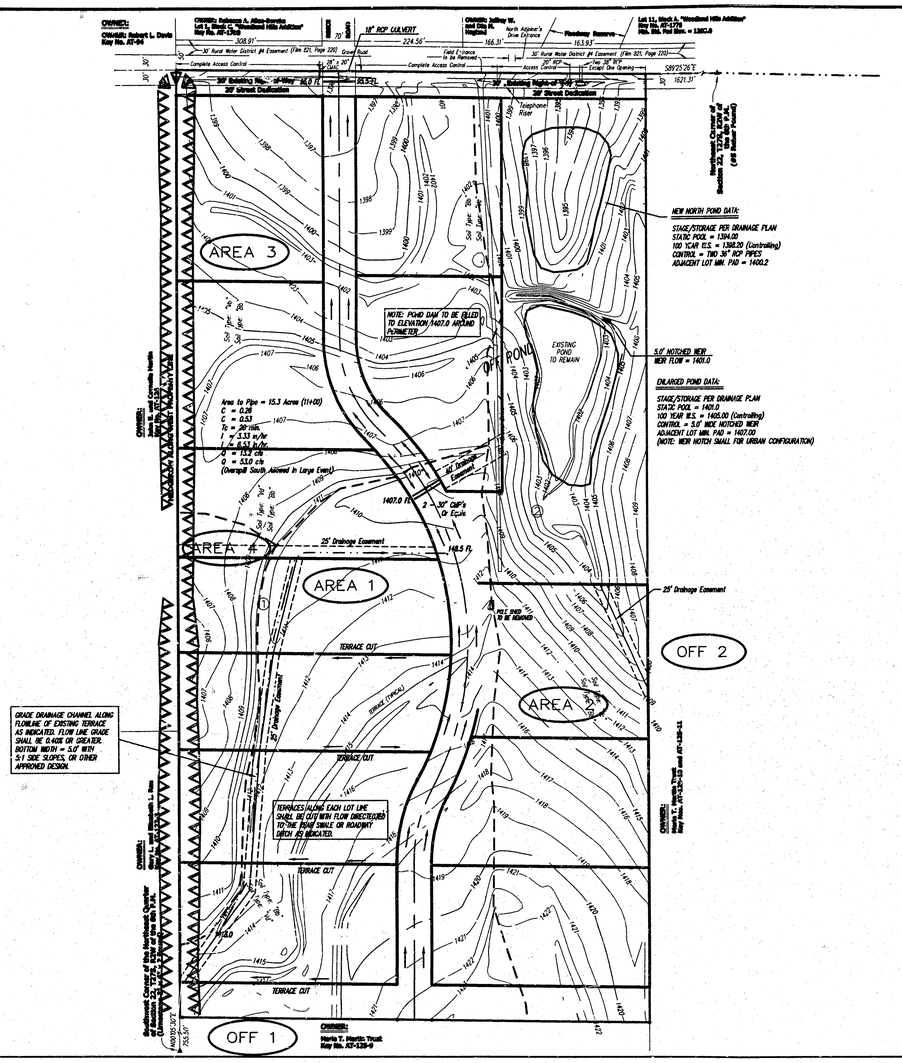

DRAINAGE PLAN – 2.5 ACRE LOT

"PRAIRIE CROSSING"

AN ADDITION TO SEDGWICK COUNTY, KANSAS

IN THE NORTHEAST QUARTER OF SECTION 22, TOWNSHIP 27 SOUTH, RANGE 2 WEST OF THE 6TH P.M.

SCALE : 1" = 100'

1 25 50 100 200

▲ = Section Corner Found as noted

● = 64 Rebar Set with I.D. Cap "TYLSE CLS22"

Bearing Basis Assumed

Contour Interval = One Foot

Date of Topography : June 7, 2002

Date of Preparation : June 13, 2002

BENCH MARK:
County Bench Mark, Railroad Spike in High Line Pole 10' Northwest of Northeast Corner of Section 22, T27S, R2W of the 6th P.M.

Elevation: 1390.66 MSL

NOTE:
See Sheet 2 of 2 For Setback Requirements.

SOIL TYPES:
Soil Types Shown as Scaled from the Soil Survey of Sedgwick County, Kansas Sheet No. 40, Issued April 1979.

"Ba" = Blanket Soil
"Vc", "Vd", and "Ve" = Venoco Soil

REVISED 12-09-2002

DRAINAGE PLAN – 2.5 ACRE LOTS
"PRAIRIE CROSSING"

Ruggles & Bohm, P.A.
Engineering, Surveying, Land Planning
604 North Main
Wichita, Kansas 67203
www.rbkansas.com
(316) 264-8008
(316) 264-4621 fax
E-mail: info@rbkansas.com

DRAWN BY: CMB
CHECKED:
PLANNER:
APPROVED:
DATE: 11-15-02
SHEET 2 of 2

DRAWING FILE: drainage plan - urban
PROJECT NUMBER: 2247D