


**HOLLOWAY
ARCHITECTS**

11900 WEST 87TH STREET PARKWAY
SUITE 160, LENEXA, KANSAS 66215
913-894-0707 FAX 913-894-9291

**QUIKTRIP
NO. 313R**

31ST STREET SOUTH
AND HILLSIDE AVE.
WICHITA, KANSAS

PRELIMINARY

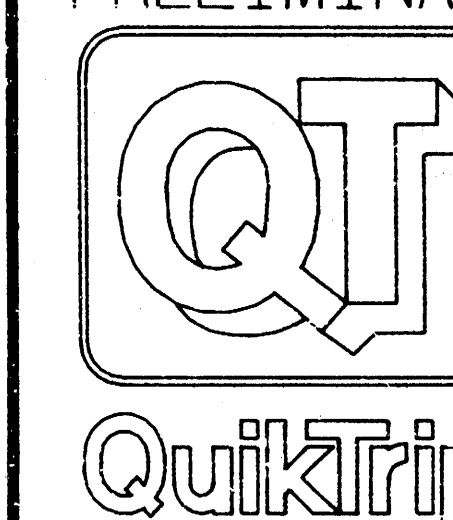


db.qt313r

REVISIONS
12/7/90

DATE: 11/30/90
SHEET NUMBER

2

OF 3

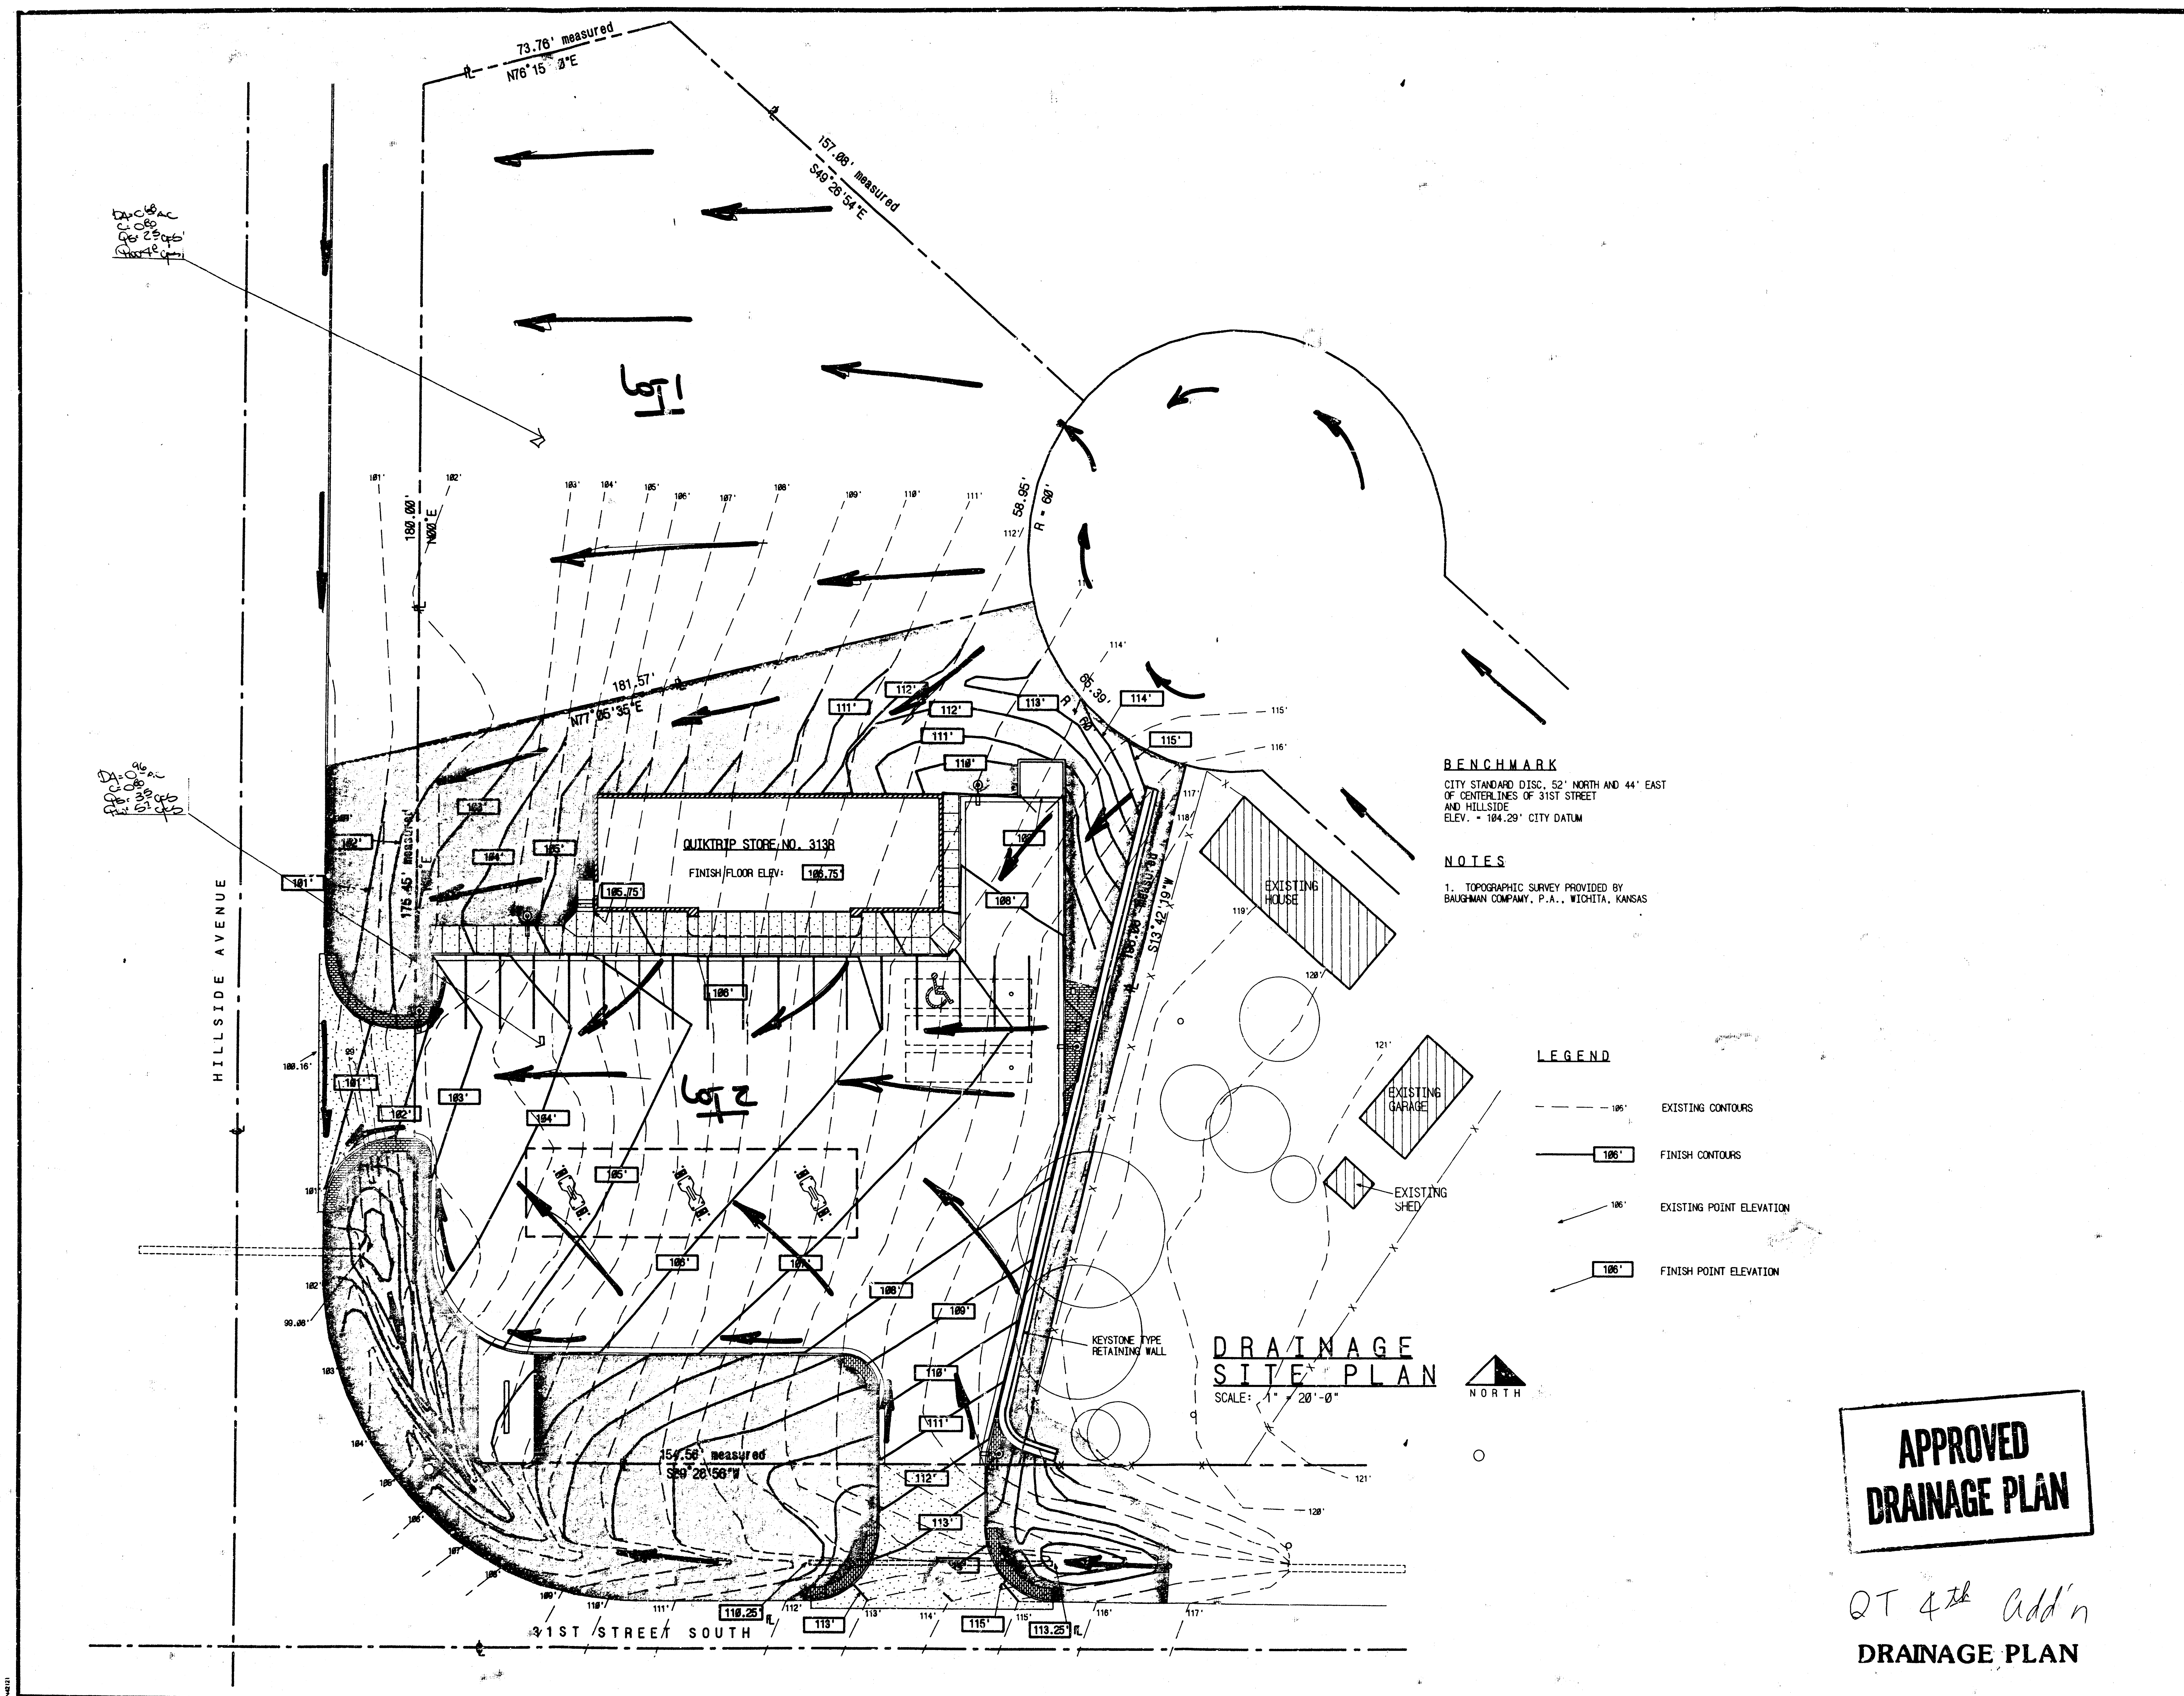

BENCHMARK
CITY STANDARD DISC, 52' NORTH AND 44' EAST
OF CENTER LINES OF 31ST STREET
AND HILLSIDE
ELEV. = 104.29' CITY DATUM

NOTES
1. TOPOGRAPHIC SURVEY PROVIDED BY
BAUGHMAN COMPANY, P.A., WICHITA, KANSAS

LEGEND

- 105' --- EXISTING CONTOURS
- 106' --- FINISH CONTOURS
- 106' EXISTING POINT ELEVATION
- 106' FINISH POINT ELEVATION

**DRAINAGE
SITE PLAN**

SCALE: 1" = 20'-0"



**APPROVED
DRAINAGE PLAN**

QT 4th Add'n
DRAINAGE PLAN