



1000 WEST 87TH STREET PARKWAY
SUITE 100, LENEXA, KANSAS 66215
913-894-0707 FAX 913-894-9291

QUIKTRIP
NO. 301

21ST ST. & ARKANSAS
WICHITA, KANSAS



QuikTrip
PRELIMINARY


FILE
QT301.DWG

REVISIONS

DATE 6/8/95
SHEET NUMBER

2

DRAINAGE Plan

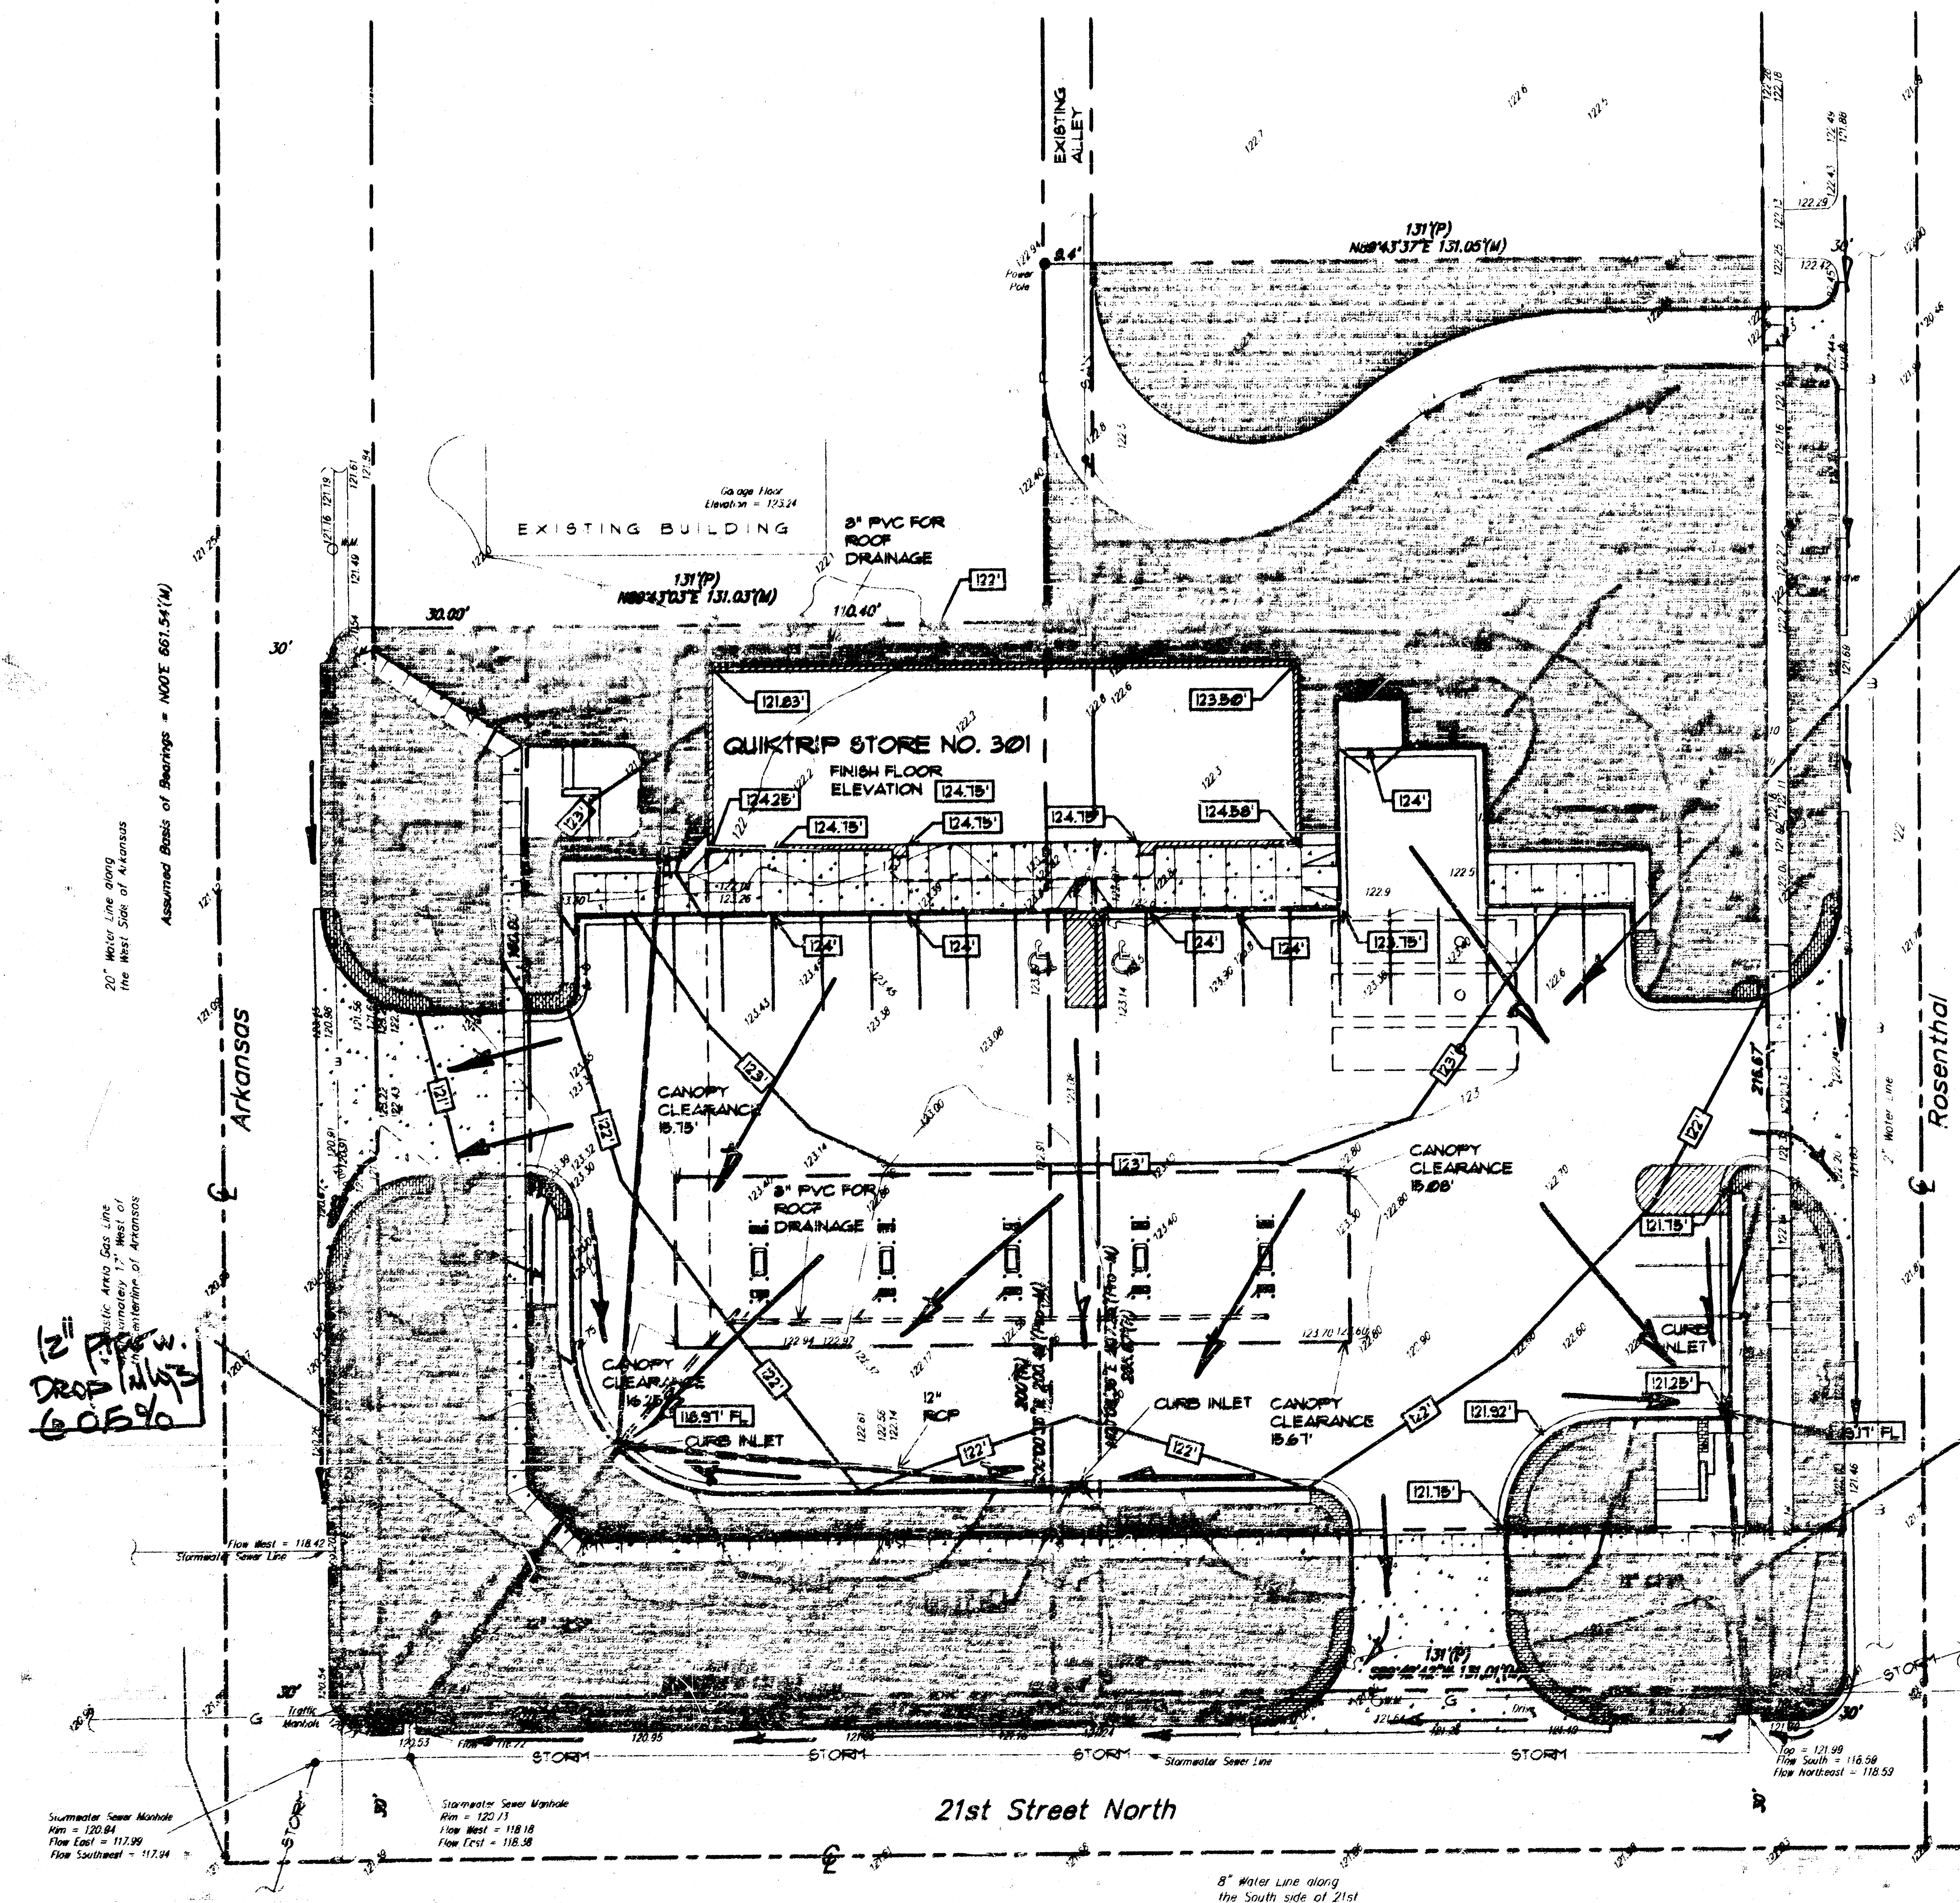

DA = 10 ac
C = 0.90
Q₁₀₀ = 4.0 cfs Q₅₀ = 6.7 cfs

BENCHMARK: 25th Street North and Arkansas
City of Wichita Disc 40' South and 32' West of
the centerline of both Elevation = 127.63 (City Datum)

LEGEND

- 135.9 EXISTING CONTOURS
- 135.9 FINISH CONTOURS
- 135.9 EXISTING POINT ELEVATION
- 135.9 FINISH POINT ELEVATION

12" pipe w.
drop inlet
6.05% slope



DRAINAGE SITE PLAN

SCALE: 1" = 20'-0"