
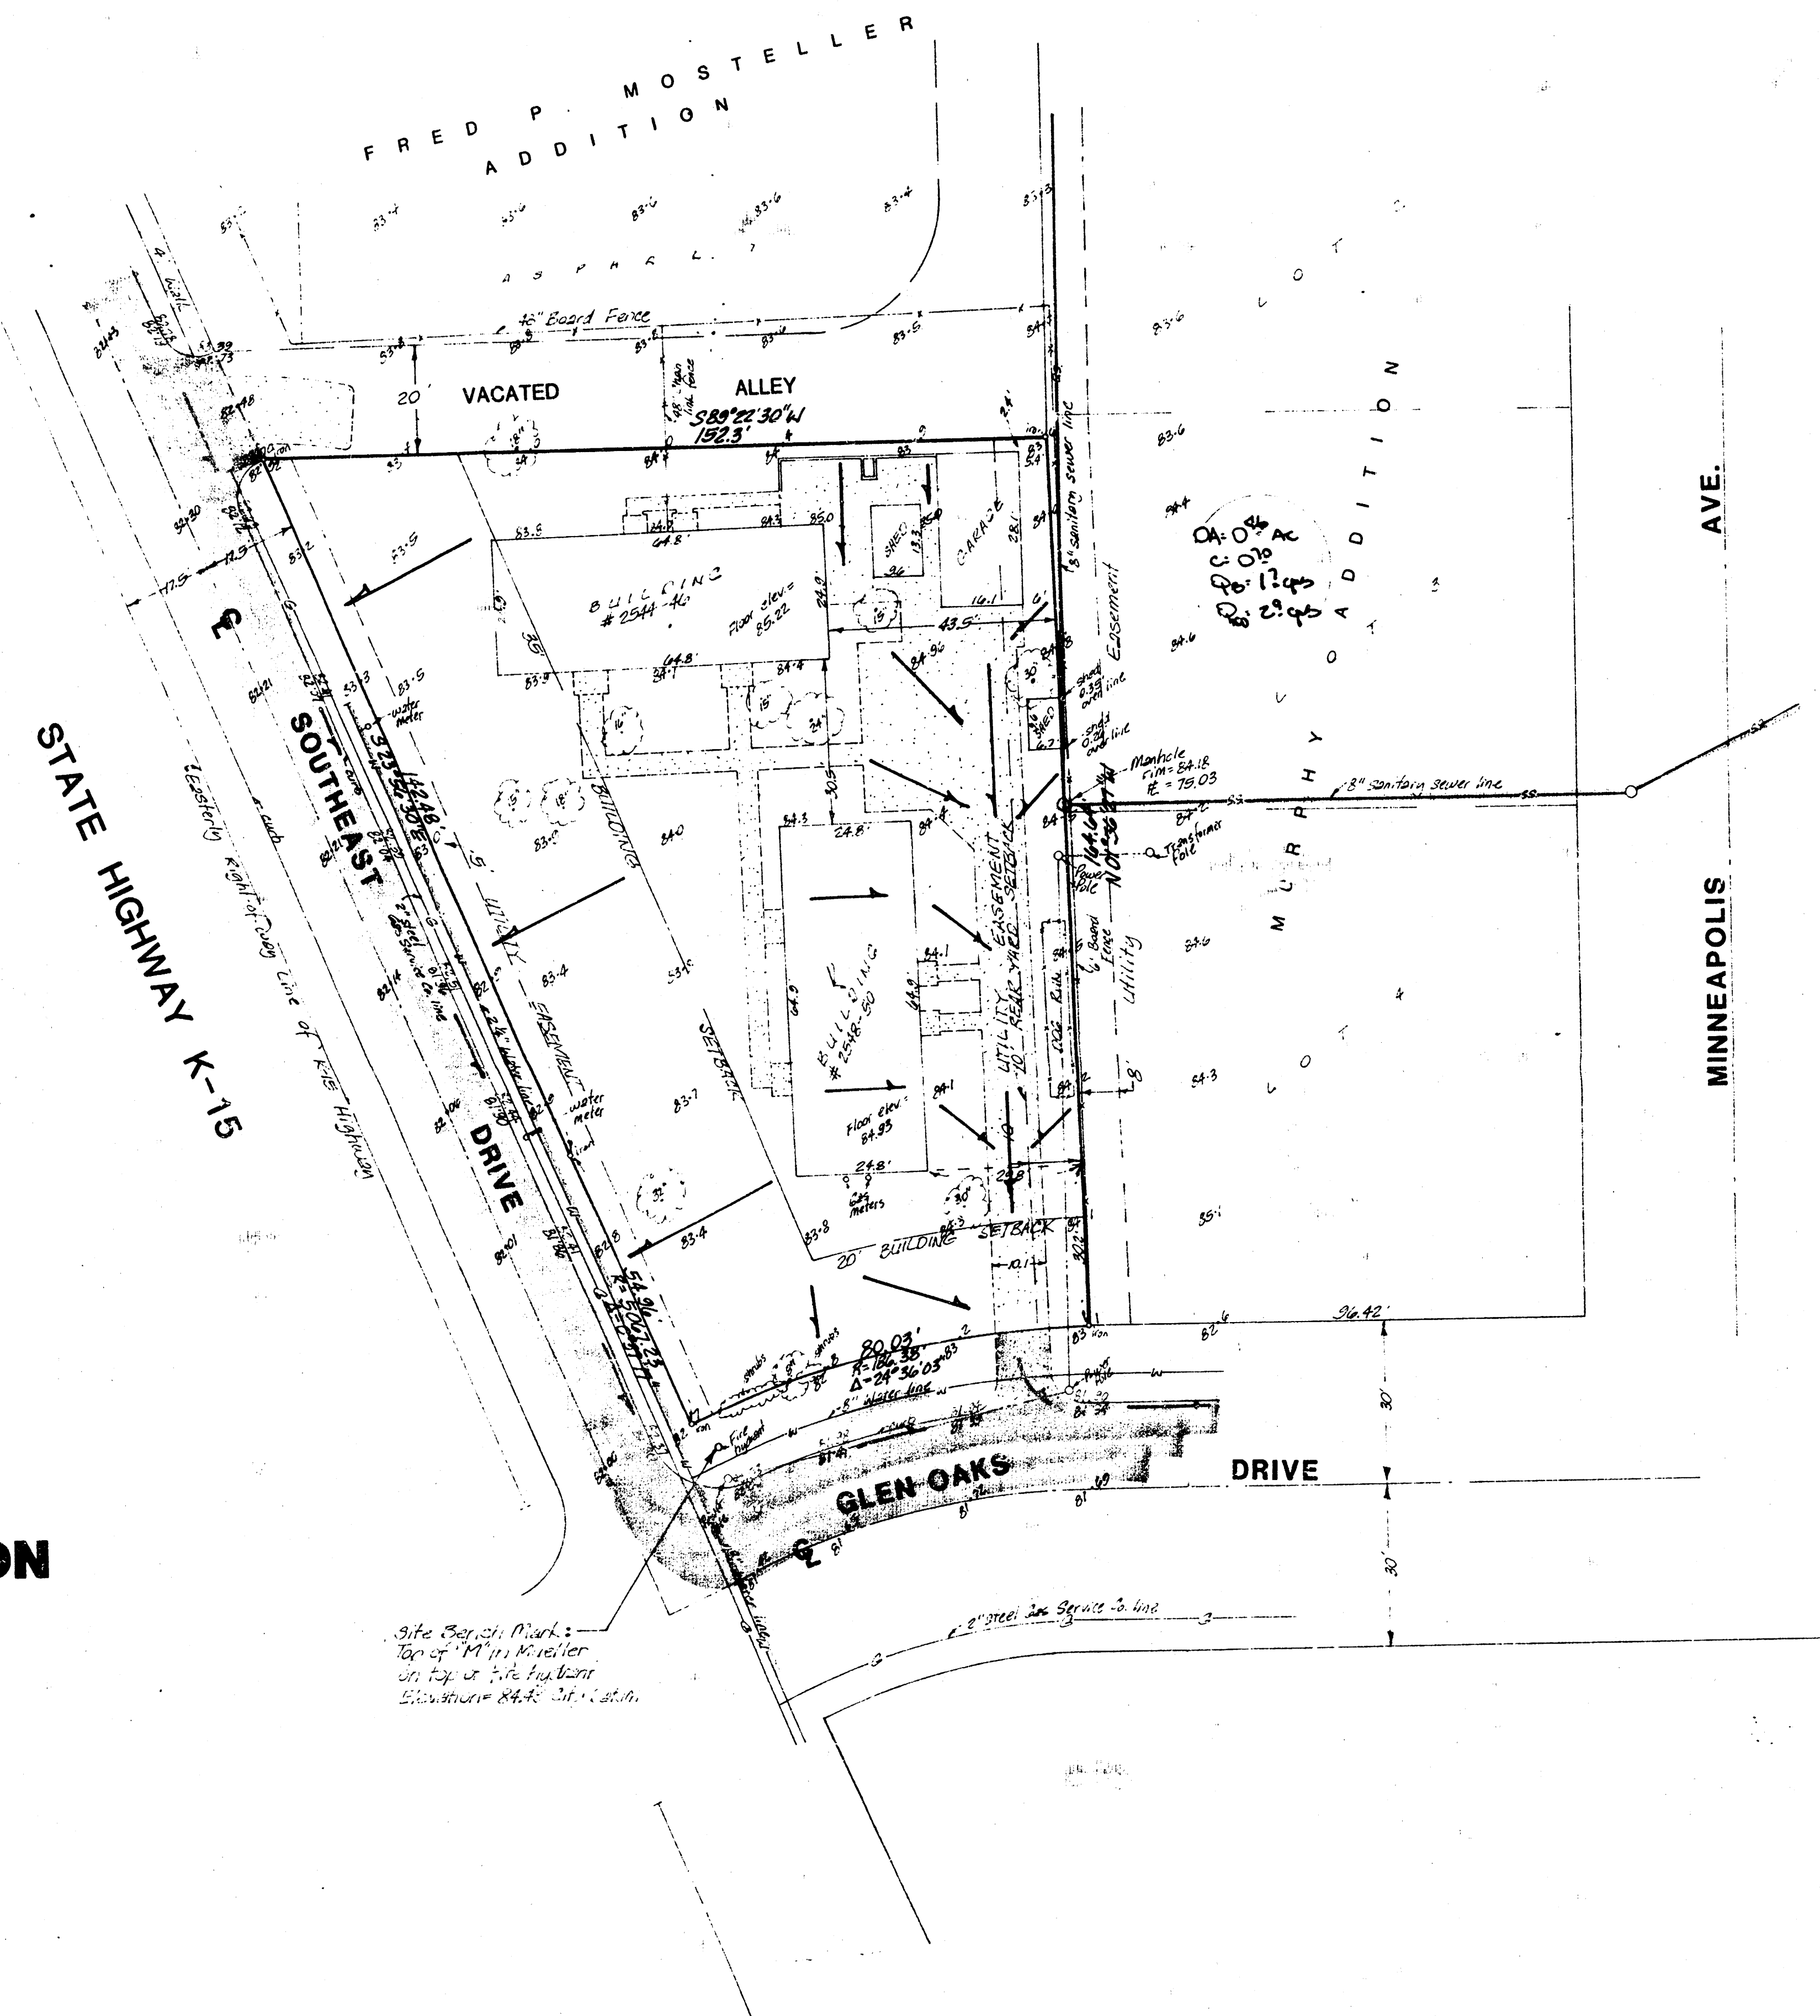


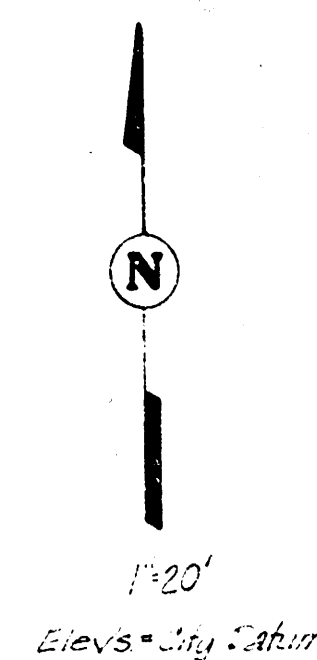

SKETCH PLAT
RAINBO BAKING CO. ADDITION

LOTS 5 AND 6, BLOCK 1, MURPHY ADDITION
TO WICHITA, SEDGWICK COUNTY, KANSAS

OWNER: RAINBO BAKING COMPANY

DRAINAGE PLAN

GENERAL NOTES

The lot will continue to drain as it does presently to the streets. Runoff coefficient for the lot will be 0.70. The streets drain southeast and east on Glen Oaks Drive and eventually into the canal.

ED BAUGHMAN COMPANY, P.A.
SURVEYING & ENGINEERING
316 262-7271 • 330 LAURA • WICHITA, KANSAS 67211