

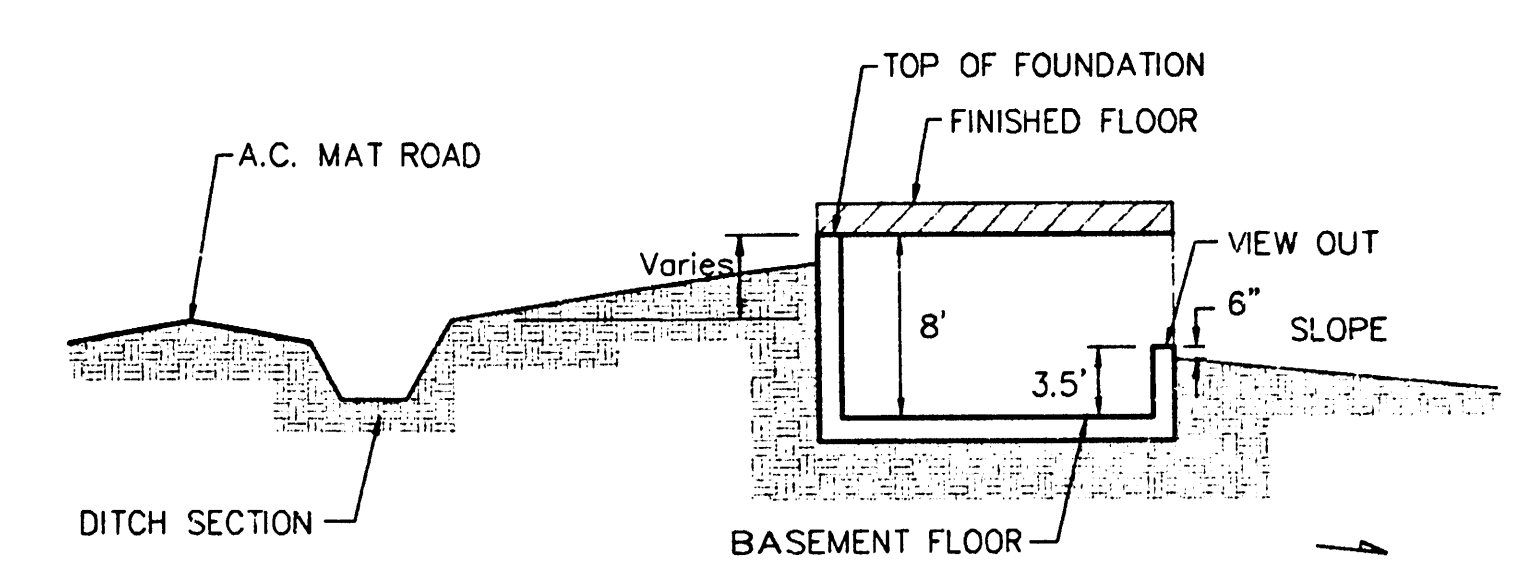


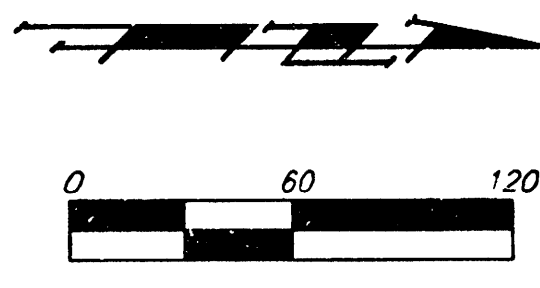

TYPICAL VIEW OUT
NO SCALE

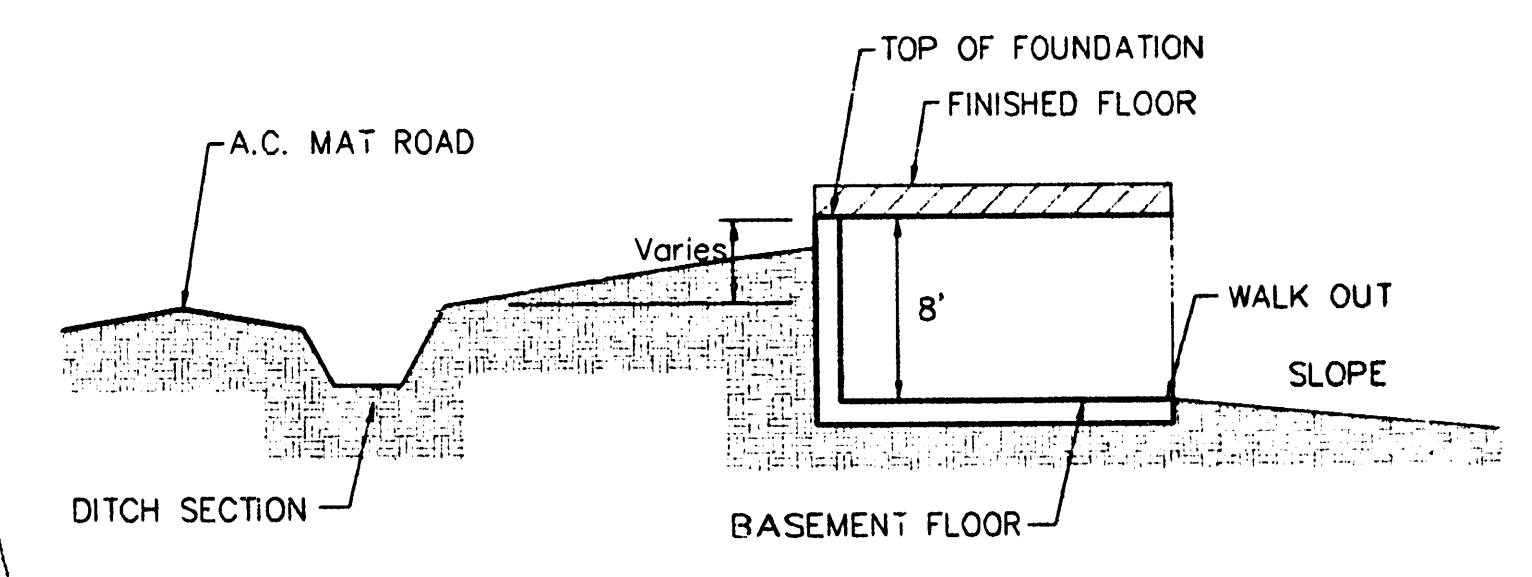


TYPICAL WALK OUT
NO SCALE

BENCHMARK:
TOP OF 1" IRON, 12" DEEP, E1/4 COR.,
SEC. 27, T1P. 27-S, R-2-W
ELEV. = 1285.53 MSL
(208.13 CITY DATUM)

** Lots 37-40, Block A will
require 30" entrance pipe

MINIMUM BUILDING PAD ELEVATION FOR LOWEST OPENING TO THE STRUCTURES				
LOT	BLOCK	ELEVATION		
		QTY DATUM	MSL	
1-22	B	228.6	1416	
19-28	A	223.6	1411	
1,3,4,5	A	222.6	1410	

Revised 3/9/04 by AEG per NDM (Back Yard Grades, Lots 31-36, Bk A)
Revised 2/17/03 by BDT per BAP (Lot 28, Bk A)
Revised 8/16/02 by AES per NDM
Revised 7/8/02 by AEG per NDM

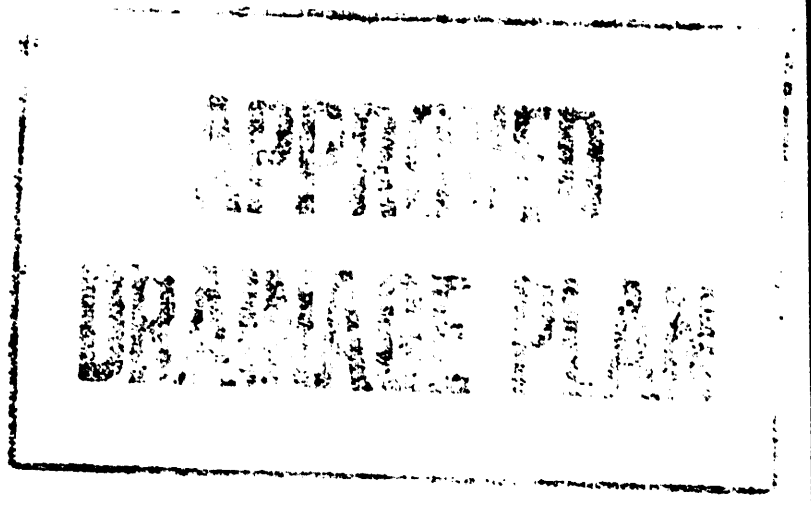

REECE FARMS ESTATES
GRADING PLAN
WICHITA, KANSAS




BAUGHMAN COMPANY P.A.
ENGINEERING, SURVEYING, & PLANNING
316-262-1211 315 ELLIS WICHITA, KANSAS 67211

PROJECT NUMBER: _____

DESIGN: NEW DRAWN: AHH/JAB APPROVED: NEW DATE: 6/15/98 SCALE: 1"=60'

SHEET 1 OF 3

97-03-2831
REECE/01

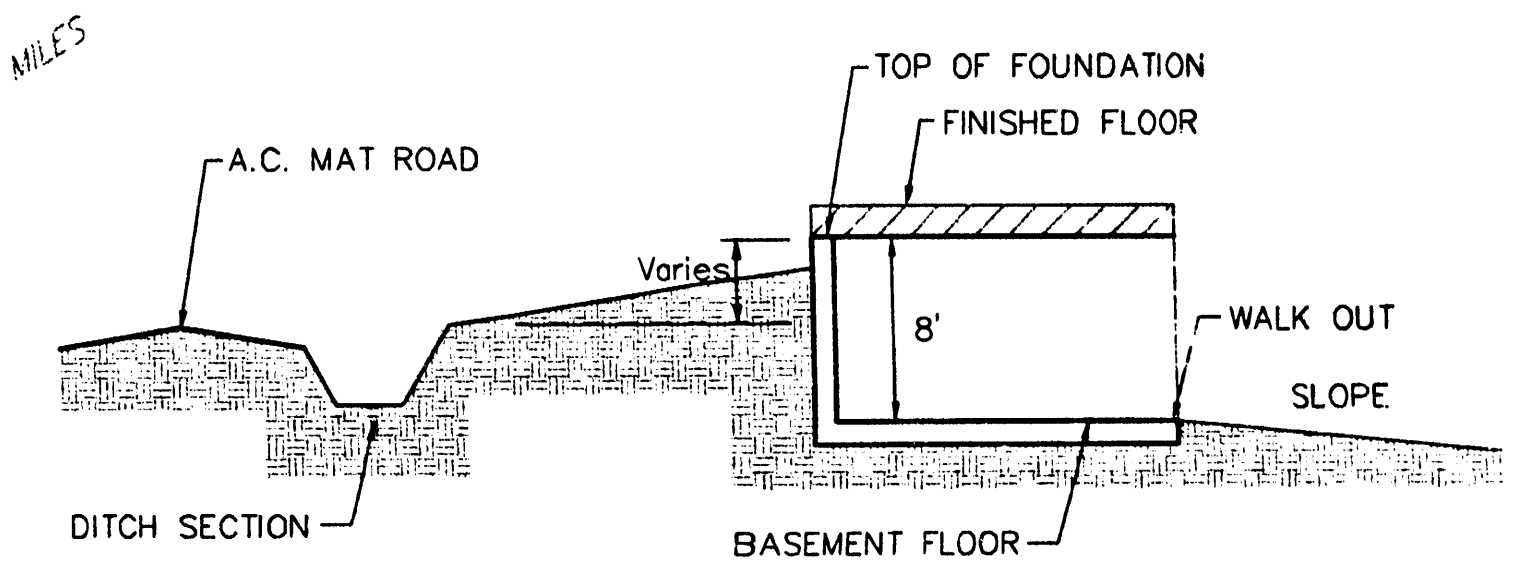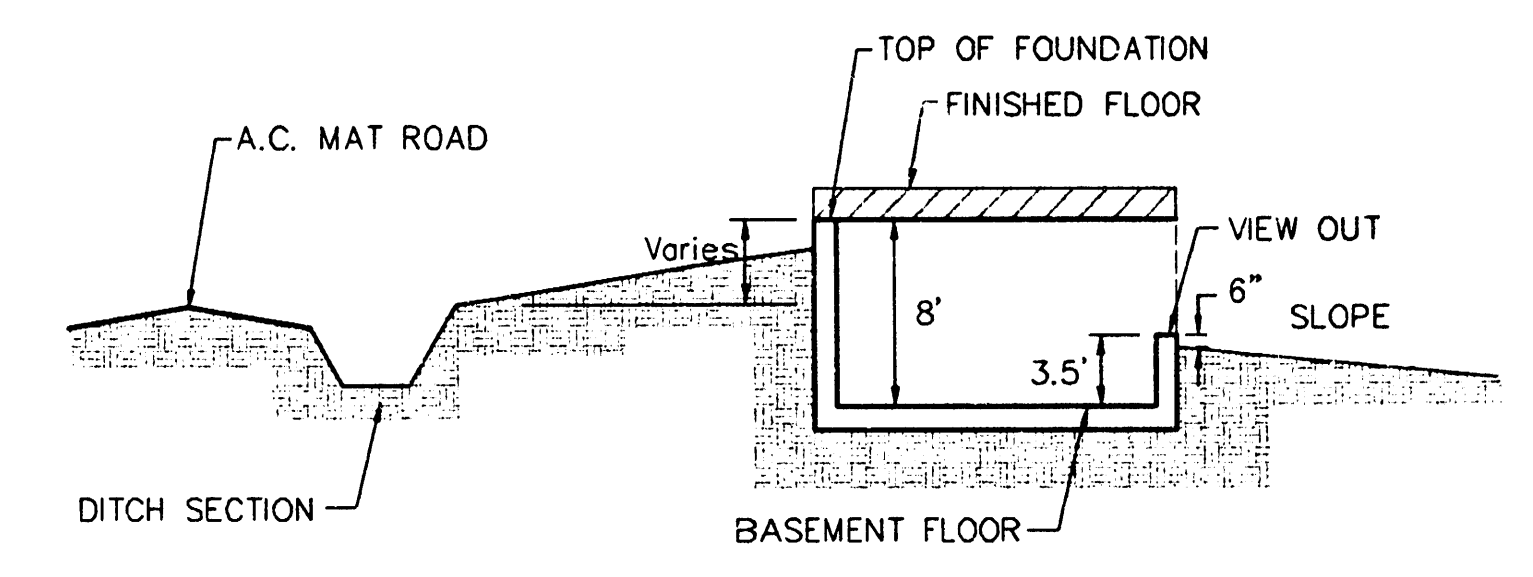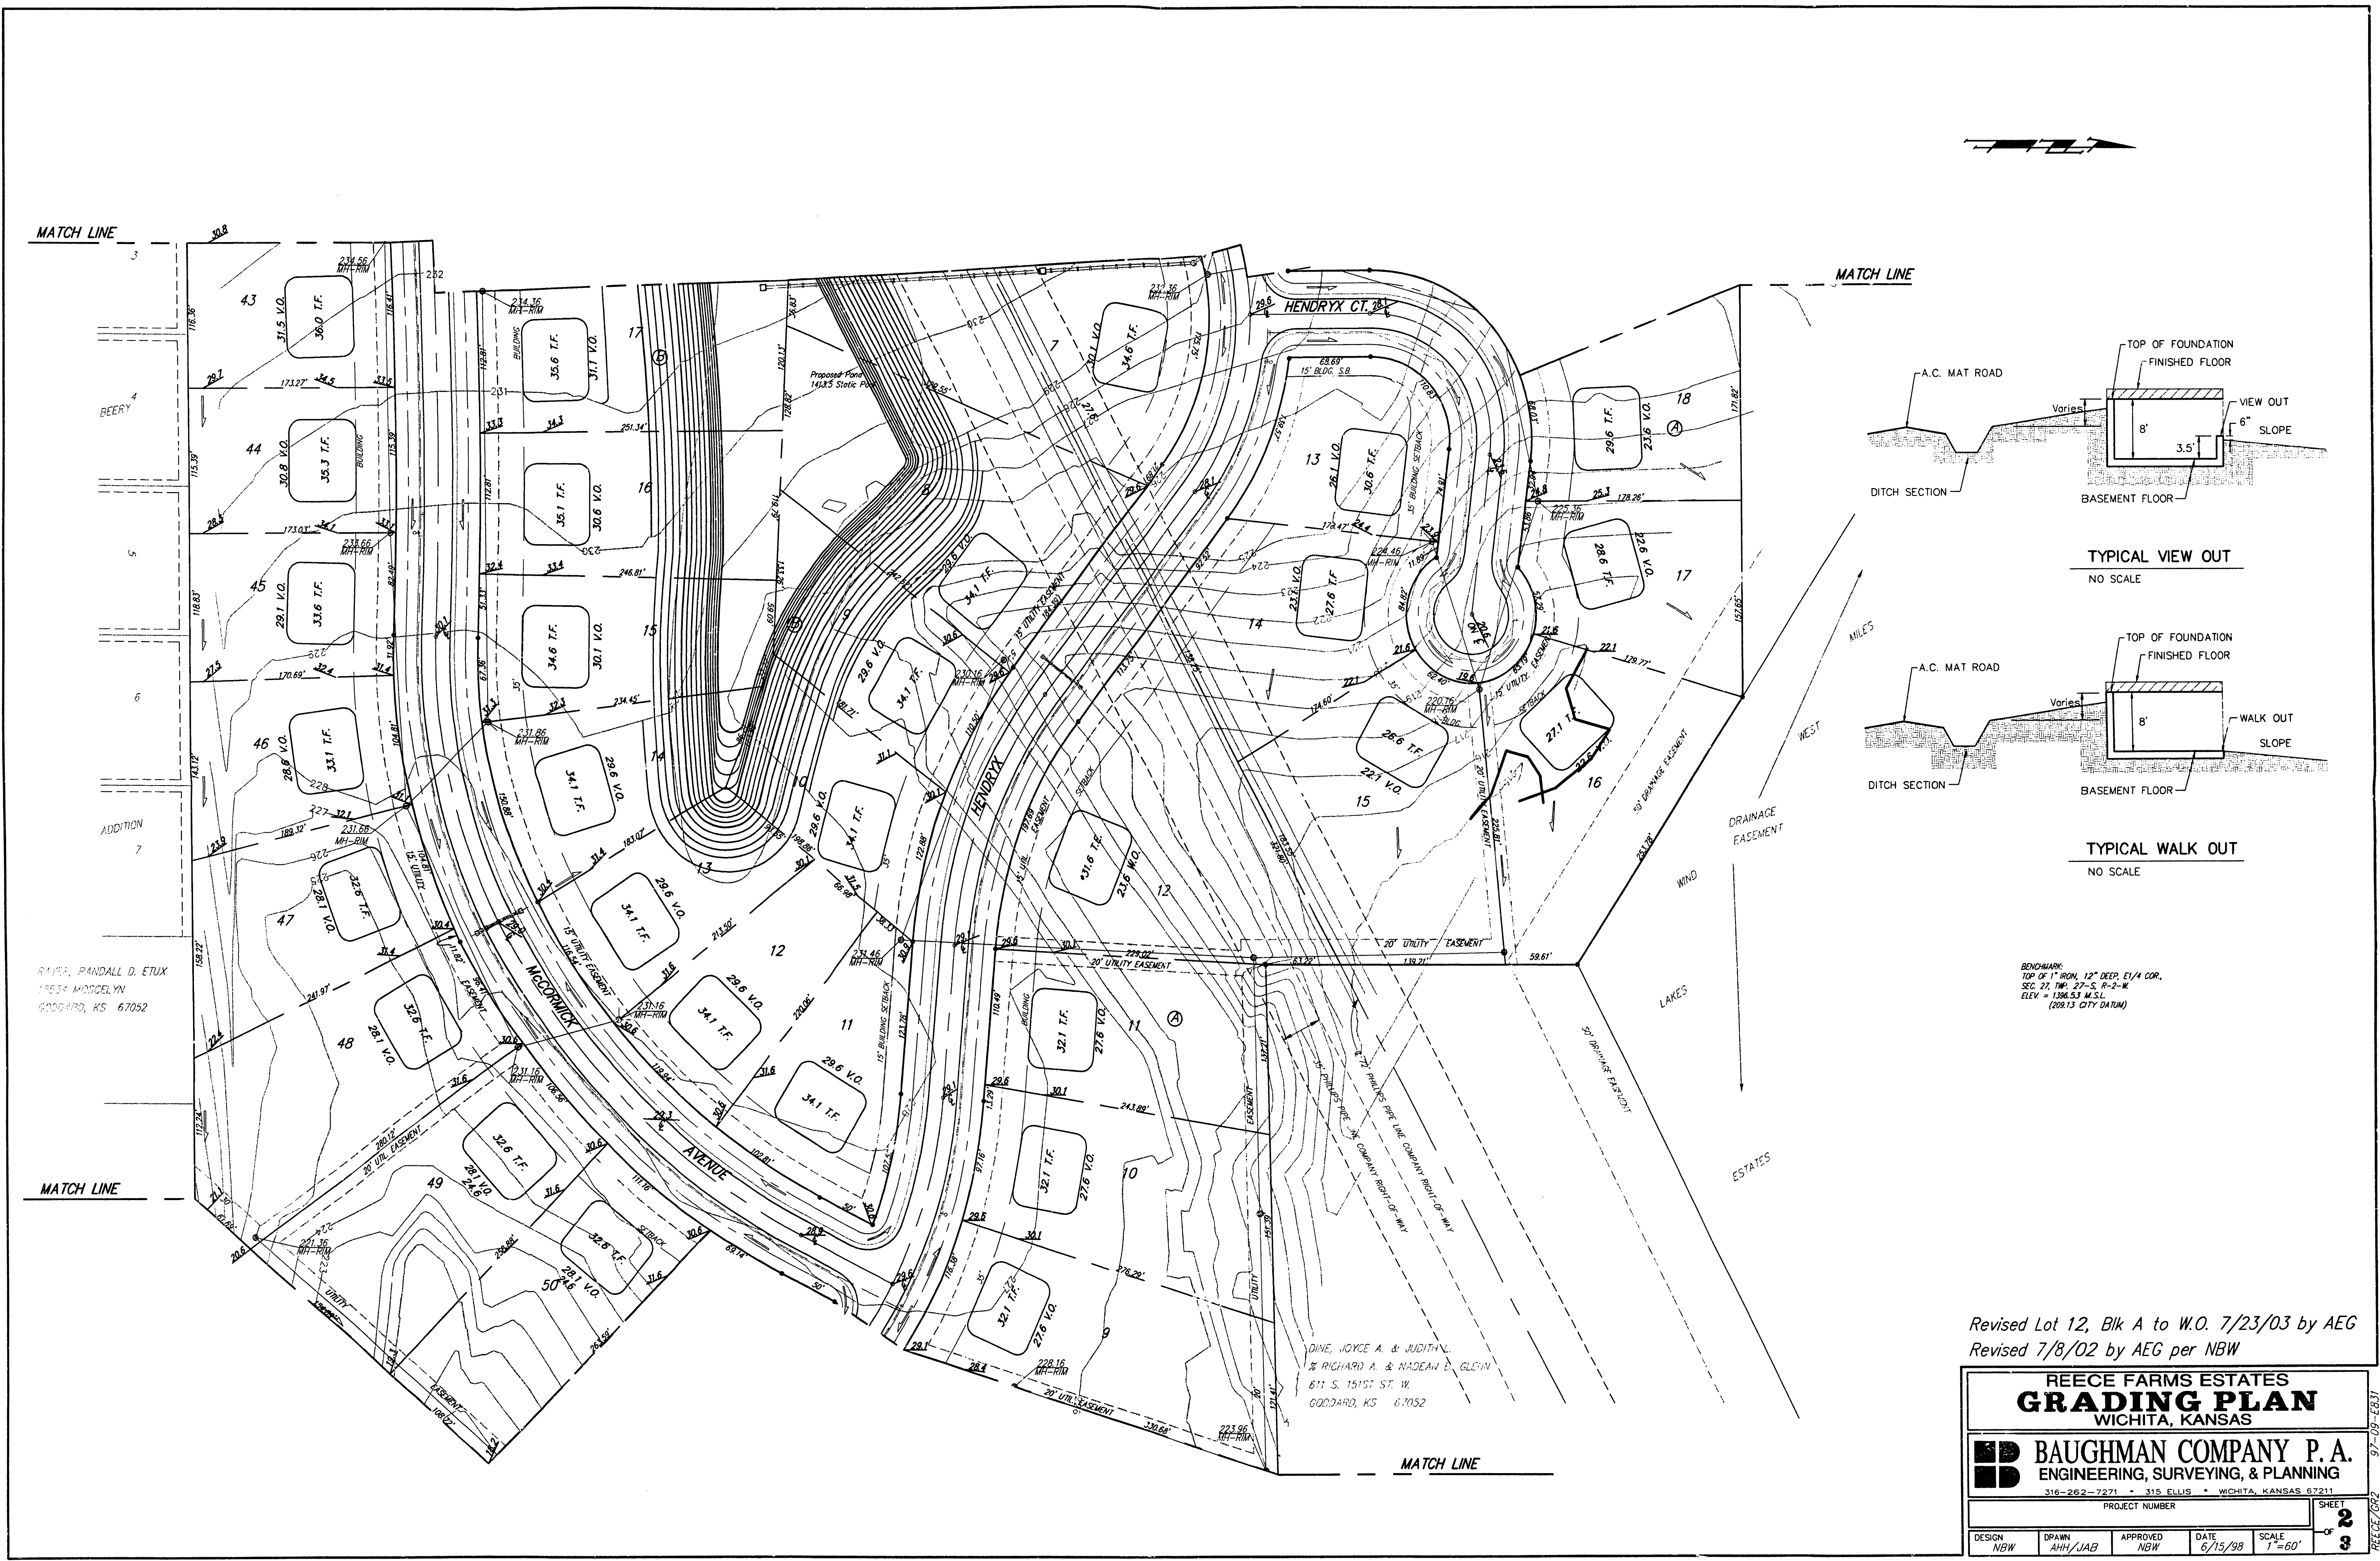


BENCHMARK:
TOP OF 1" IRON, 12" DEEP, E1/4 COR.,
SEC. 27, T1N, 27S, R-2-W
ELEV. = 1386.53 M.S.L.
(200.13 CITY DATUM)

Revised Lot 12, Blk A to W.O. 7/23/03 by AEG
Revised 7/8/02 by AEG per NBW

REECE FARMS ESTATES GRADING PLAN WICHITA, KANSAS				
BAUGHMAN COMPANY P. A. ENGINEERING, SURVEYING, & PLANNING 316-262-7271 • 315 ELLIS • WICHITA, KANSAS 67211				
PROJECT NUMBER				SHEET 2 OF 3
DESIGN	DRAWN	APPROVED	DATE	
NBW	AHH/JAB	NBW	6/15/98	SCALE 1"=60'

MATCH LINE

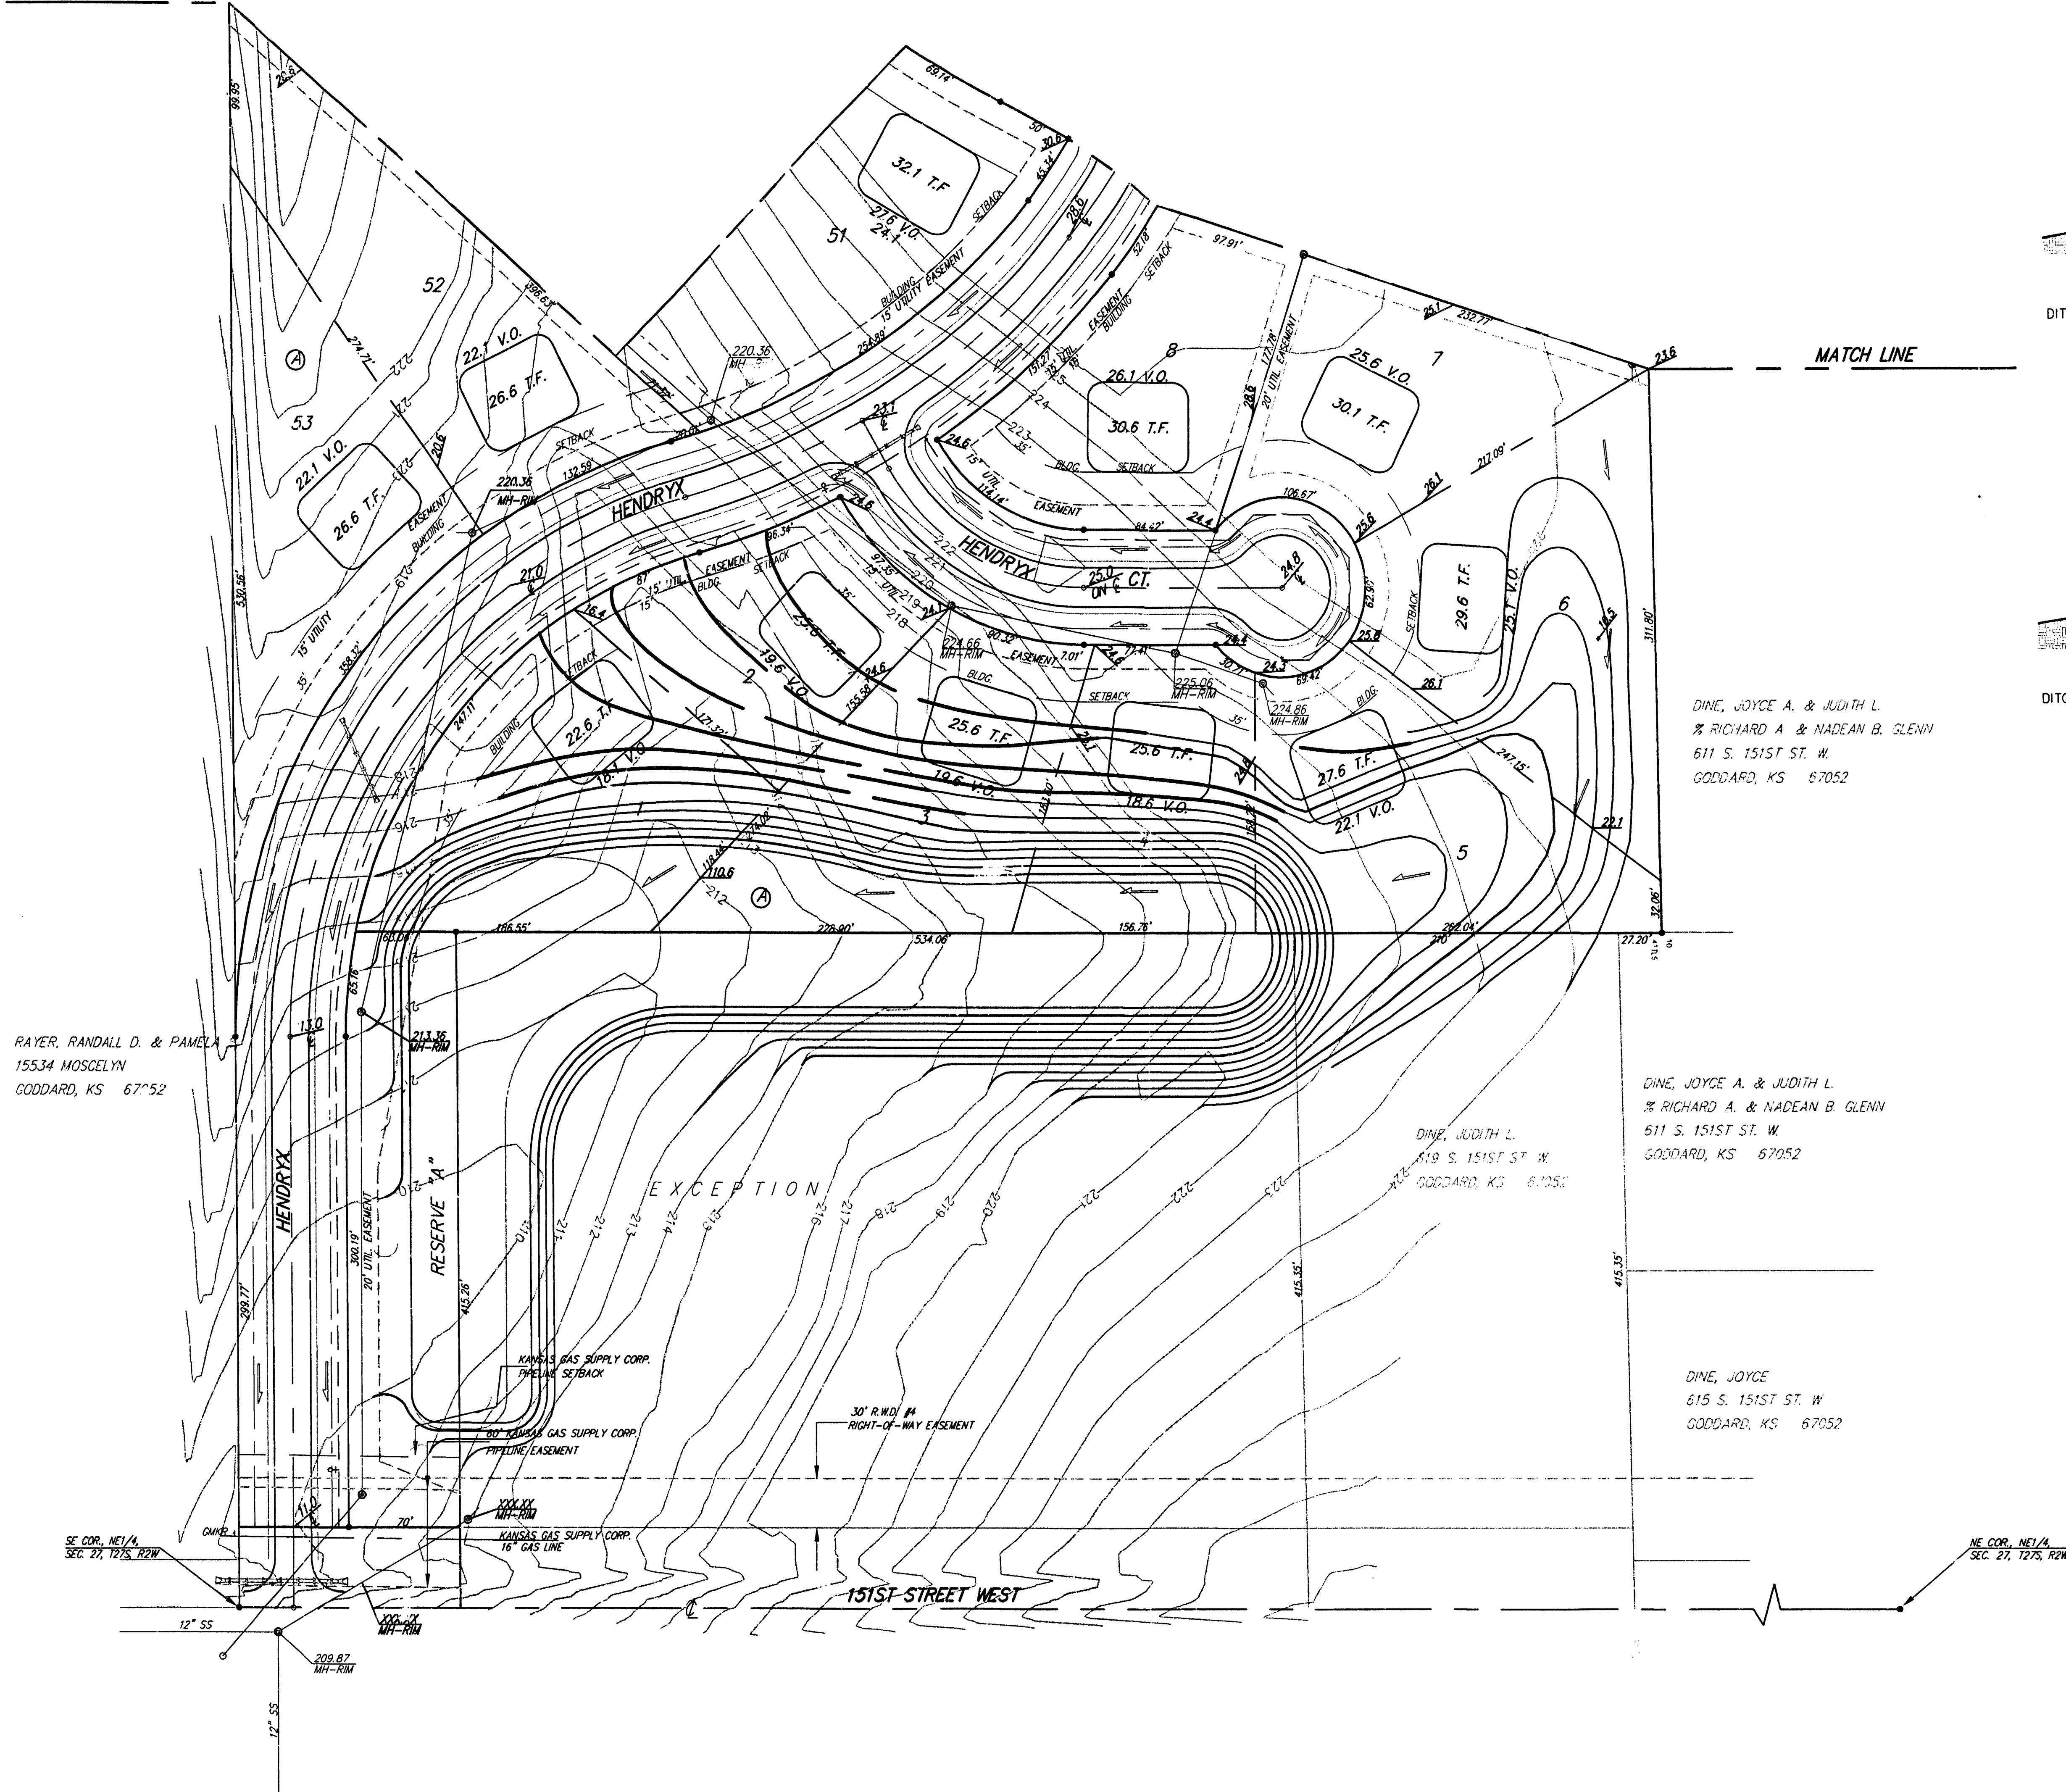


RAYE, RANDALL D. & PAMELA
15534 MOSCERYN
GODDARD, KS 67052


DINE, JOYCE A. & JUDITH L.
RICHARD A. & NADAN B. GLENN
611 S. 151ST ST. W.
GODDARD, KS 67052

DINE, JOYCE A. & JUDITH L.
RICHARD A. & NADAN B. GLENN
611 S. 151ST ST. W.
GODDARD, KS 67052

DINE, JOYCE
615 S. 151ST ST. W.
GODDARD, KS 67052

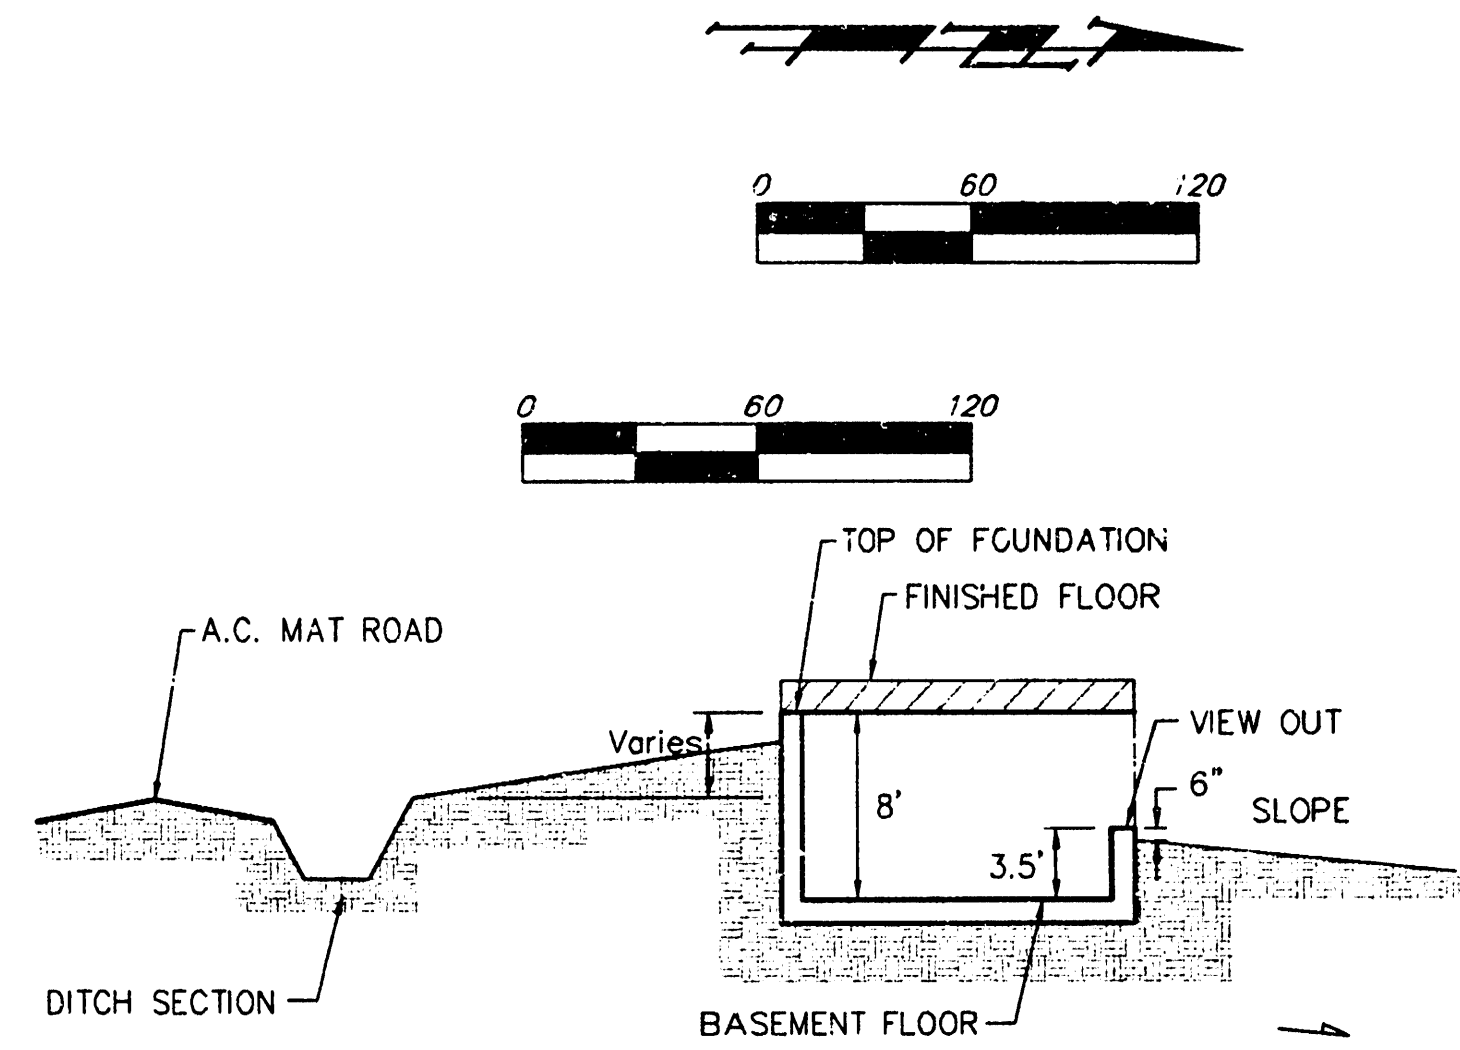

TYPICAL VIEW OUT
NO SCALE

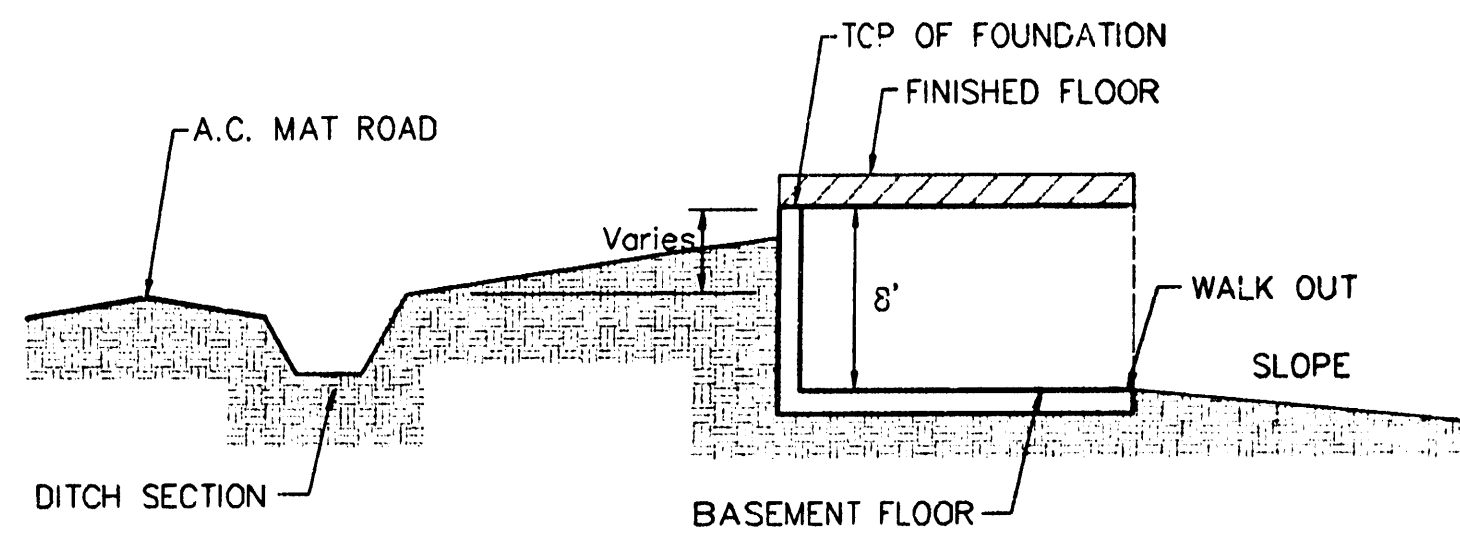

TYPICAL WALK OUT
NO SCALE

BENCHMARK:
TOP OF 1" IRON, 12" DEEP 1/4 COR.
SEC. 27, TWP. 27-S, R-2-W
ELEV. = 1206.51 M.S.L.
(2001.5 CITY DATUM)

MINIMUM BUILDING PAD ELEVATION FOR LOWEST OPENING TO THE STRUCTURES			
LOT	BLOCK	ELEVATION	
		CITY DATUM	MSL
1-22	B	228.6	1416
19-28	A	223.6	1411
1,3,4,5	A	222.6	1410

REECE FARMS ESTATES
GRADING PLAN
WICHITA, KANSAS

BAUGHMAN COMPANY P. A.
ENGINEERING, SURVEYING, & PLANNING
316-262-7271 • 315 ELLIS • WICHITA, KANSAS 67211

DESIGN NGW	DRAWN AHJ/JAB	APPROVED NGW	DATE 6/15/98	SCALE 1"=60'	PROJECT NUMBER 316-262-7271 • 315 ELLIS • WICHITA, KANSAS 67211	SHEET 3 OF 3
---------------	------------------	-----------------	-----------------	-----------------	--	-----------------------

97-09-E831
REECE (08)