



# REFLECTION RIDGE 8TH ADDITION TO WICHITA SEDGWICK, COUNTY, KANSAS


N.W. CORNER N.E. 1/4  
SEC. 4, T27S, R1W  
POINT OF BEGINNING

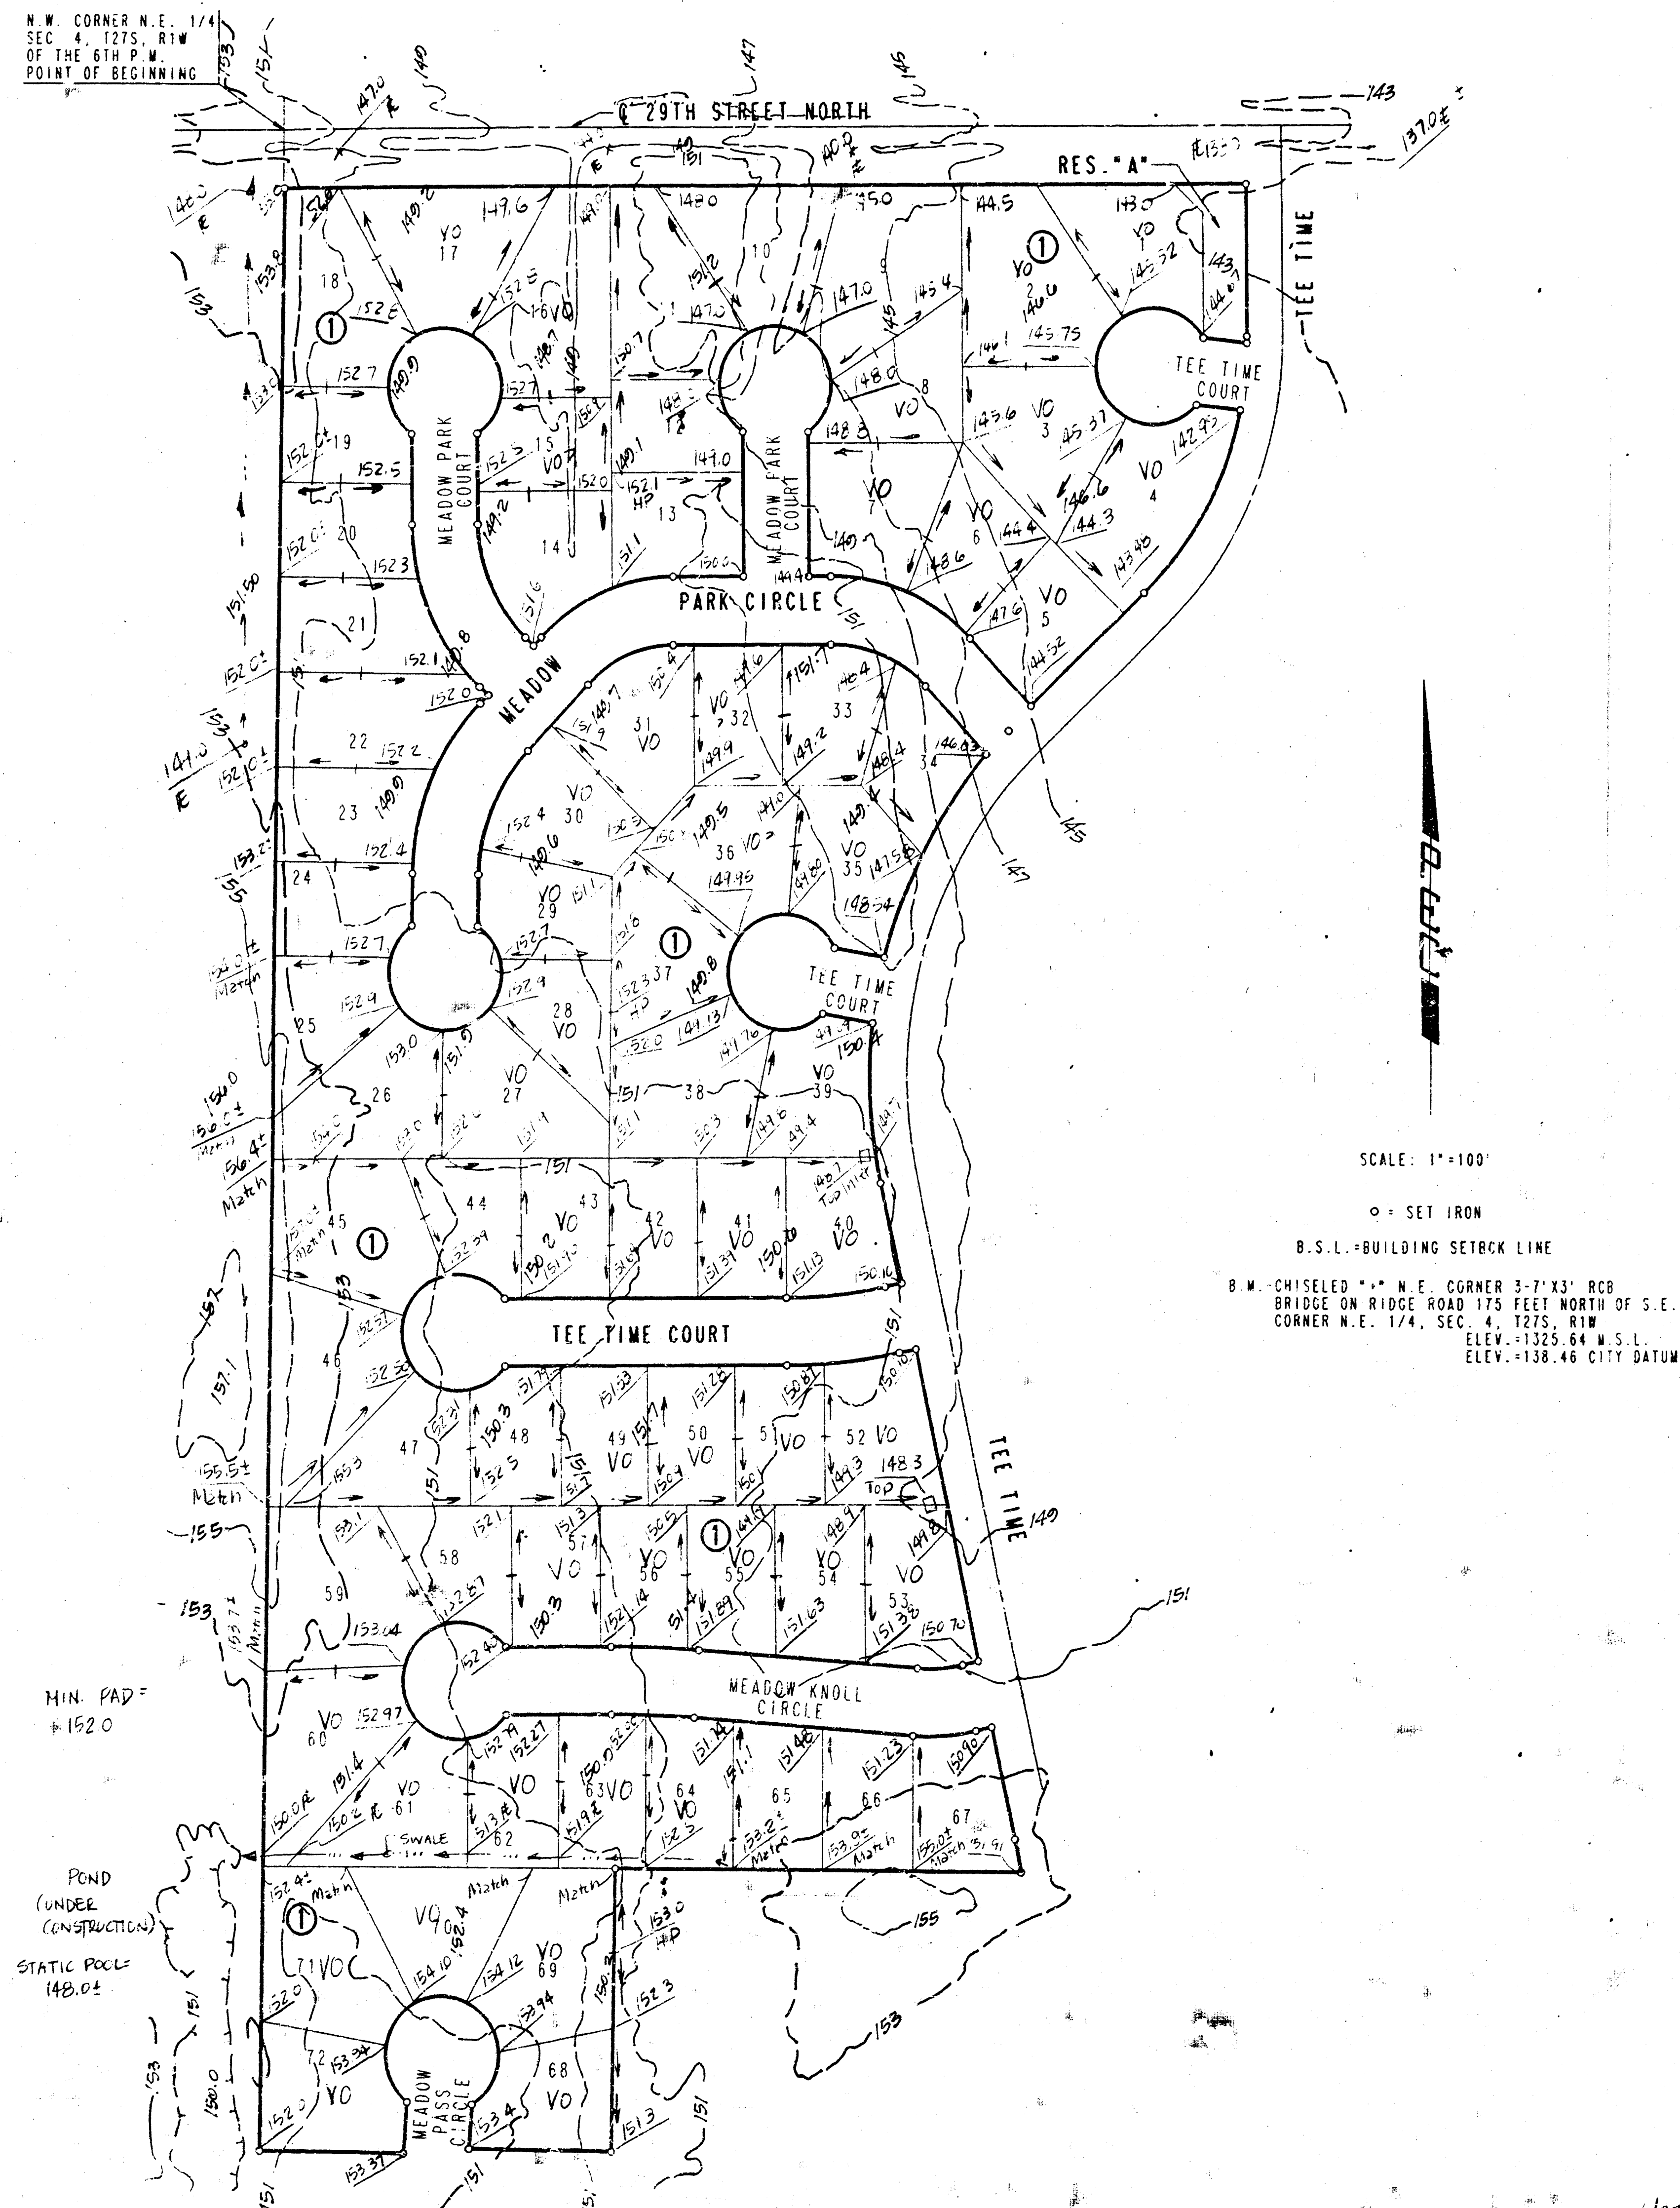

APPROVED  
DRAINAGE PLAN



170 "J"  
DETAILED DRAINAGE PLAN

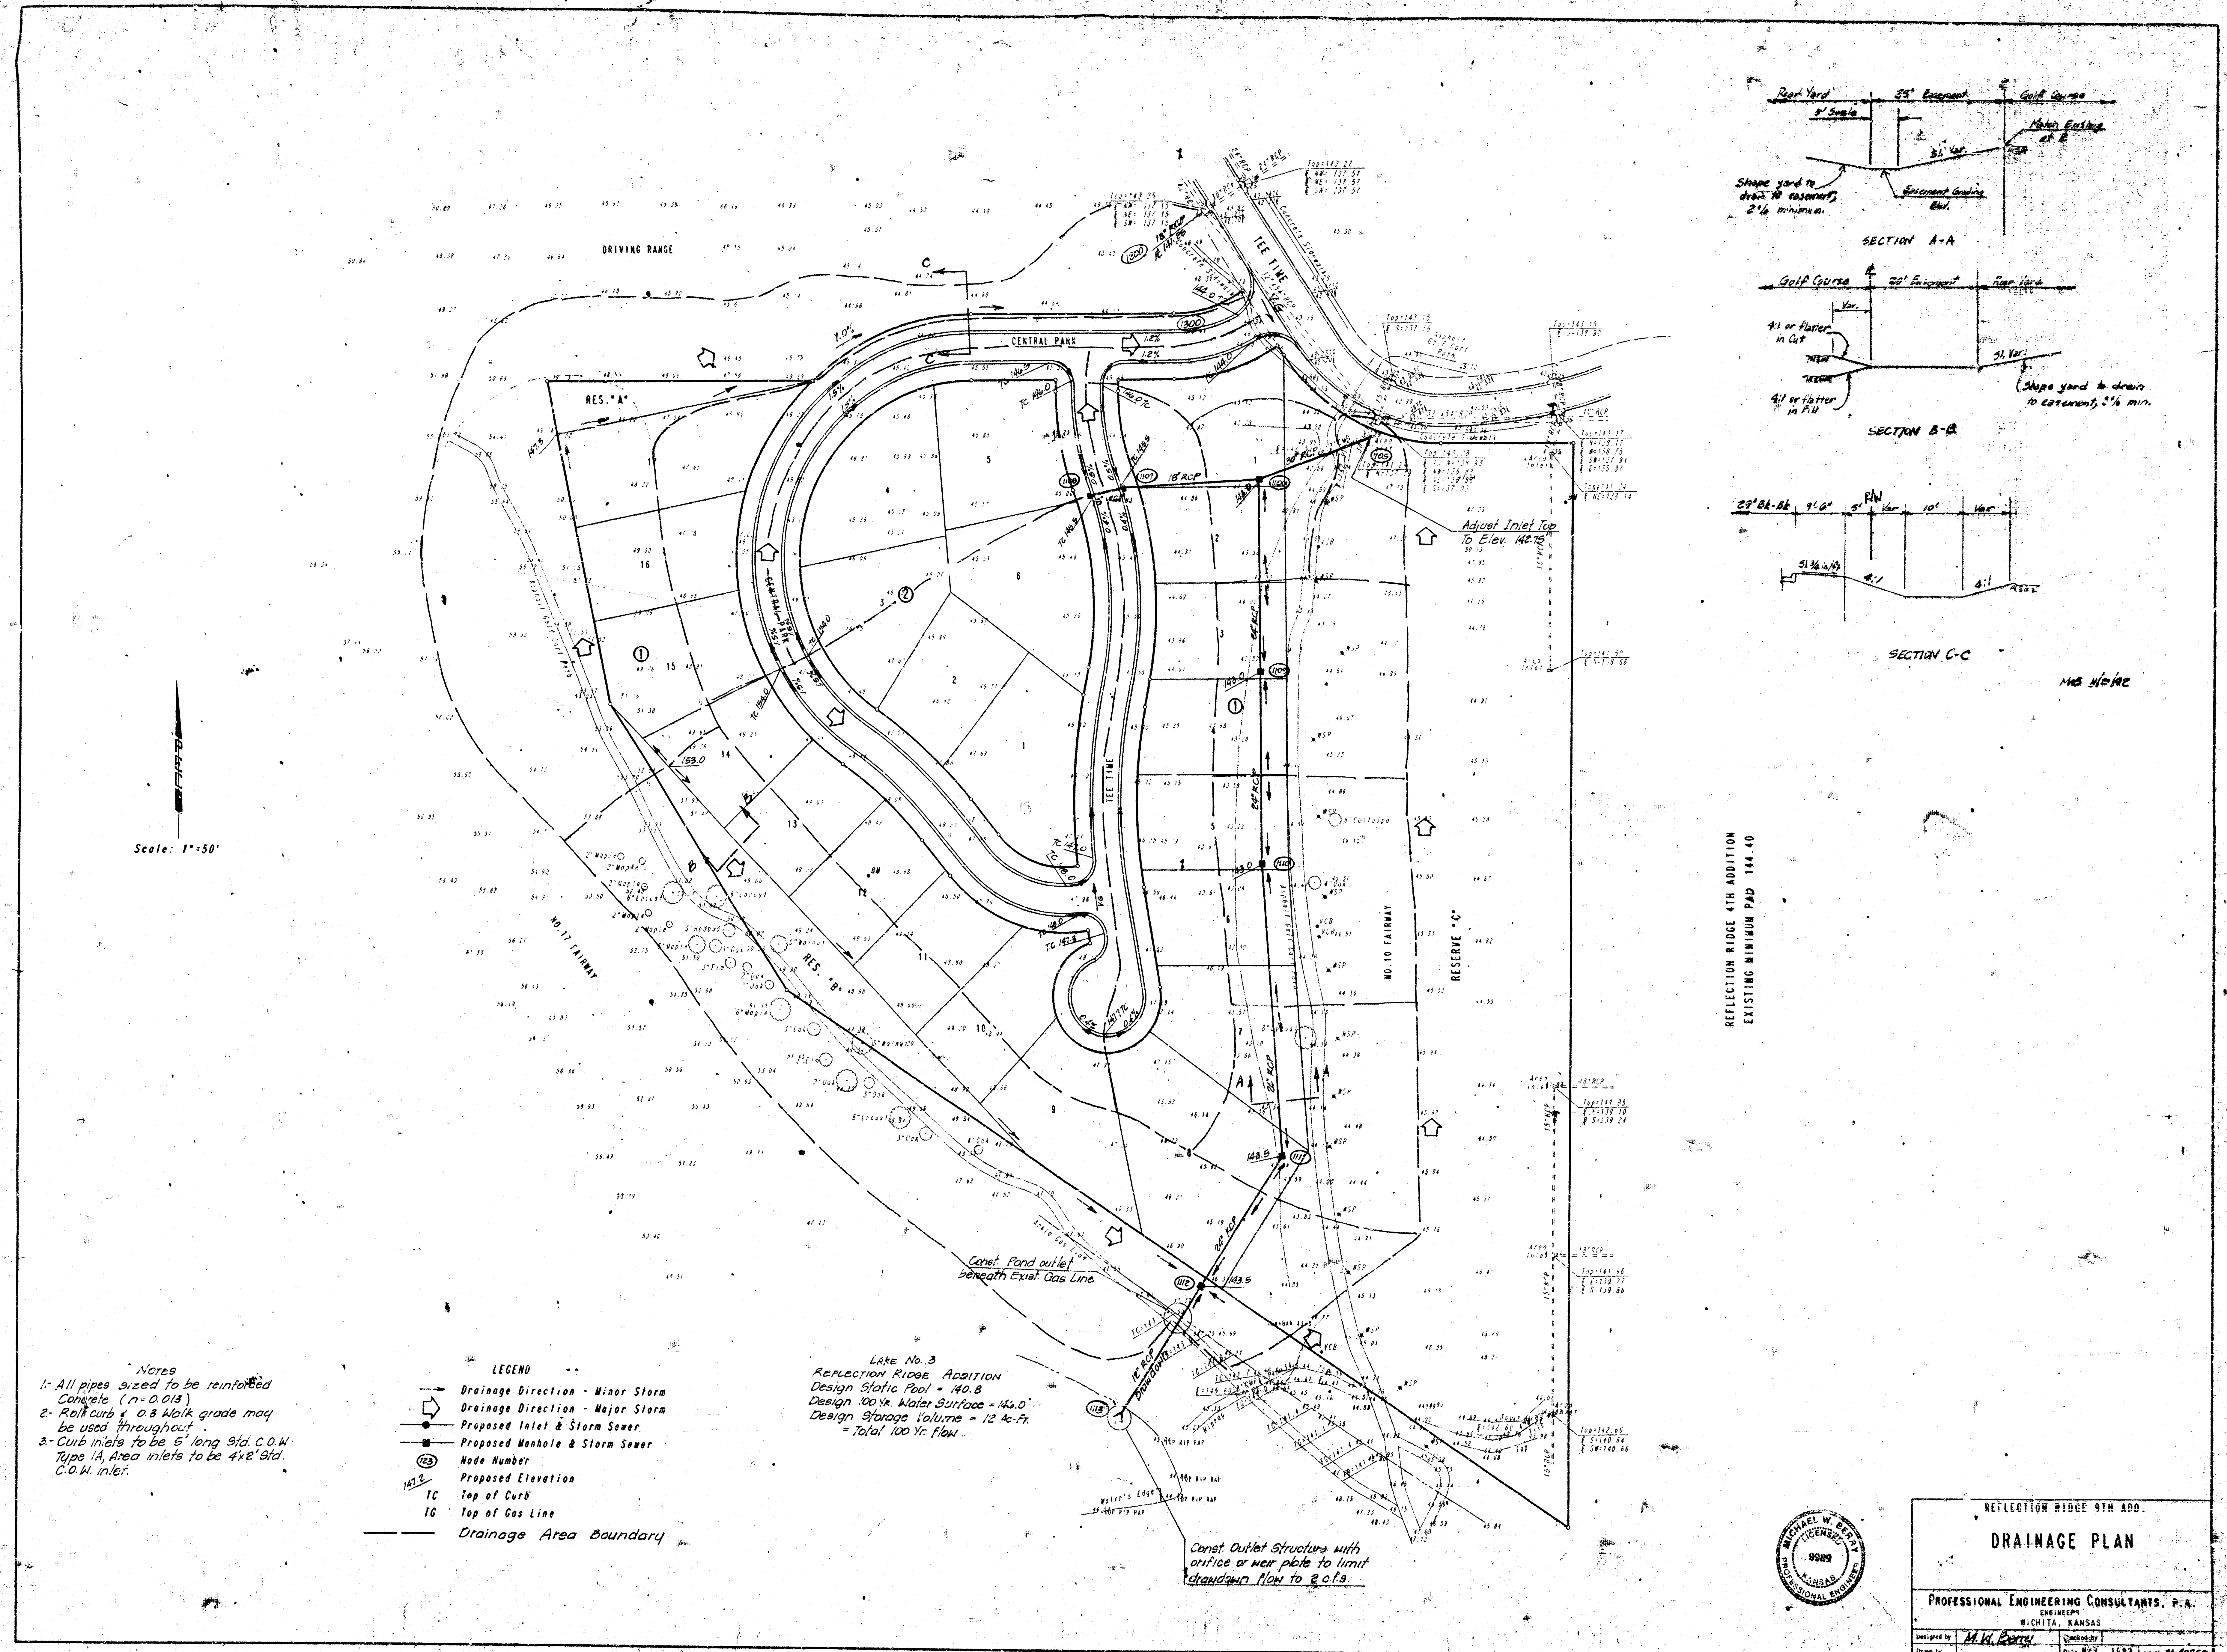

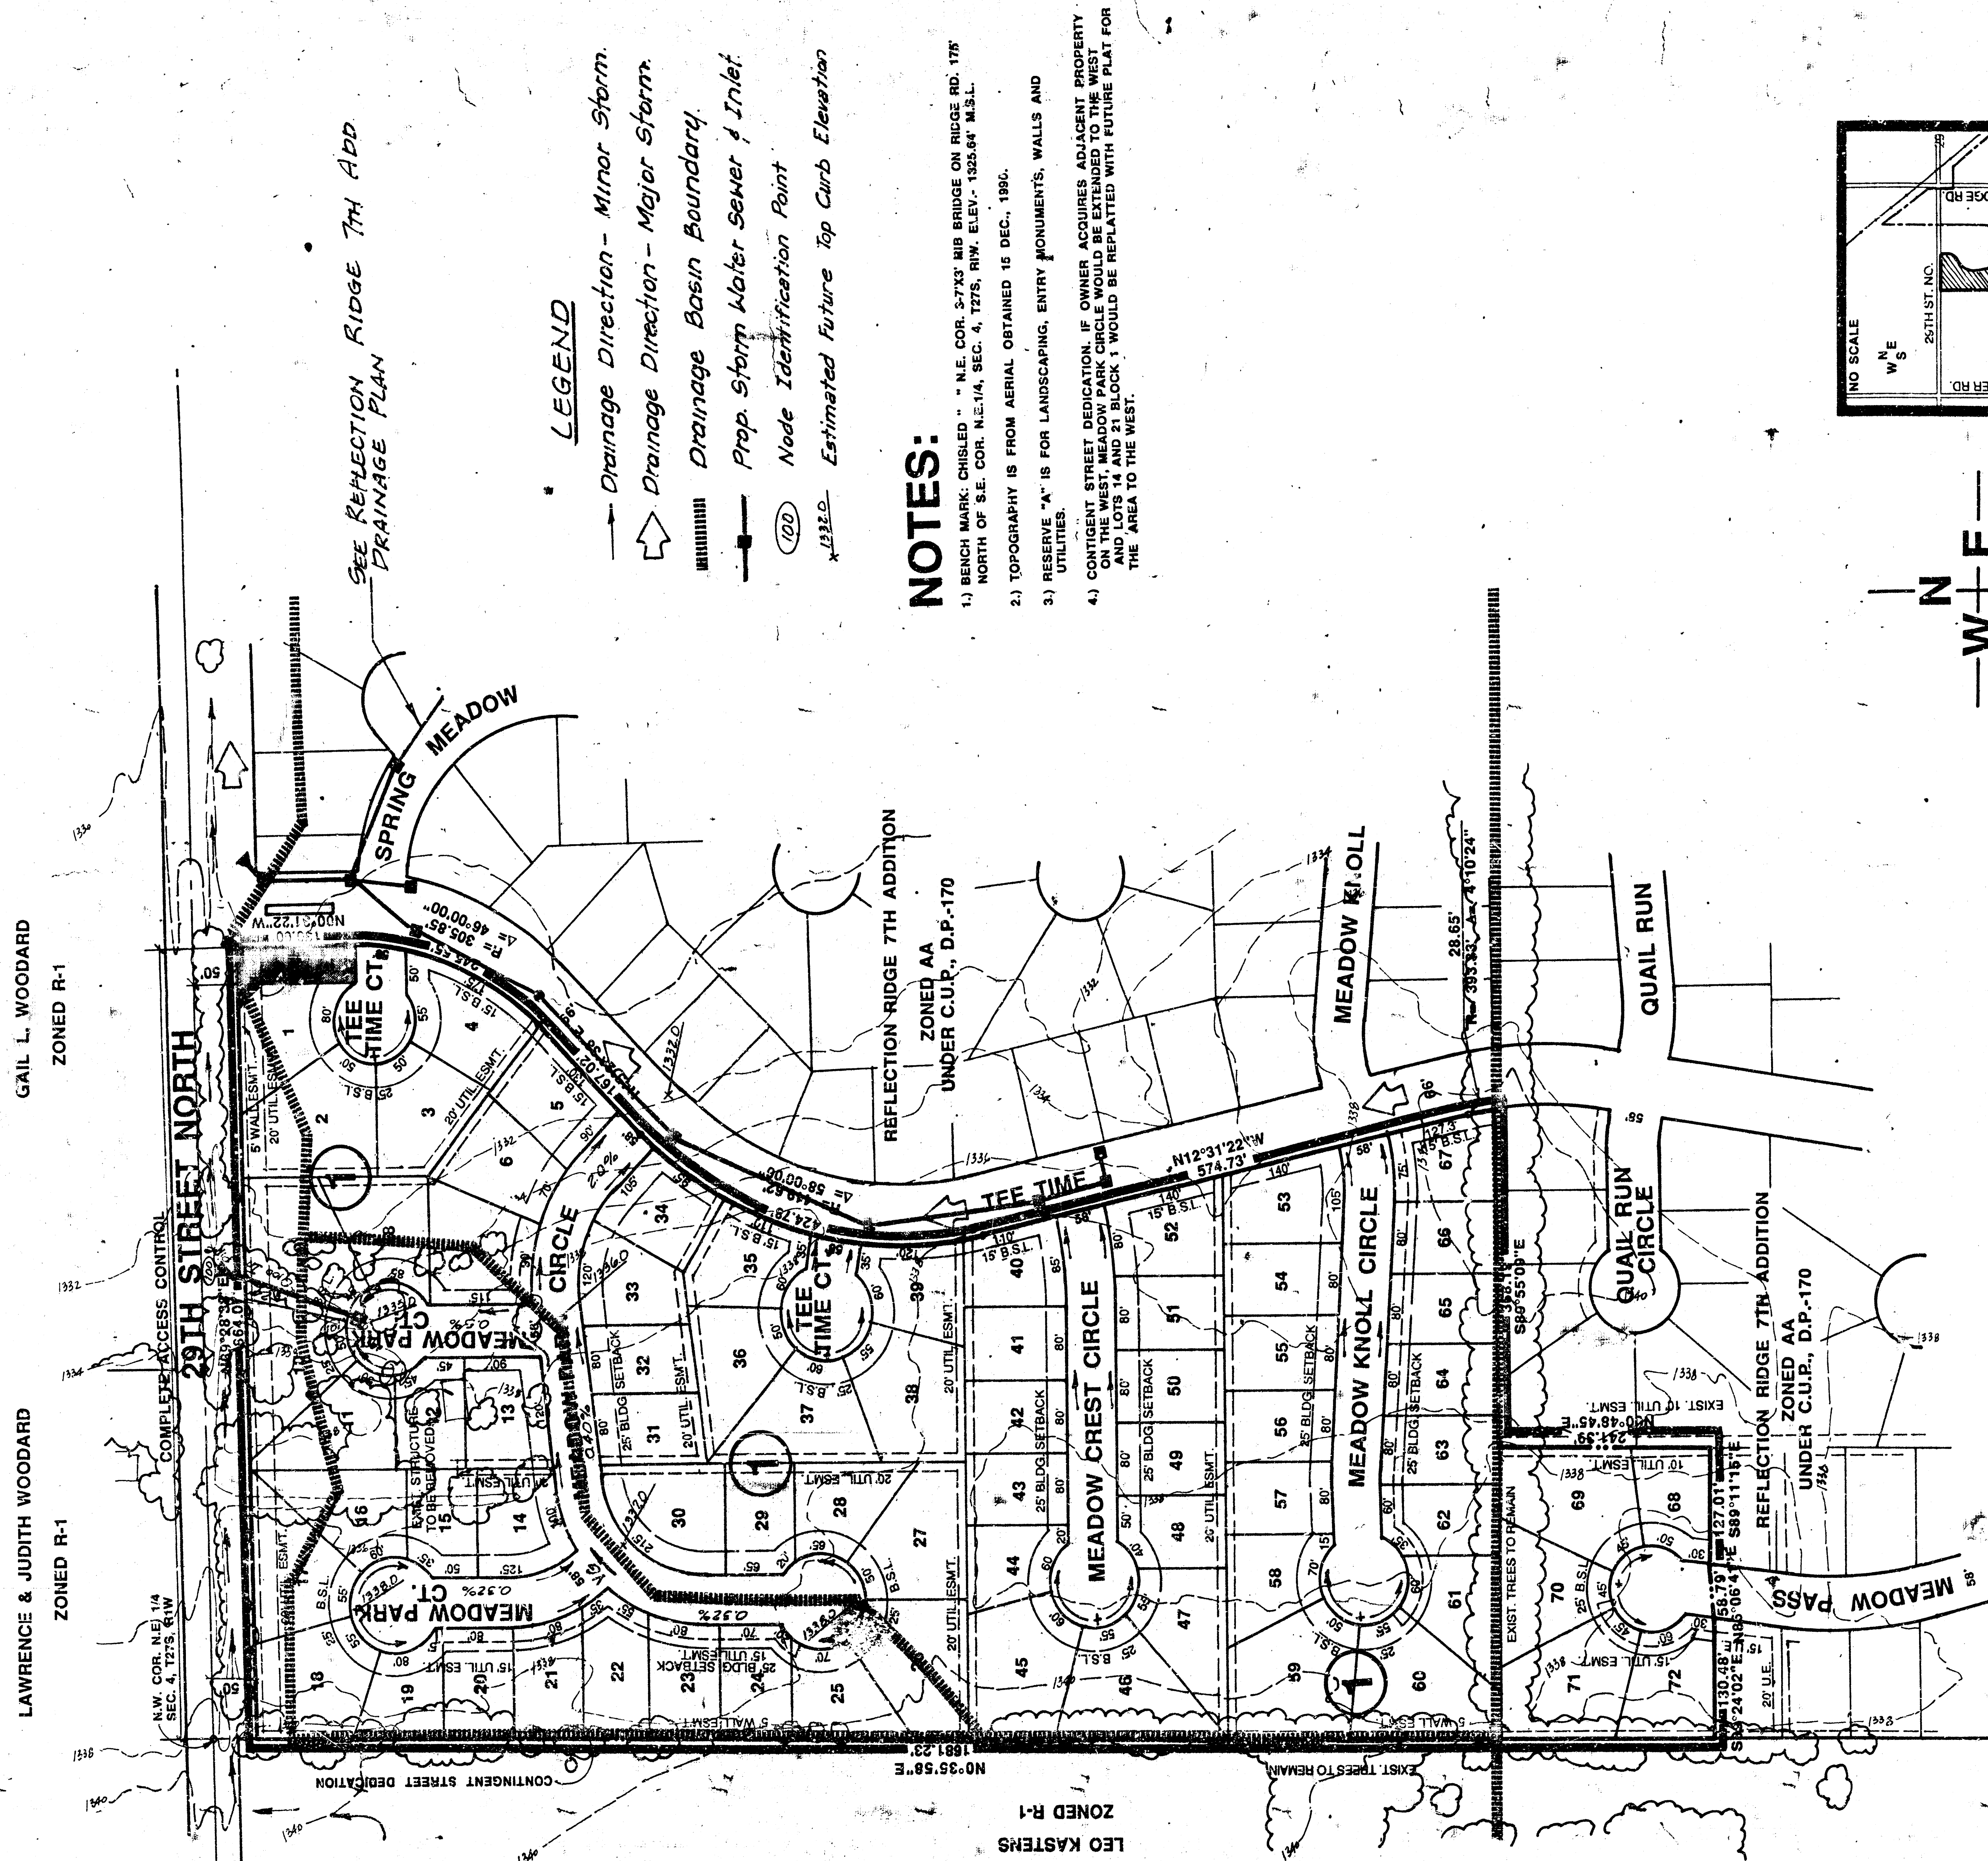


- LEGEND**
- Drainage Direction - Minor Storm.
  - Drainage Direction - Major Storm.
  - Drainage Basin Boundary.
  - Prop. Storm Water Sewer & Inlet.
  - Node Identification Point.
  - Estimated Future Top Curb Elevation.

- NOTES:**
- 1.) BENCH MARK: CHISELED " " N.E. COR. 3.7X3' MIB BRIDGE ON RIDGE RD. 175' NORTH OF S.E. COR. N.E.1/4, SEC. 4, T27S, R1W, ELEV. 1325.47' M.S.L.
  - 2.) TOPOGRAPHY IS FROM AERIAL, OBTAINED 16 DEC., 1990.
  - 3.) RESERVE "A" IS FOR LANDSCAPING, ENTRY MONUMENTS, WALLS AND UTILITIES.
  - 4.) CONTIGENT STREET DEDICATION: IF OWNER ACQUIRES ADJACENT PROPERTY ON THE EAST, MEADOW CREST CIRCLE WOULD BE EXTENDED TO THE WEST AND LOTS 14 AND 21 BLOCK 1 WOULD BE REPLACED WITH FUTURE PLAT FOR THE AREA TO THE WEST.

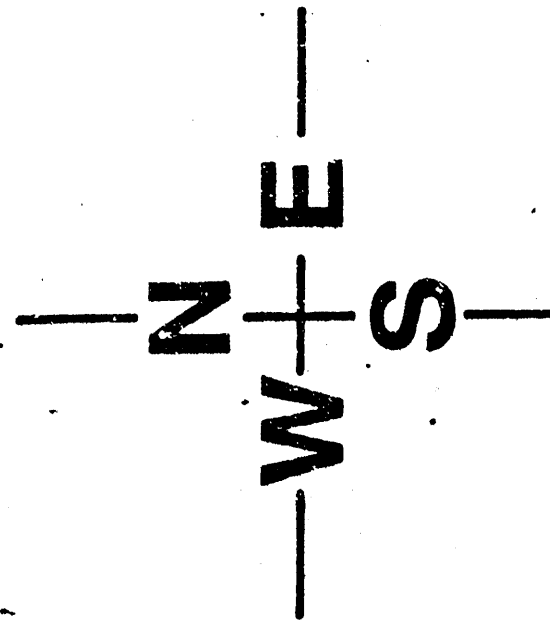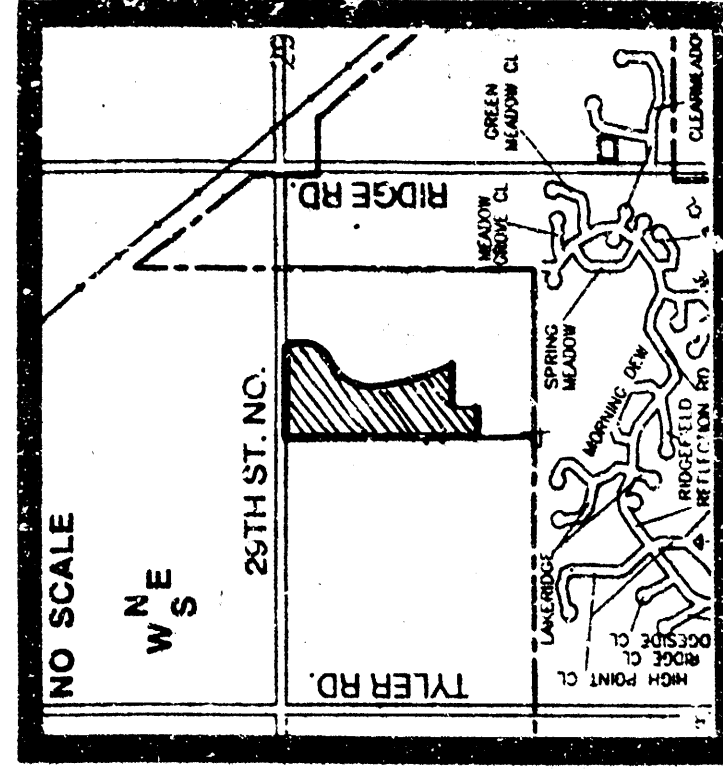

SCALE: 1" = 100'  
CONTOUR INTERVAL = 2'

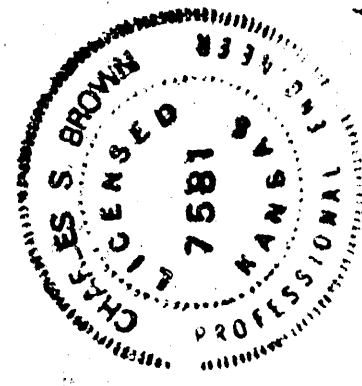

|                                                                            |          |         |             |
|----------------------------------------------------------------------------|----------|---------|-------------|
| PROFESSIONAL ENGINEERING CONSULTANTS, P.A.<br>ENGINEERS<br>WICHITA, KANSAS |          |         |             |
| Designed by                                                                | C. S. B. | Job No. | Sht. 1 of 1 |
| Drawn by                                                                   |          | Date    | 1-17-92     |

# REFLECTION RIDGE 8TH ADD.

OWNER: REFLECTION RIDGE INC., 7926 W. 21ST STREET NORTH, WICHITA, KANSAS 67212 PH: 316-721-2153



BILL G. YUNG DESIGN  
4612 E. 20TH STREET NORTH  
WICHITA, KS 67220  
316-653-5567

DATE  
REV.

SHEET TITLE  
PRELIMINARY PLAT

PROJECT  
REFLECTION RIDGE 8TH ADDITION

SHEET  
OF