


REPROCO 2ND ADDITION
(Drainage)

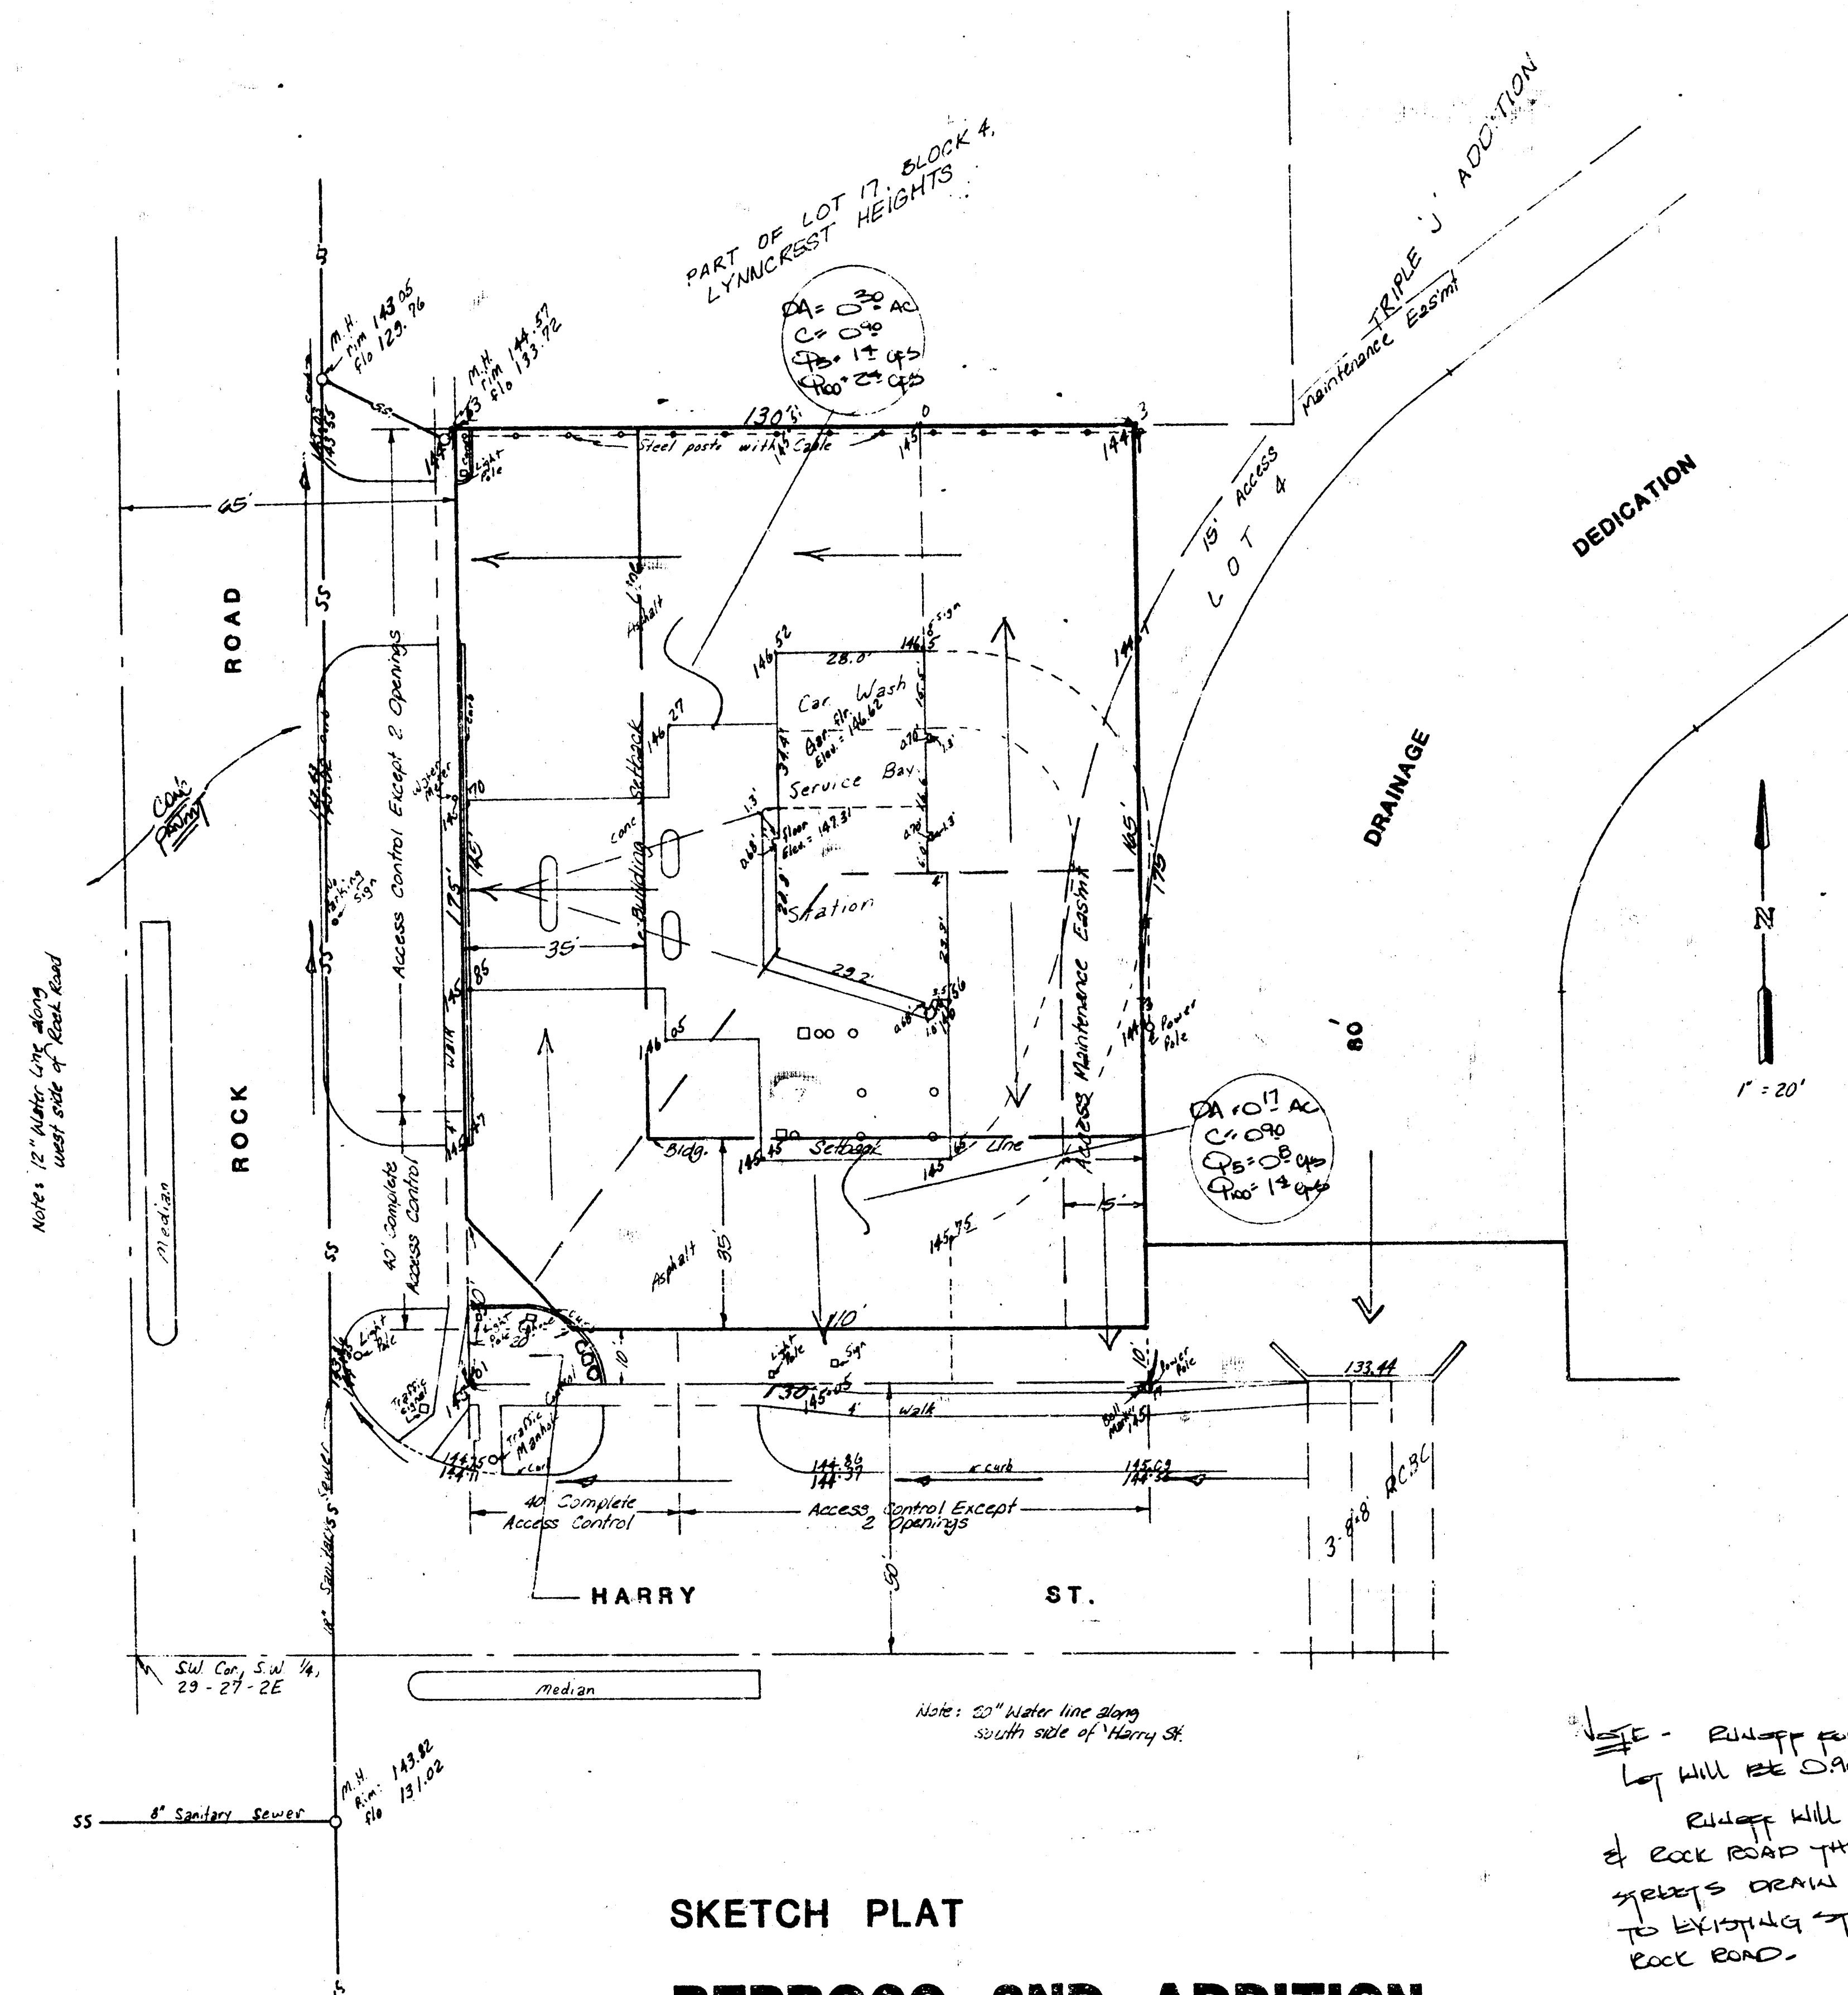

SKETCH PLAT

REPROCO 2ND ADDITION

Part of Lot 17, Block 4, Lyncrest Heights
Addition, Wichita, Kansas.

OWNER: REPROCO INC.
A DELAWARE CORPORATION.

FINAL DRAINAGE PLAN *chld.*

& Rock Road then drains. The
streets drain into and north
to existing storm sewers in
Rock Road.

4/20/84
BAUGHMAN COMPANY, P.A.
SURVEYING & ENGINEERING
316/262-7271 • 320 LAURA • WICHITA, KANSAS 67201